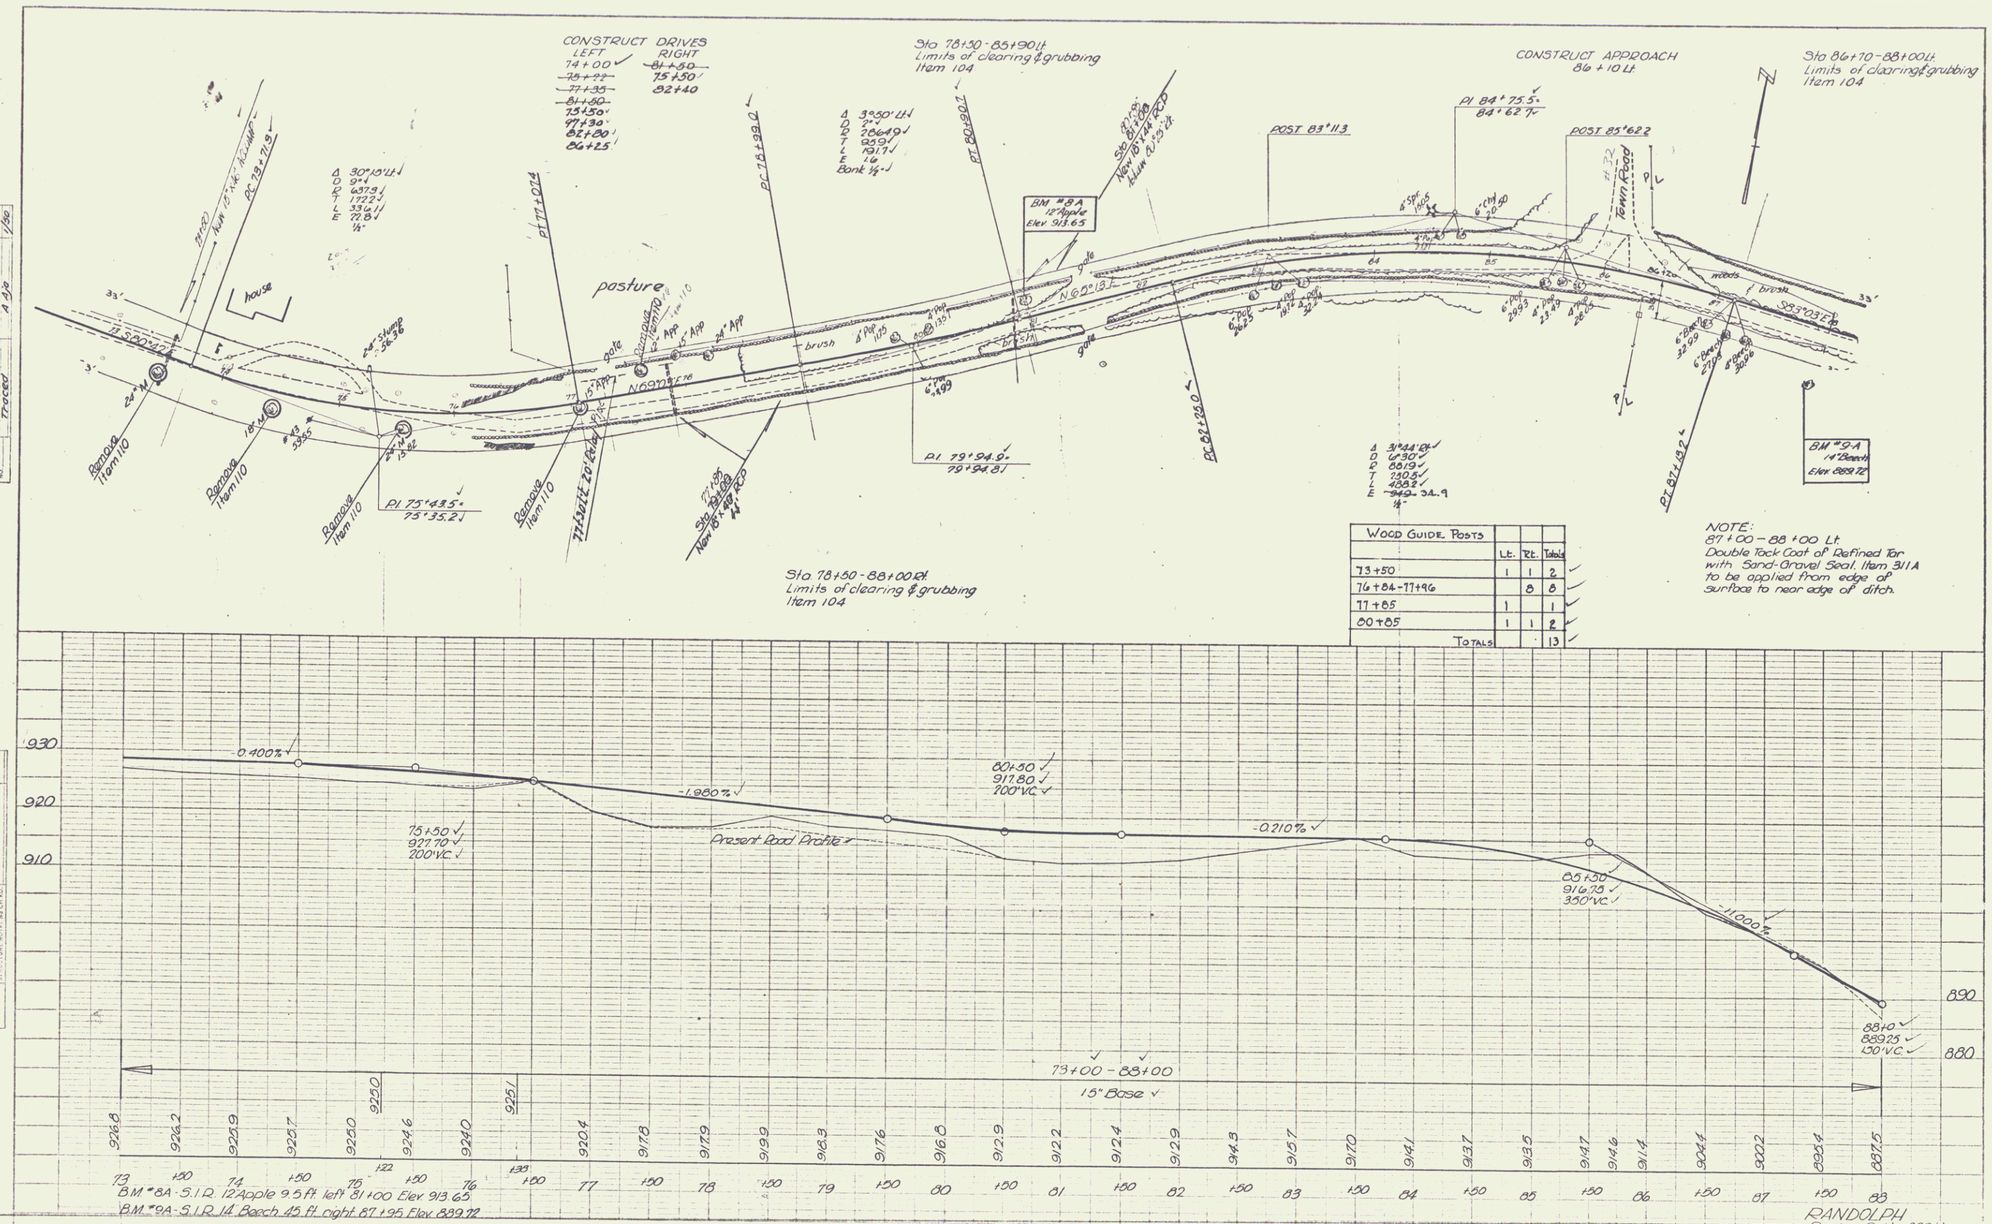

Wood Guide Posts	Lt.	Rt.	Totals
73+50	1	1	2
76+84-77+96		8	8
77+85	1		1
80+85	1	1	2
Totals			13

RANDOLPH
Series S. No. 229(1)
Sheet 17 of 69

7