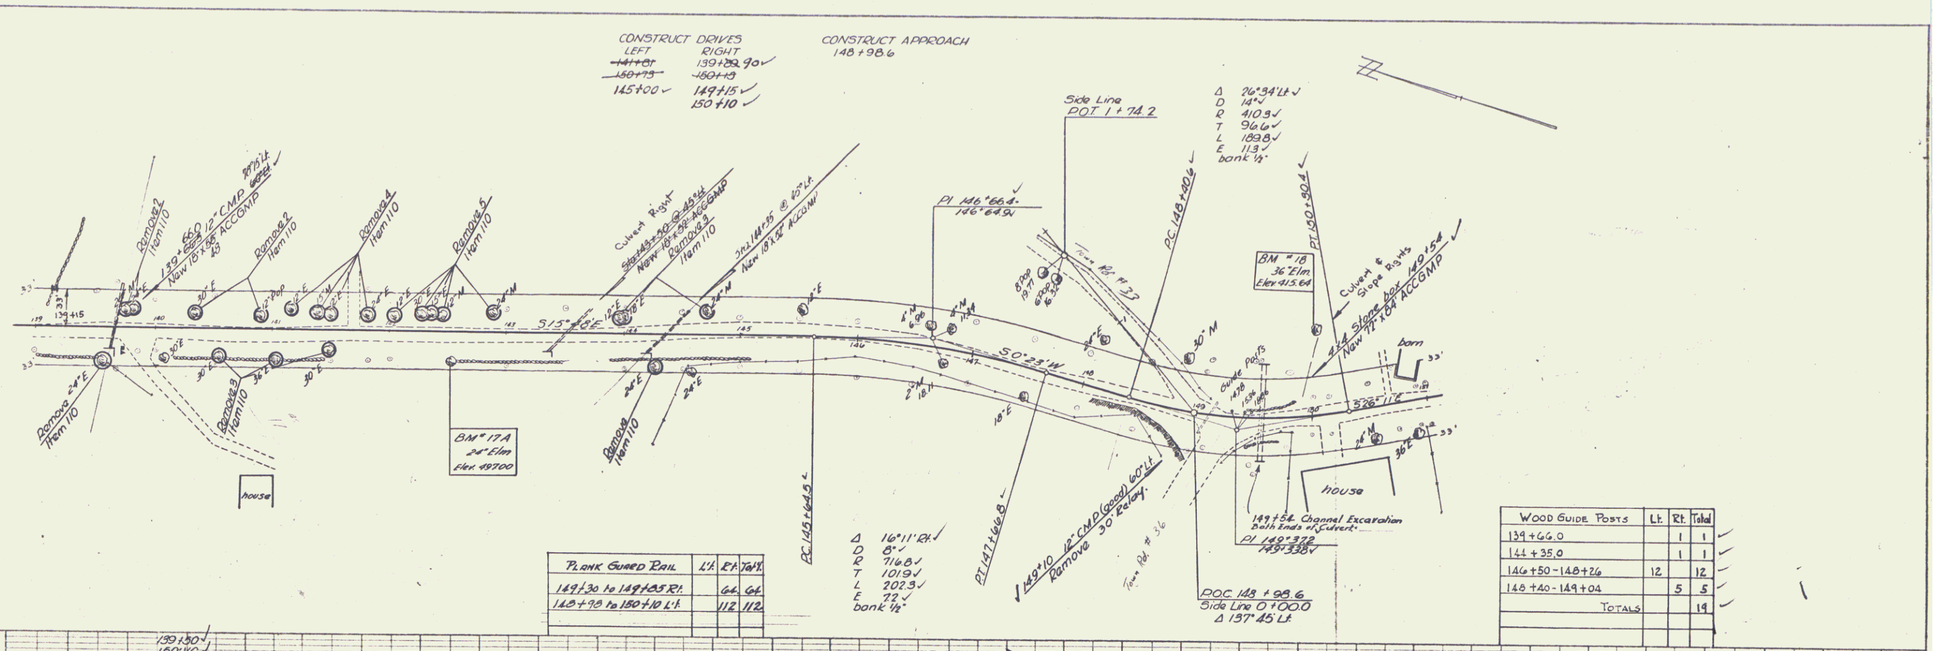

Plank Guard Rail	Lt.	Rt.	Total
149+30 to 149+85 Rt.		66	66
148+98 to 150+10 Lt.		112	112

Wood Guide Posts	Lt.	Rt.	Total
139+66.0		1	1
141+35.0		1	1
146+50 - 148+26	12		12
148+40 - 149+04		5	5
Totals			19

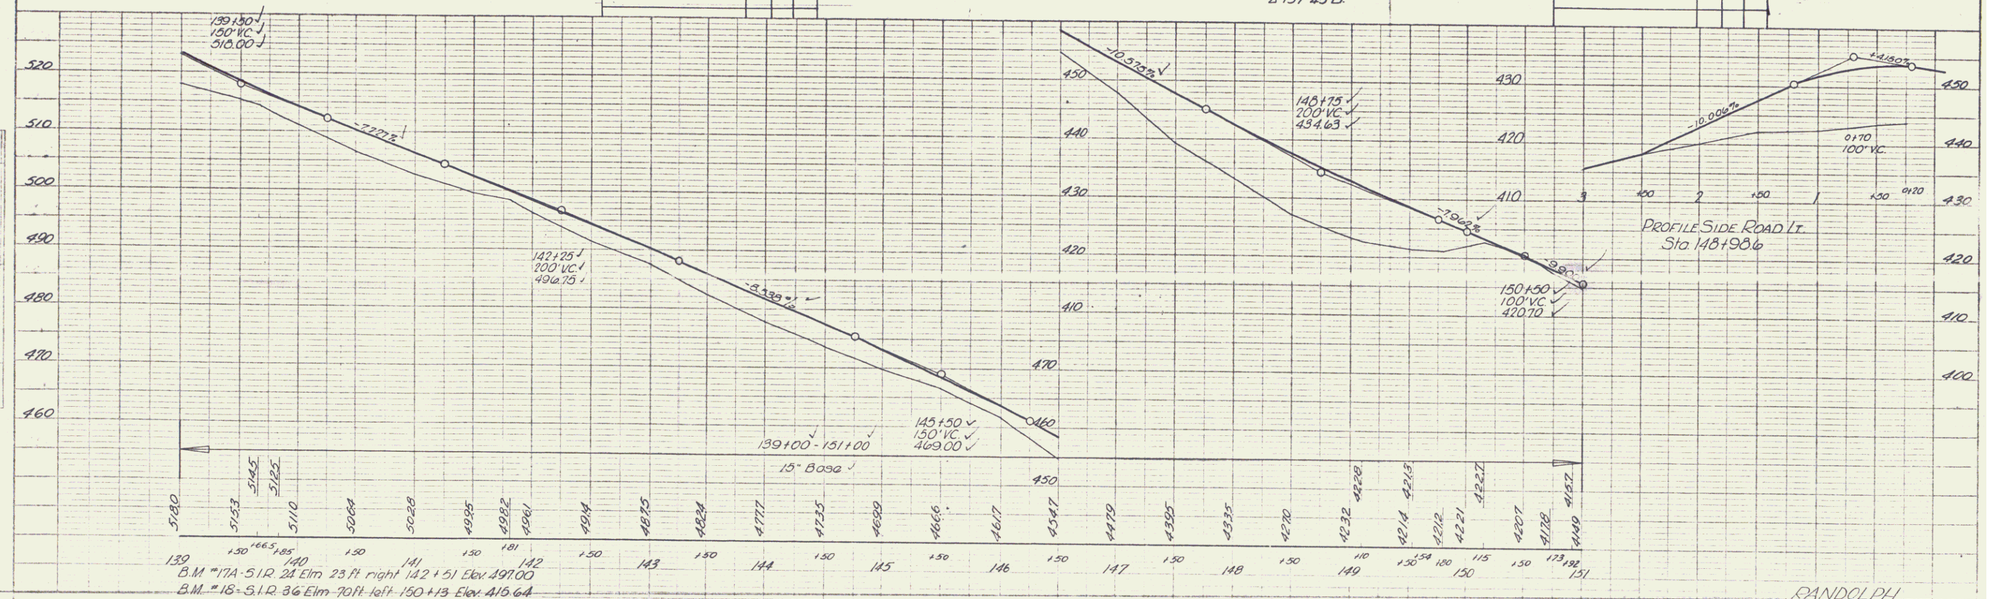

RANDOLPH
Series S No 229(1)
Sheet 22 of 69

12