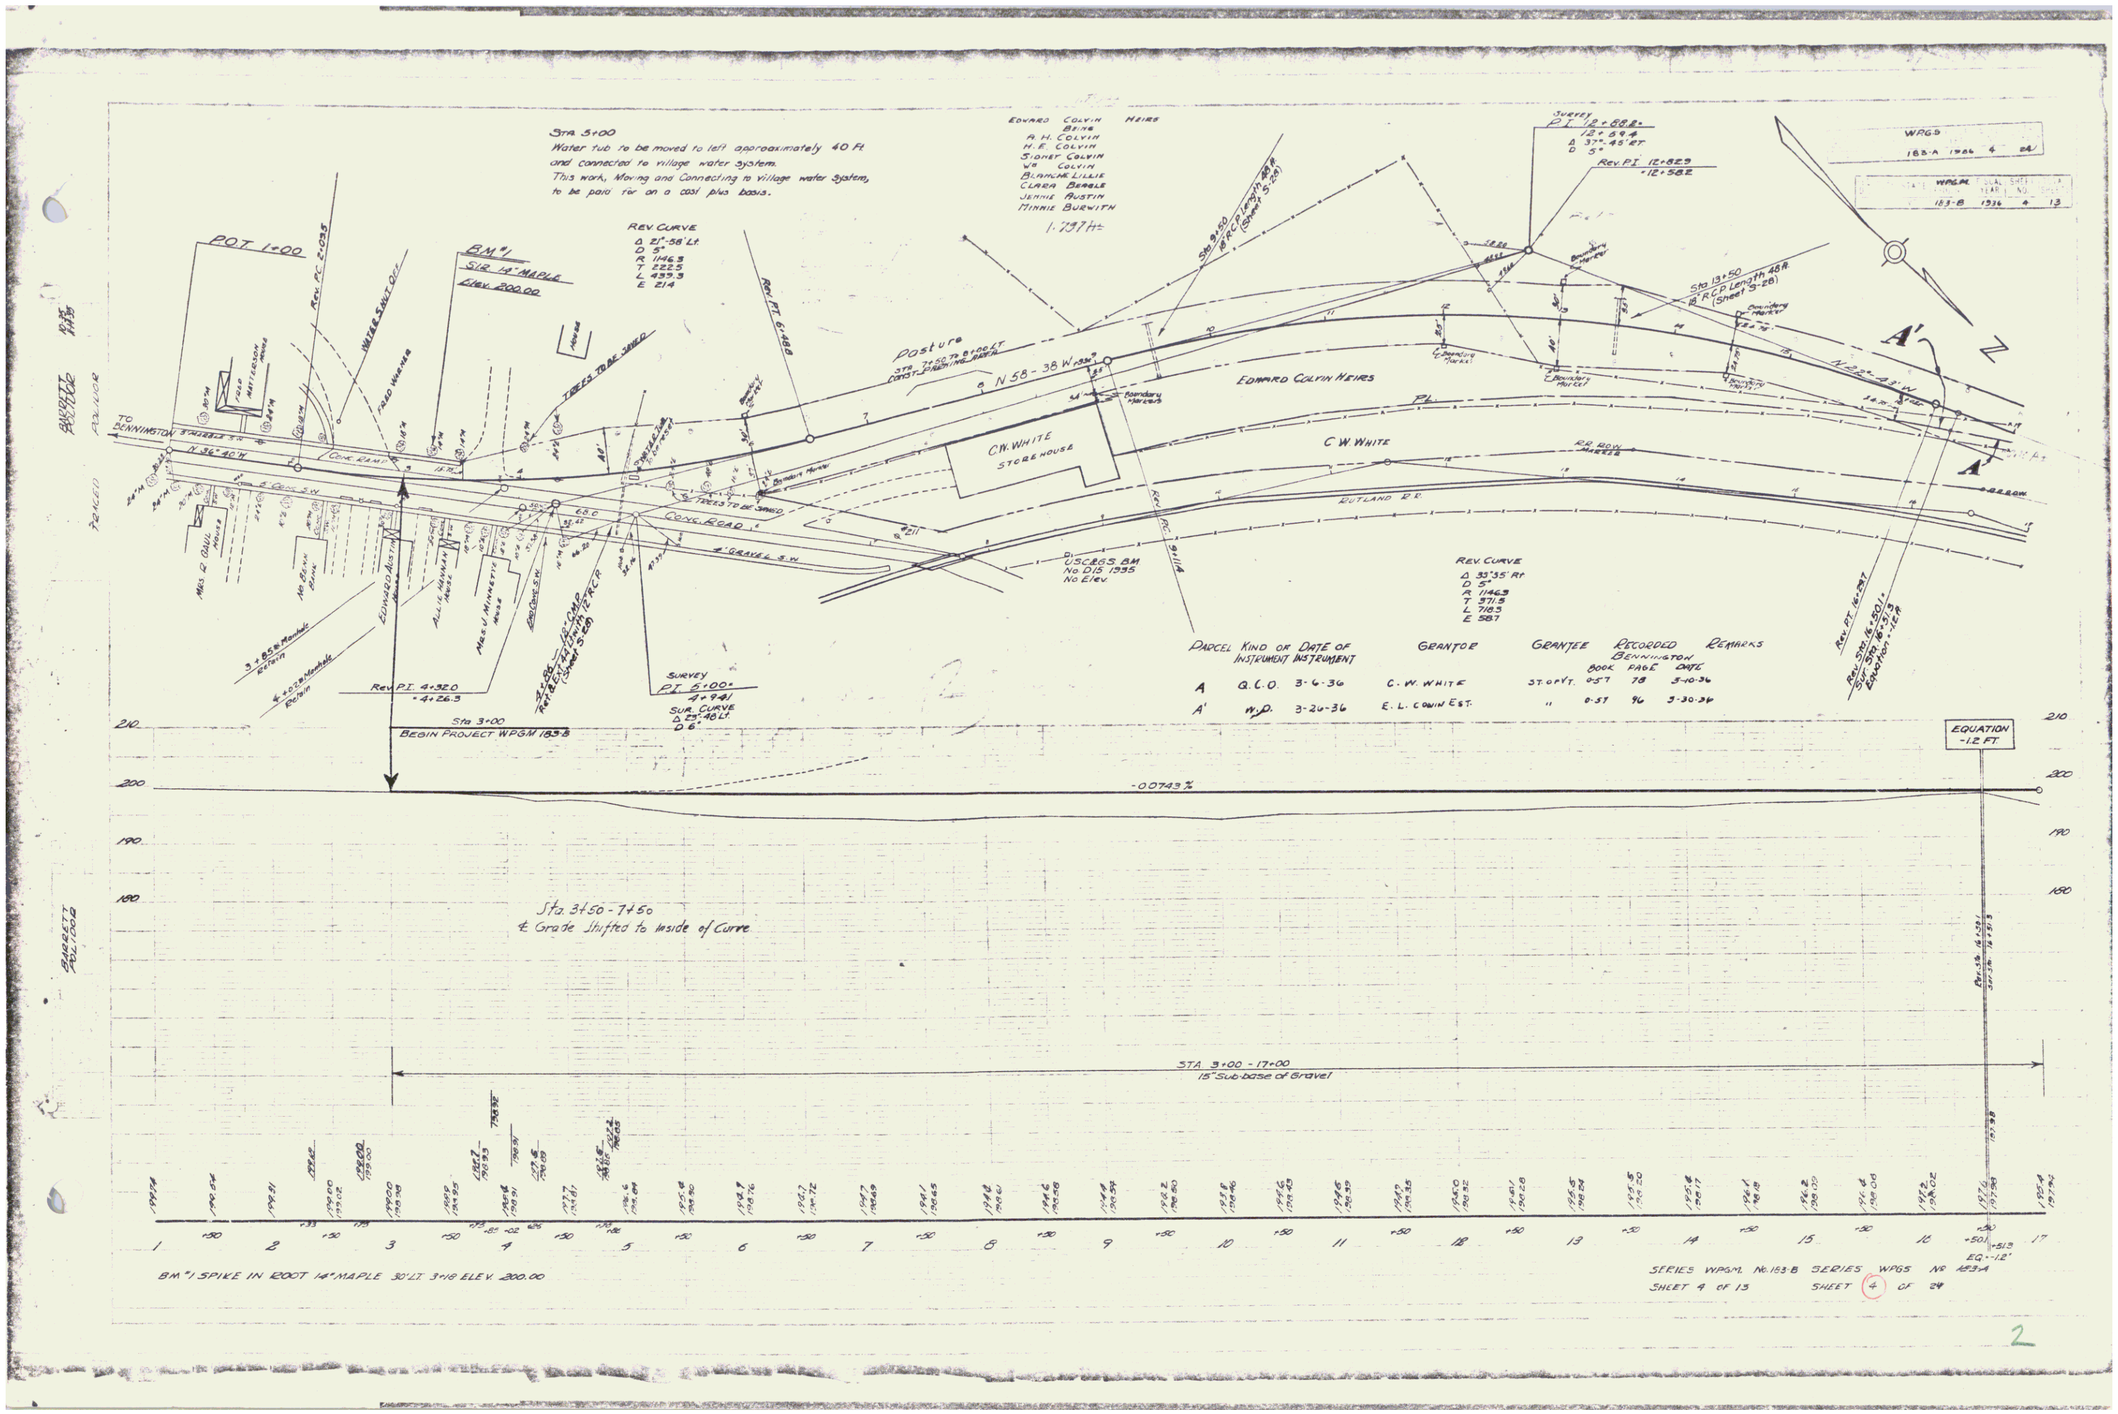
Sta. 5+00
Water tub to be moved to left approximately 40 Ft and connected to village water system.
This work, Moving and Connecting to village water system, to be paid for on a cost plus basis.
Edward Colvin Heirs
Blaine
A. H. Colvin
H. E. Colvin
Sidney Colvin
Wm Colvin
Blanche Lillie
Clara Beagle
Jennie Austin
Minnie Burwith
1.737 Ac
POT 1+00
BM #1
Sur. 14" Maple
Elev. 200.00
Water Shut Off
Trees to be Saved
Pasture
N 58 - 38 W
Edward Colvin Heirs
C.W. White
Store House
C.W. White
Rutland R.R.
Cont. Road
Cont. Ramp
N 36 - 40 W
To Bennington
Edward Austin
Boundary Marks
Boundary Marks
Boundary Marks
Boundary Marks
Boundary Marks
Boundary Marks
Boundary Marks
Boundary Marks
Rev. P.C. 2+035
Rev. P.T. 6+488
Rev. P.C. 9+114
Rev. P.T. 16+297
Rev. Sta. 16+50 for Sur. Sta. 16+13 Equation -.12 ft
Survey P.T. 12+88.8
12+88.8
Δ 37° 45' RT
D 5°
Rev. P.T. 12+82.9
+12+58.2
Sta. 13+50 18" R.C.P. Length 48 ft. (Sheet 5-28)
Sta. 8+50 18" R.C.P. Length 48 ft. (Sheet 5-28)
Rev. Curve
Δ 21° 58' Lt.
D 5°
R 1146.3
T 222.5
L 439.3
E 21.4
Rev. Curve
Δ 33° 35' Rt.
D 5°
R 1146.3
T 371.5
L 710.3
E 58.7
U.S.C.&G.S. BM
No. D15 1935
No. Elev.
Survey P.T. 5+00
4+94.1
Sur. Curve
Δ 25° 46' Lt.
D 6°
Rev. P.T. 4+32.0
4+26.3
Sta 3+00
Begin Project WPGM 183-B
-.00743%
Equation -.12 Ft.
Sta. 3+50 - 7+50
℄ Grade Shifted to Inside of Curve
STA 3+00 - 17+00
15" Sub-base of Gravel
A
A'
N
WRGD
183-A 1936 4 24
WPGM
183-B 1936 4 13
Parcel Kind of Instrument Date Grantor Grantee Recorded Bennington Book Page Date Remarks
A Q.C.D. 3-6-36 C. W. White St. of Vt. 057 18 3-10-36
A' W.D. 3-26-36 E. L. Colvin Est. " 057 96 3-30-36
BM #1 Spike in root 14" Maple 30' Lt. 3+18 Elev. 200.00
Series WPGM No. 183-B Series WPGS No 183-A
Sheet 4 of 13 Sheet 4 of 24
2