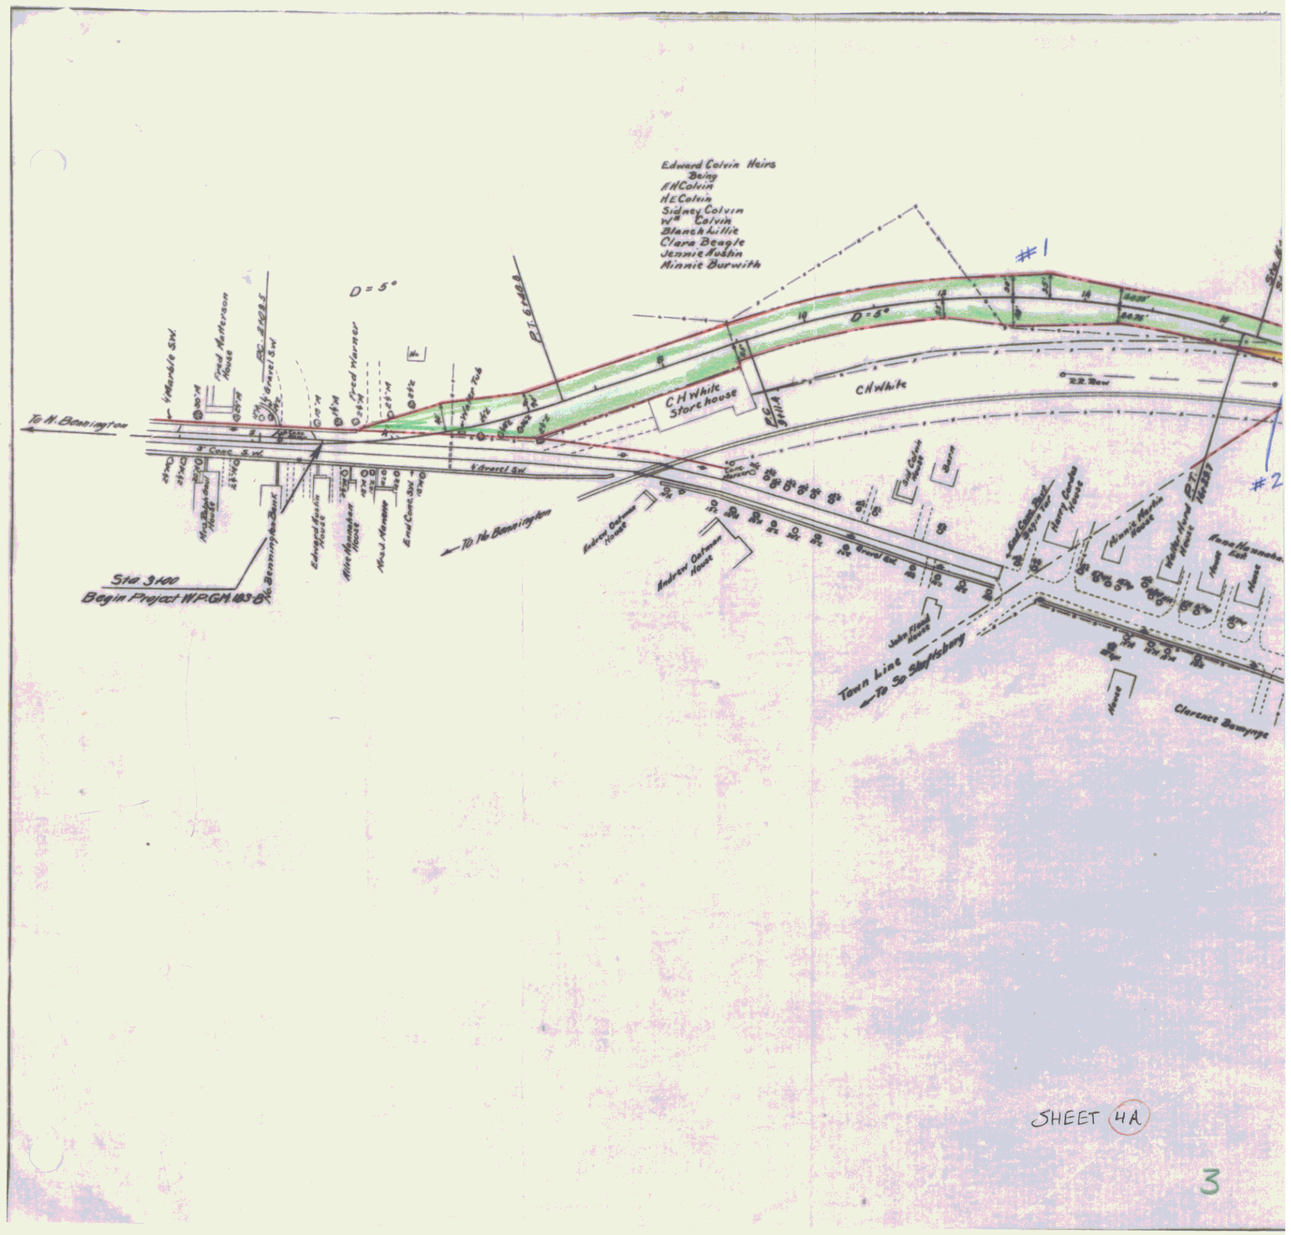
Edward Colvin Heirs
Being
F.H. Colvin
H.E. Colvin
Sidney Colvin
Wm Colvin
Blanch Lillie
Clara Beagle
Jennie Fuller
Minnie Burwith
D = 5°
#1
#2
C.H. White
C.H. White Store house
To N. Bennington
To No. Bennington
Sta 3+00
Begin Project W.P.G.M. 103
Town Line
To So. Shaftsbury
Clarence Bemyre
SHEET 4A