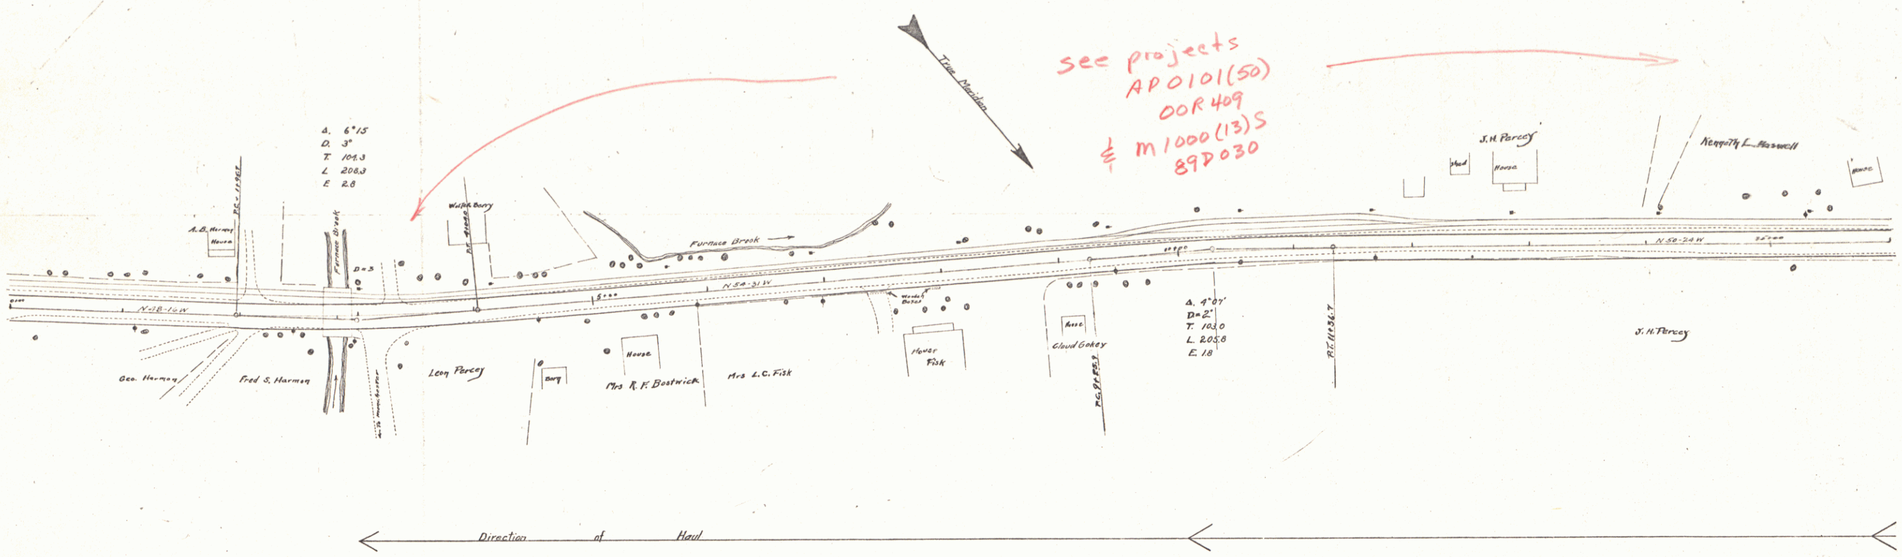

Direction of Haul

Bearings refer to true meridian

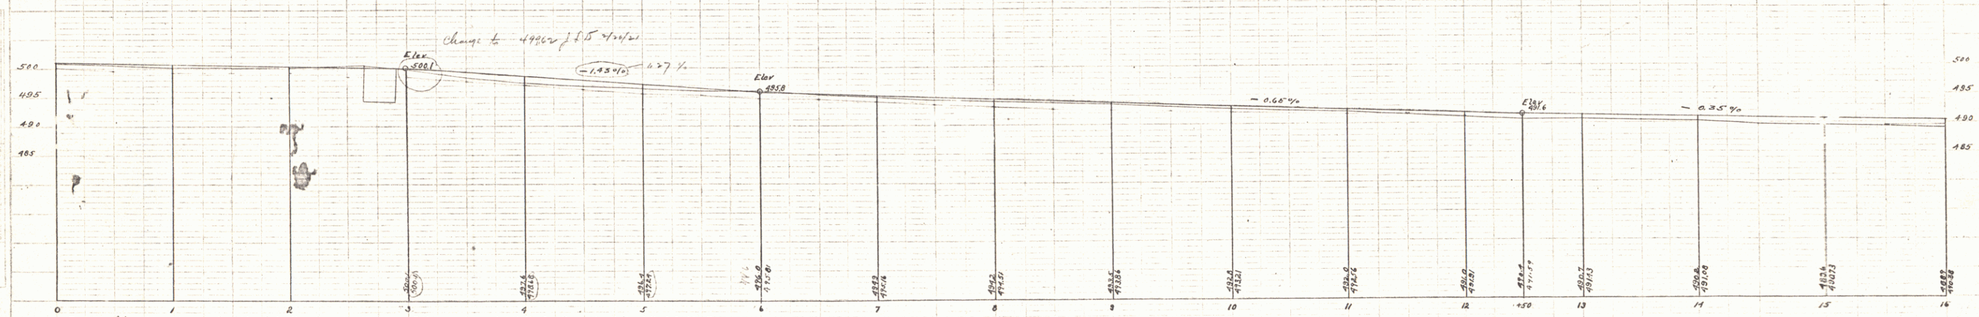

Red profile shows base of rail of trolley track

B.M. Concrete guard at lt side of railing post on bridge left of 2+93. Elev 500.00

B.M. Spike in willow 36' left of Sta. 10+19. Elev 492.26

B.M. Spike in elm 18' right of Sta. 15+17. Elev 489.59

Note: All Crown Elevations to be Lowered 0.08 ft.

Series V-5
Sheet 2 of 26 MSB+M 2

2