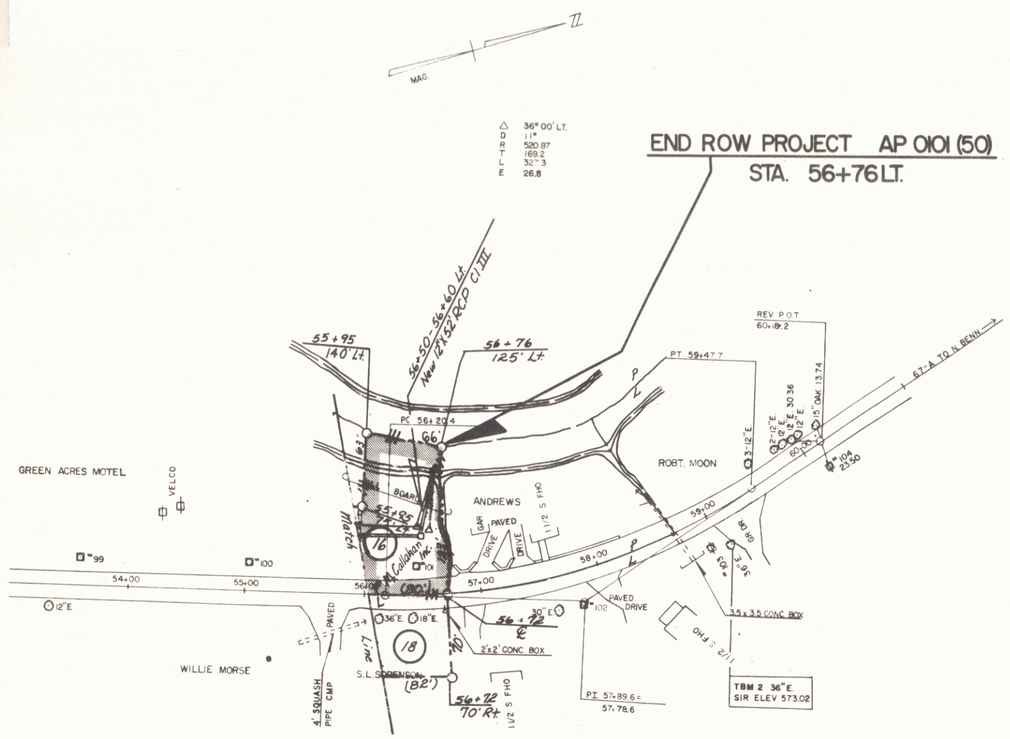

SURVEYED BY _____ DATE _____
DRAWN BY _____ DATE _____
TRACED BY S. SANDS DATE 8/20/69

BENNINGTON RTE. 67-A

PROJ. AP NO. 0101 (50)

SHEET 15 OF 19

D-7

5