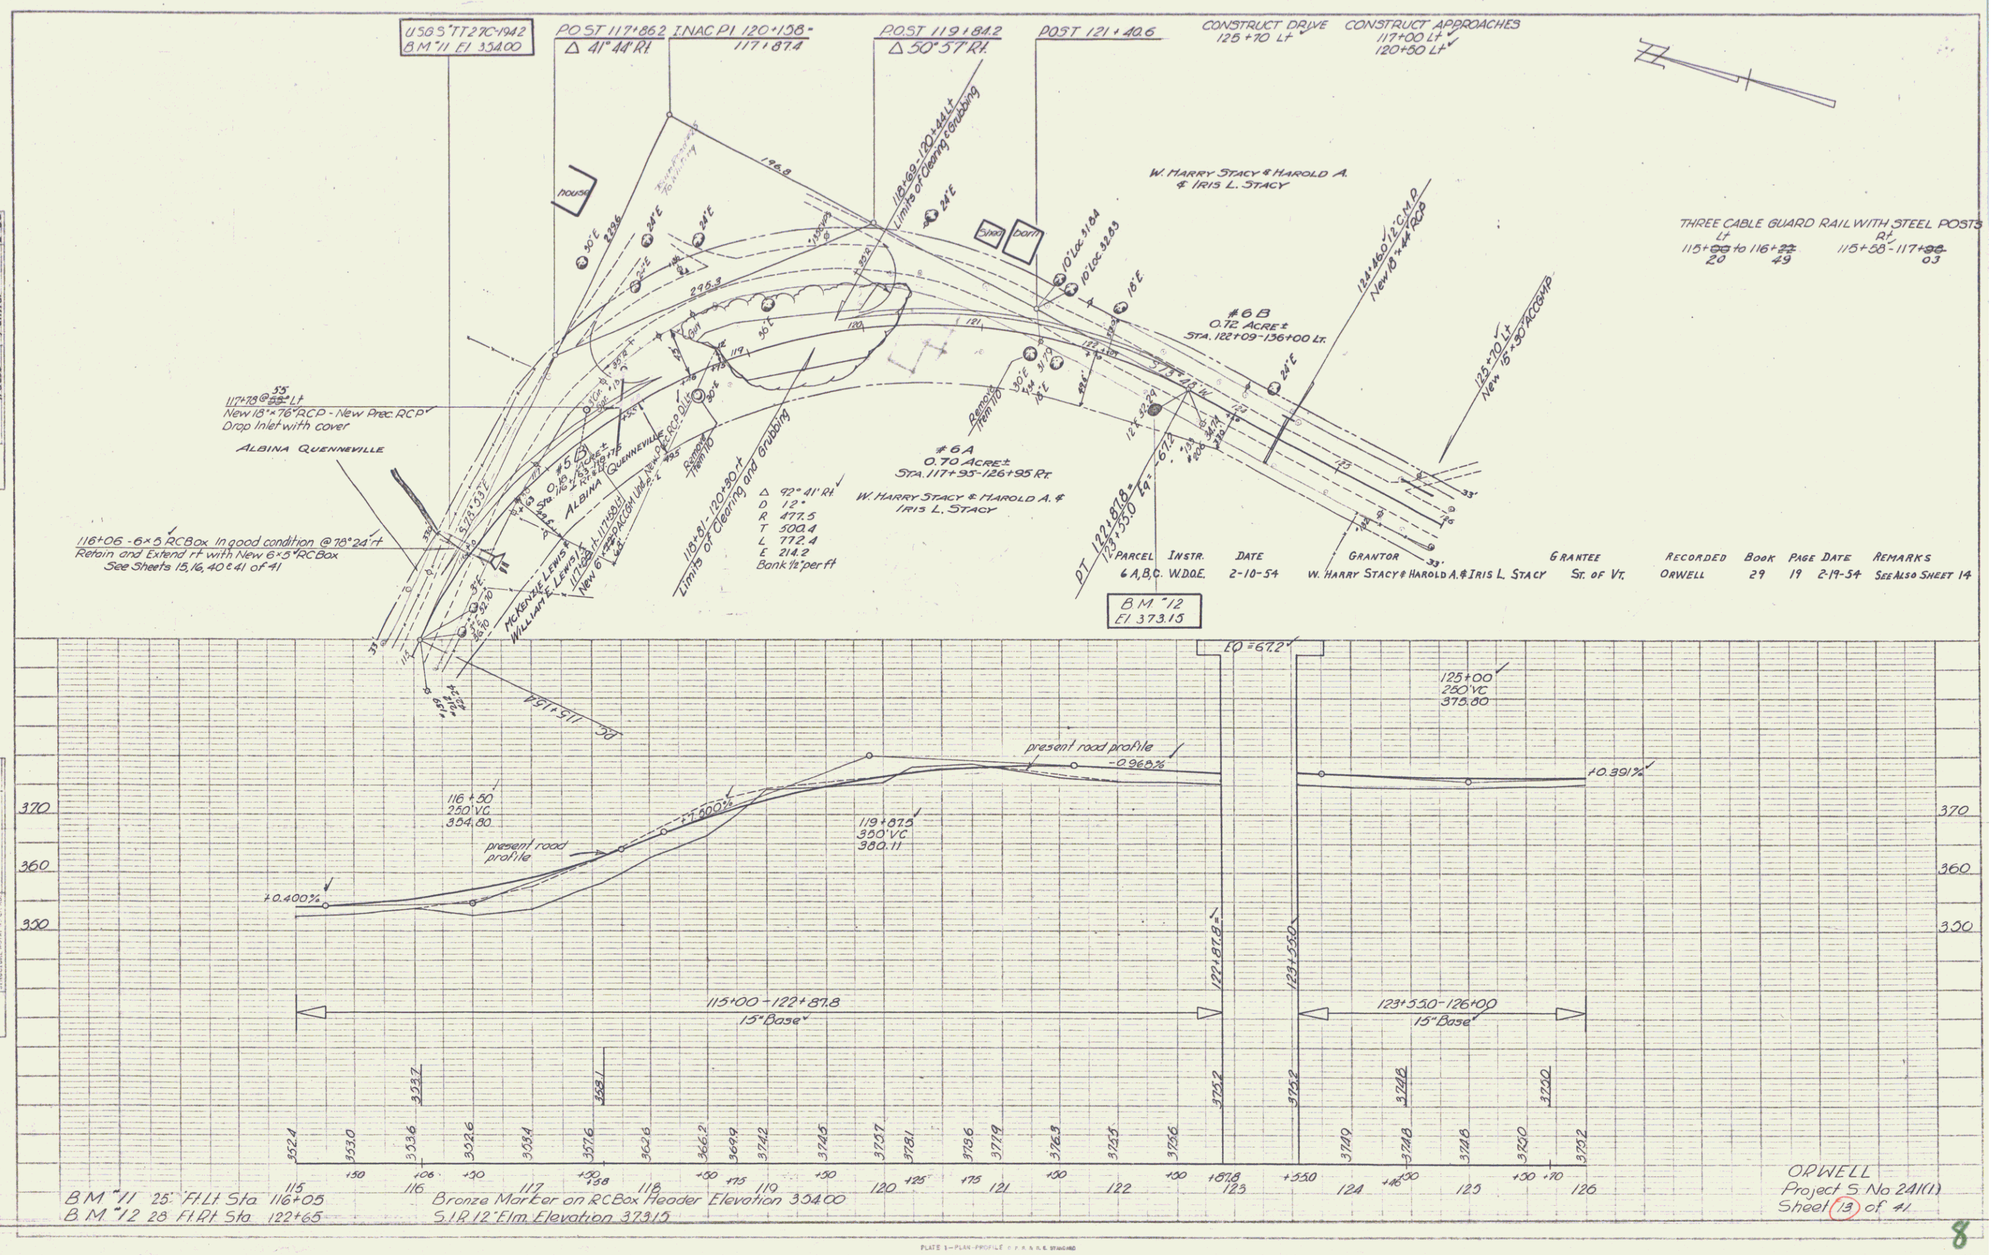

Parcel	Instr.	Date	Grantor	Grantee	Recorded	Book	Page	Date	Remarks
6 A, B, C.	W.D.O.E.	2-10-54	W. Harry Stacy & Harold A. & Iris L. Stacy	St. of Vt.	Orwell	29	19	2-19-54	See Also Sheet 14

PLAN	
Computed	A. Levin
Plotted	Palmer
Checked	Palmer
Date	12-31 2-52
Scale	1" = 20'

PROFILE	
Computed	A. Levin
Plotted	Palmer
Checked	Palmer
Date	12-31 2-52
Scale	1" = 20'

PLATE 3—PLAN-PROFILE C.P.R.R.R. STANDARD
KEUFFEL & ESSER CO. NEW YORK.
K & E Co. No. 346-12 SERIES

8