TWO CABLE GUARD RAIL, ITEM 542
Lt.
~~63+00 - 64+26~~
~~70+00 - 77+00~~
~~68+76 - 72+76~~
63+00 - 72+35
74+05 - 74+70
75+55 - 77+00
Rt
63+45 - 64+45
73+30 - 75+35

WOOD GUIDE POSTS, ITEM 548-A
Lt.
~~63+21 - 64+06~~
Rt.
~~75+50~~
77+00
77+75

CONSTRUCT DRIVE

REMOVAL & DISPOSAL OF PRESENT GUARD RAIL
Lt.
65+75 - 72+00

⊙ Indicates "Cutting & Removing Trees", Item 110

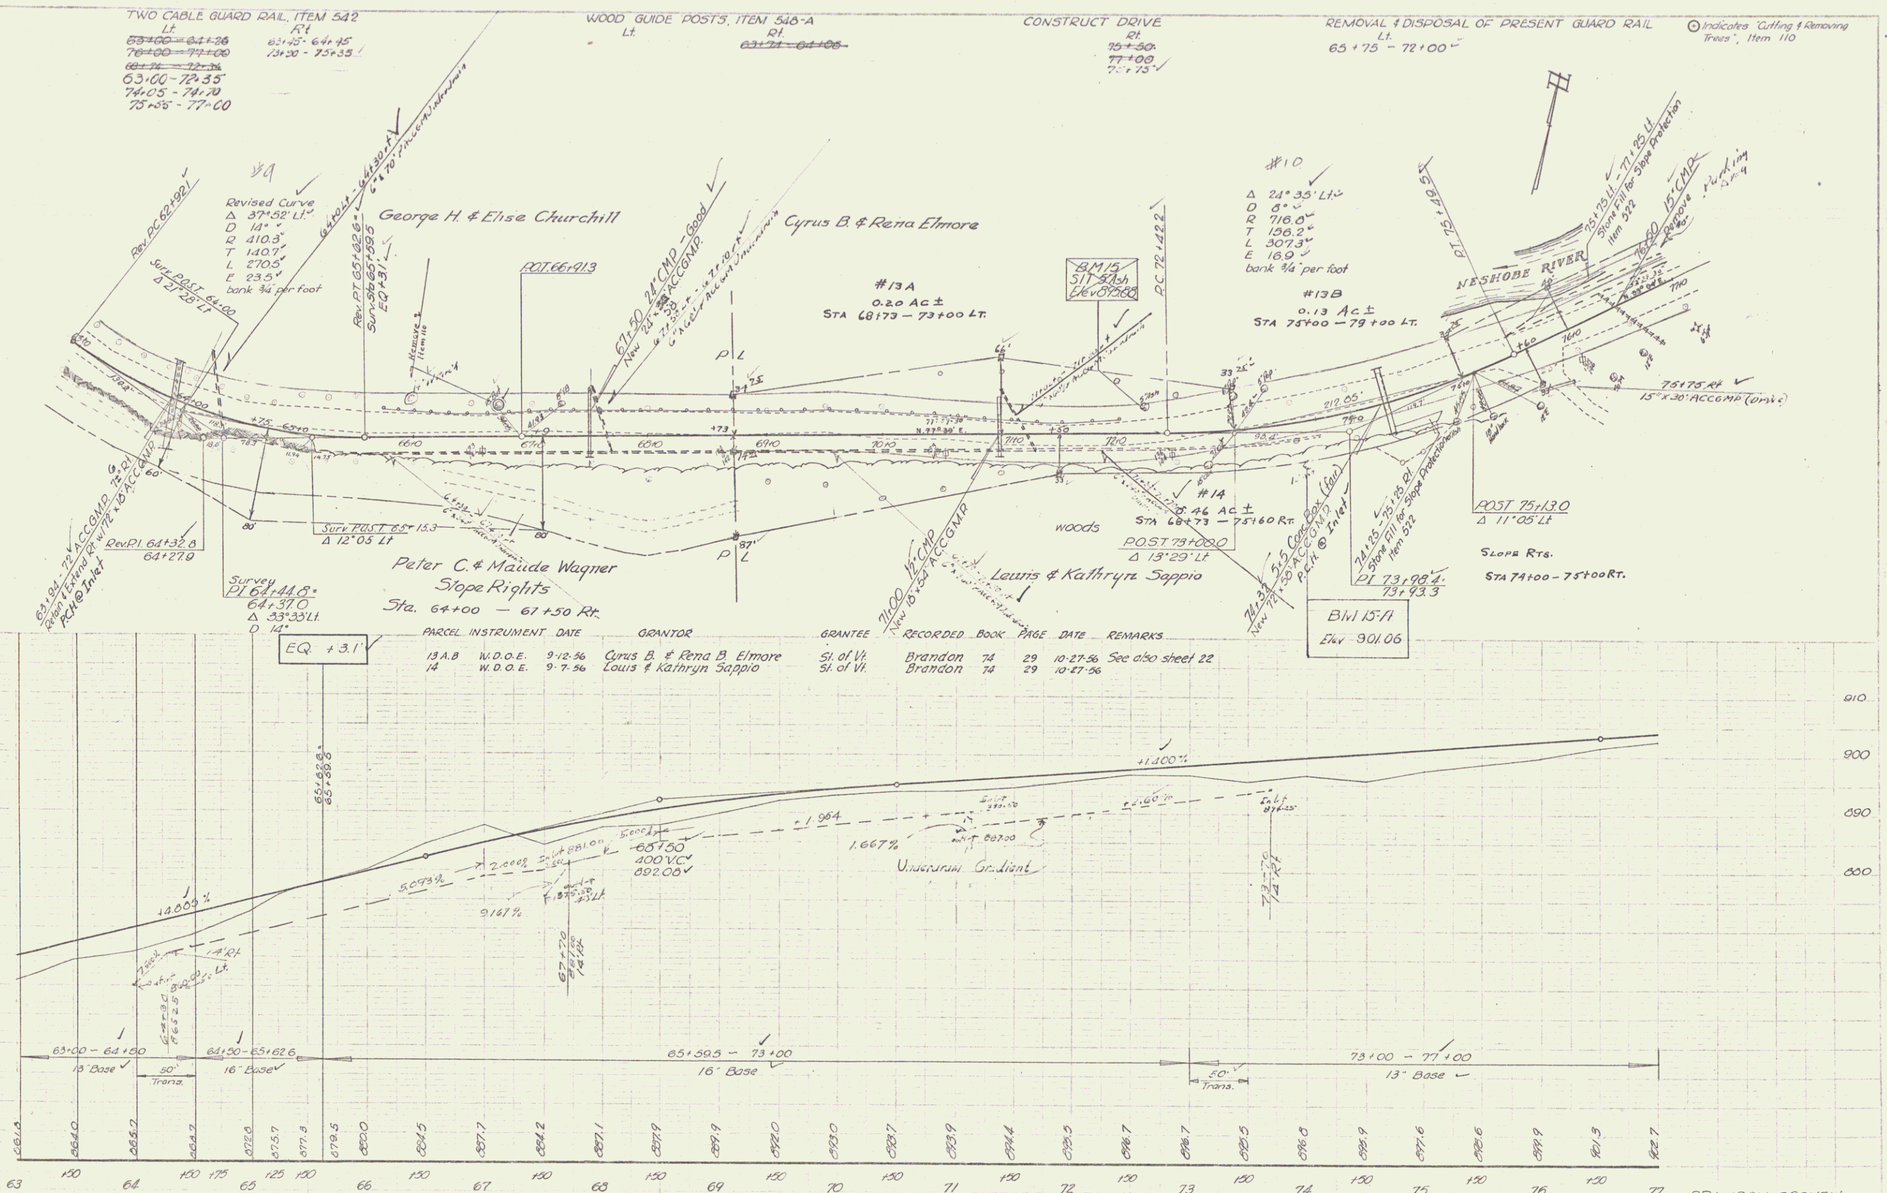

PARCEL	INSTRUMENT	DATE	GRANTOR	GRANTEE	RECORDED	BOOK	PAGE	DATE	REMARKS
13A,B	W.D.O.E.	9-12-56	Cyrus B. & Rena B. Elmore	St. of Vt.	Brandon	74	29	10-27-56	See also sheet 22
14	W.D.O.E.	9-7-56	Louis & Kathryn Sappio	St. of Vt.	Brandon	74	29	10-27-56	

~~BM 15 SIR Sash 22.41 Sta 72+27 Hor 895.88~~ BM 15A SIR 12" Ash Elev 901.06 24' Rt Sta 72+58

BRANDON-GOSHEN
Project SX N 9191 (N)
Sheet 21 of 47

6