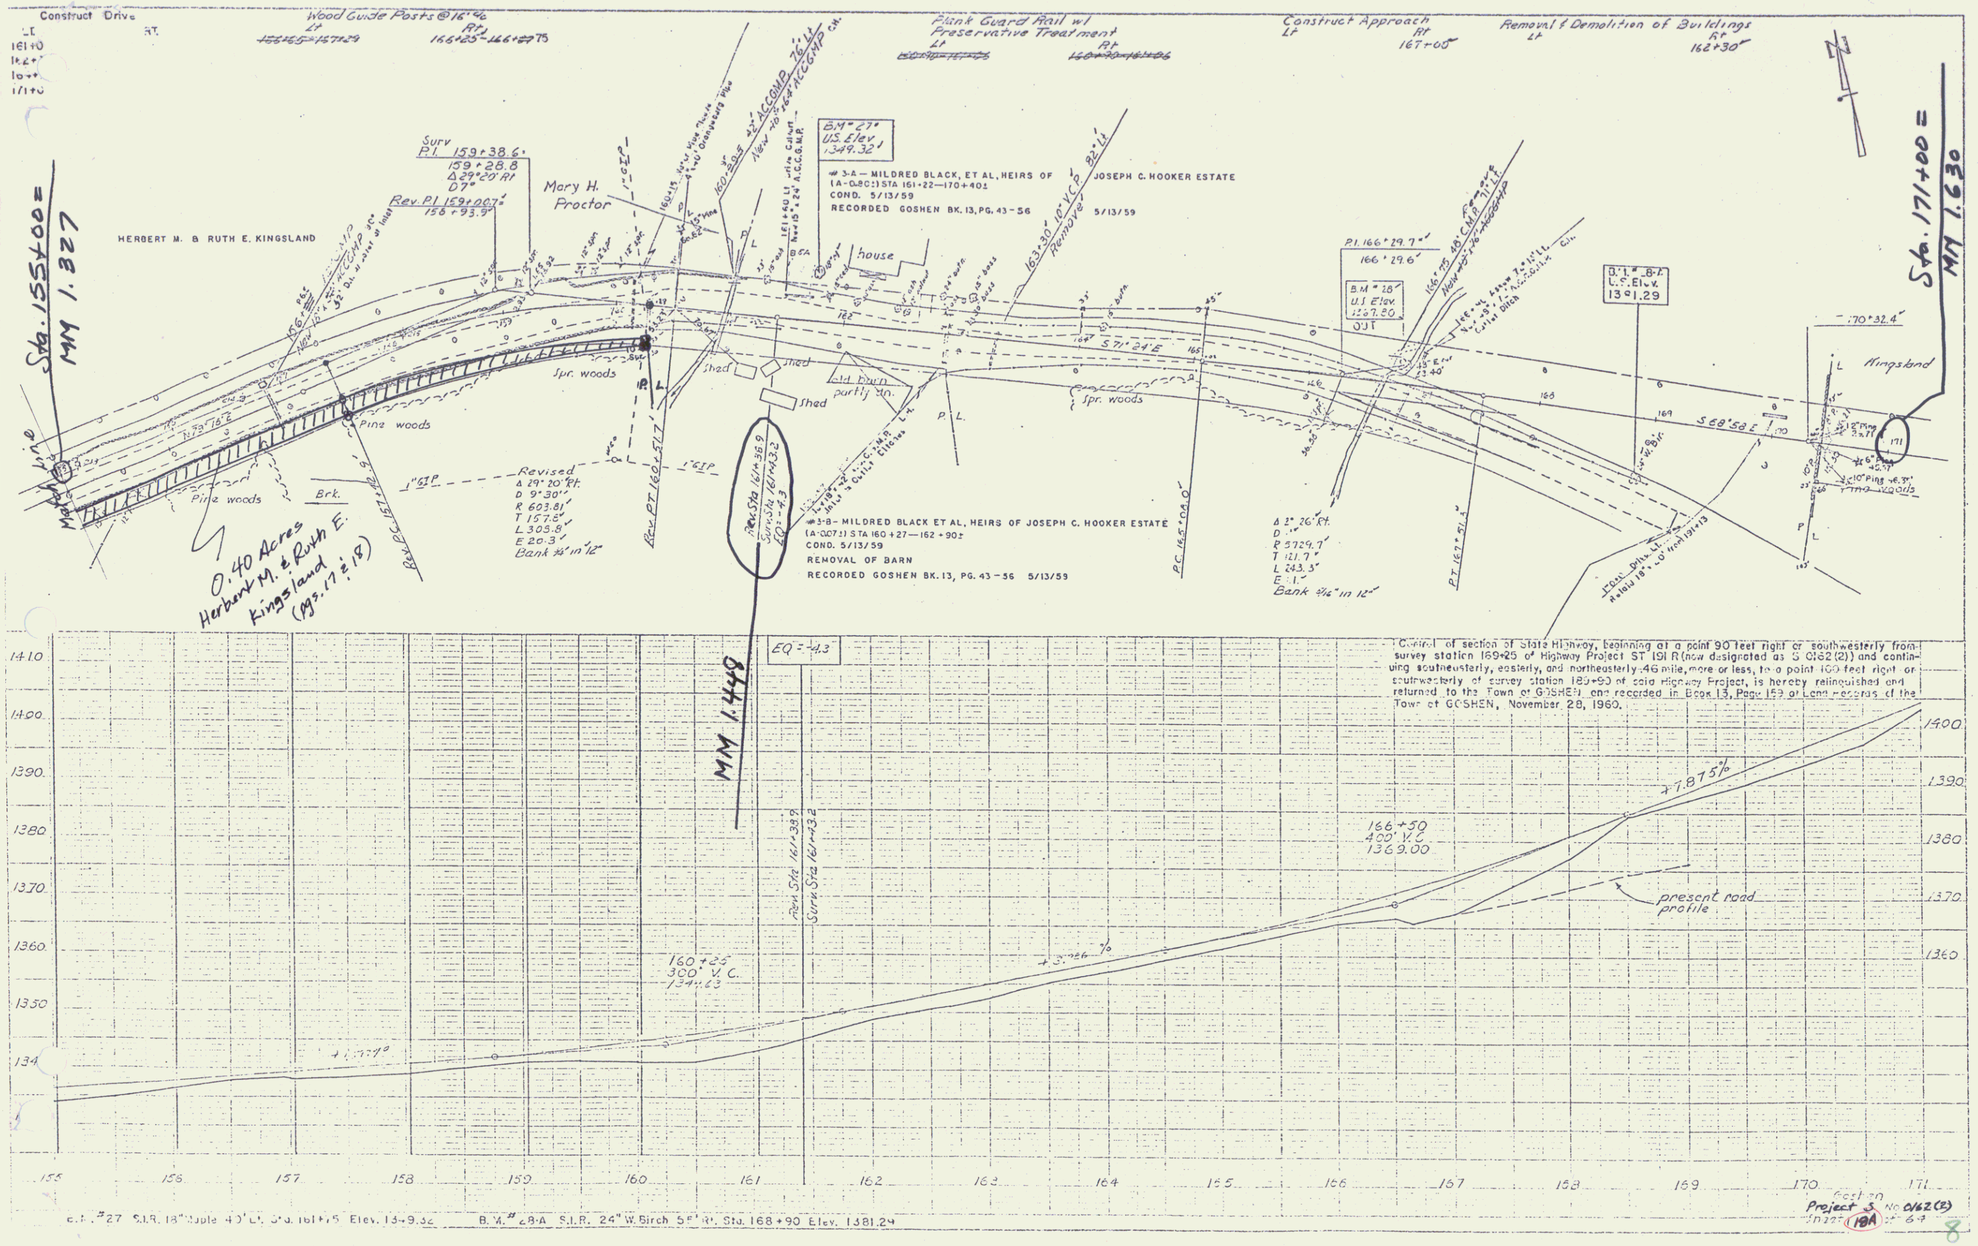

Project S No. 0162(2)