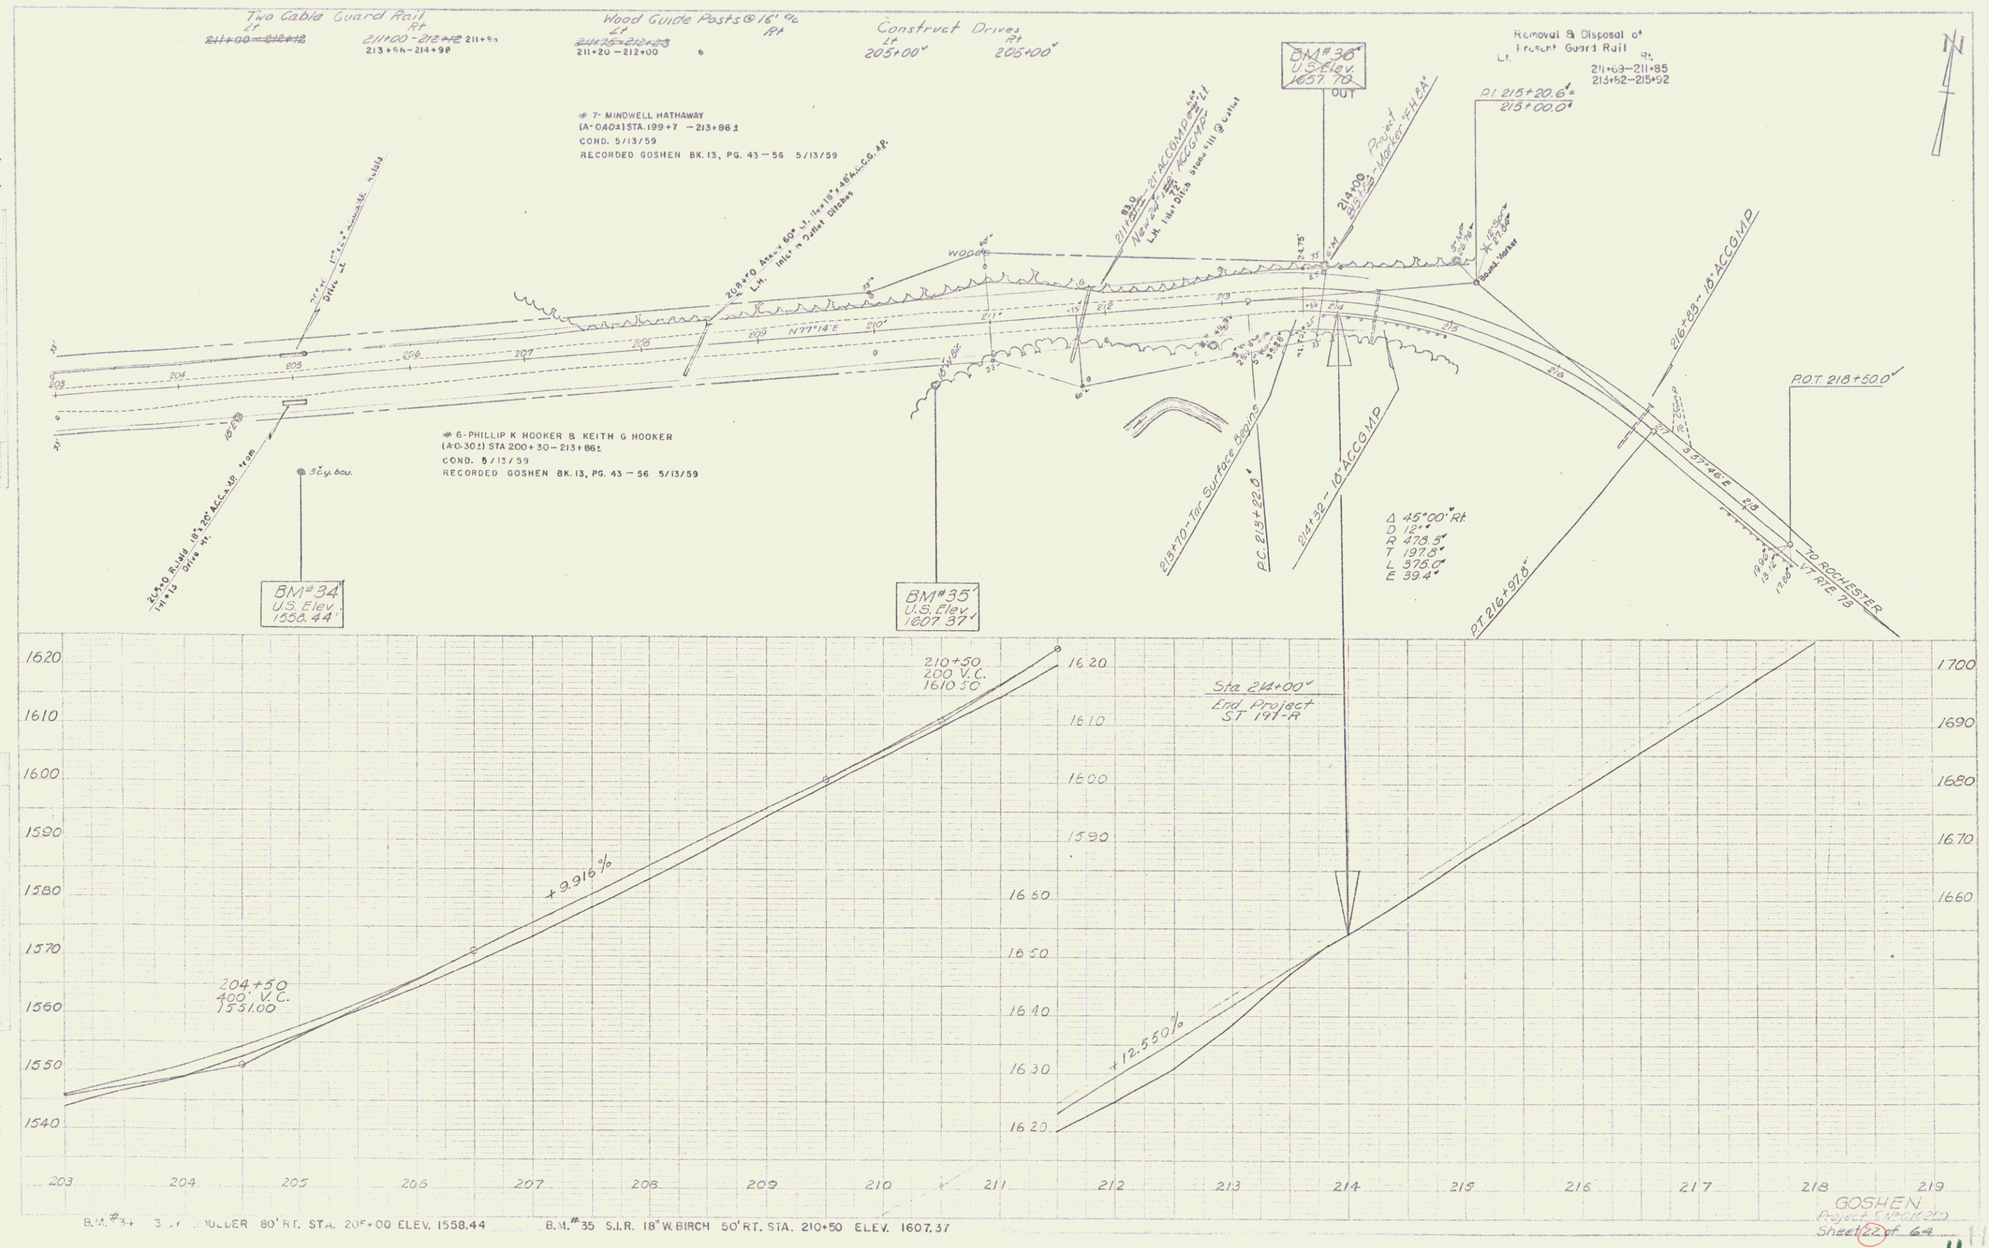
Two Cable Guard Rail
Lt. Rt.
211+00 - 212+12 211+63
213+64 - 214+98
Wood Guide Posts @ 16' o/c
Lt. Rt.
211+20 - 212+00
Construct Drives
Lt. Rt.
205+00' 205+00'
Removal & Disposal of Frontal Guard Rail
Lt. Rt.
211+63 - 211+85
213+62 - 215+92
BM #36
U.S. Elev.
1657.70
OUT
P.I. 215+20.6' = 215+00.0'
7- MINDWELL HATHAWAY
(A-040±) STA. 199+7 - 213+86±
COND. 5/13/59
RECORDED GOSHEN BK. 13, PG. 43 - 56 5/13/59
6- PHILLIP K HOOKER & KEITH G HOOKER
(A-030±) STA 200+30 - 213+86±
COND. 5/13/59
RECORDED GOSHEN BK. 13, PG. 43 - 56 5/13/59
Project Marker
Board Marker
216+63 - 18" ACCGMP
ROT. 218+50.0'
TO ROCHESTER
RTE 79
BM #34
U.S. Elev.
1558.44'
BM #35
U.S. Elev.
1607.37'
P.C. 213+22.0'
214+32 - 18" ACCGMP
Δ 45°00' Rt
D 12°
R 479.3'
T 197.8'
L 575.0'
E 39.4'
PT 216+97.8'
Sta 214+00'
End Project
ST 197-A
210+50
200' V.C.
1610.50
204+50
400' V.C.
+9.916%
+12.550%
1620
1610
1600
1590
1580
1570
1560
1550
1540
16.20
16.10
16.00
15.90
16.60
16.50
16.40
16.30
16.20
1700
1690
1680
1670
1660
203
204
205
206
207
208
209
210
211
212
213
214
215
216
217
218
219
B.M. #35 S.I.R. 18" W. BIRCH 50' RT. STA. 210+50 ELEV. 1607.37
GOSHEN
Project S-Wall(20)
Sheet 22 of 64