INDEX OF SHEETS

SHEET Nº		
	1	TITLE SHEET
	2	TYPICAL CROSS-SECTION OF IMPROVEMENT (BITUMINOUS CONCRETE PAVEMENT, ITEM 361-D(MOD)
	3	QUANTITY SHEET (ITEMS)
	4	QUANTITY SHEET (DRAINAGE)
5 — 8		EARTHWORK SHEETS
9-20		PLAN AND PROFILE SHEETS
	21	STANDARD SHEET SB-PA #1 (DETAILS OF 12'-6"X7'-11" C.G.M.R.P.A. AT STA. 366+23.5, DETAIL "B")
	22	STANDARD SHEET SB-PA #2
	23	STANDARD SHEET SB-PP #1 (DETAILS OF 120° C.G.M. R.P. AT STA. 359+81.5, DETAIL "C")
	24	STANDARD SHEET SB-PP #2
	25	STANDARD SHEET B-1 (BANKING TABLES)
	26	STANDARD SHEET B-5 (SLOPE GRADING)
	27	STANDARD SHEET B-11 (SLOPE STABILIZATION)
	28	STANDARD SHEET C-1 (TREATED TIMBER CURB)
	29	STANDARD SHEET D-1 (PRECAST H.C.P. DROP INLET)
	30	STANDARD SHEET D-2 (HEADWALLS & UNDERDRAINS)
	31	STANDARD SHEET E-1 (BARRICADES, SIGNS & LIGHTS)
	32	STANDARD SHEET G-2a (TWO CABLE GUARD RAIL)
	33	STANDARD SHEET G-4 (GUIDE POSTS & MARKER POSTS)
	34	STANDARD SHEET J-1 (MARKERS)
35-57		CROSS-SECTION SHEETS
58-59		CURVE BANKING TRANSITION SHEETS

STATE OF VERMONT
DEPARTMENT OF HIGHWAYS

PROPOSED IMPROVEMENT

FEDERAL AID SECONDARY PROJECT

PROJECT	NUMBER
Goshen-Rochester	S-FLH 0162 (1)
TYPE	SURFACE AREA
Bituminous Concrete	37,526 sy

TOWNS OF GOSHEN & ROCHESTER

COUNTIES OF ADDISON & WINDSOR

VERMONT ROUTE #73

BRANDON – ROCHESTER ROAD

BEGINNING AT A POINT APPROXIMATELY 0.75 MILE WESTERLY OF THE GOSHEN - ROCHESTER TOWN LINE AND EXTENDING EASTERLY ~~2.933 MILES.~~ 3.198 MILES.

LENGTH OF PROJECT ~~15,486.6~~ 16,886.6 FEET ~~2.933~~ 3.198 MILES

1958 ADT -	125
1980 ADT -	180
1980 DHV -	35
D	65%
T	11%
V_a 30 MPH	(FROM 236+00 TO 275+75)
40 MPH	(FROM 275+75 TO 391+00)

RECORD PLANS MATERIALS
GRAVEL - Lyon and Severy Pits, Rochester, Vermont CUTBACK ASPHALT - Mobile Oil Co., East Providence, Rhode Island BITUMINOUS CONCRETE - L.M. Dike & Son, Inc., Proctor, Vermont Plant REINF. CONCRETE PIPE - American Marietta Co., Windsor, Vermont ACCG METAL PIPE and CG METAL PLATE PIPE - New England Metal Culvert Co., Palmer, Mass. and Armco Steel Corp., Middletown, Ohio CONCRETE, CLASS B - Joseph P. Carrara & Sons, Inc., Rutland, Vermont REINFORCING STEEL - Bethlehem Steel Co., Bethlehem, Pa. GUARD RAIL - Bethlehem Steel Co., Sparrows Point, Maryland WOOD POSTS - Koppers, Nashua, N.H. and Stoddard Enterprises, Inc., Northfield, Vermont TIMBER CURB - Koppers, Nashua, New Hampshire
CONTRACTOR - Burnett and Campbell, Inc., P.O. 2, Burlington, Vermont RESIDENT ENGINEER - William B. Lowe INSPECTORS - Sherwood C. Murray, R. Guthridge RECORD PLANS - S.C. Murray, W.B. Lowe
CONTRACT DATED - Nov. 9, 1960 CONTRACT STARTED - Nov. 15, 1960 CONTRACT COMPLETED - Aug. 9, 1962 CONTRACT ACCEPTED - Aug. 9, 1962

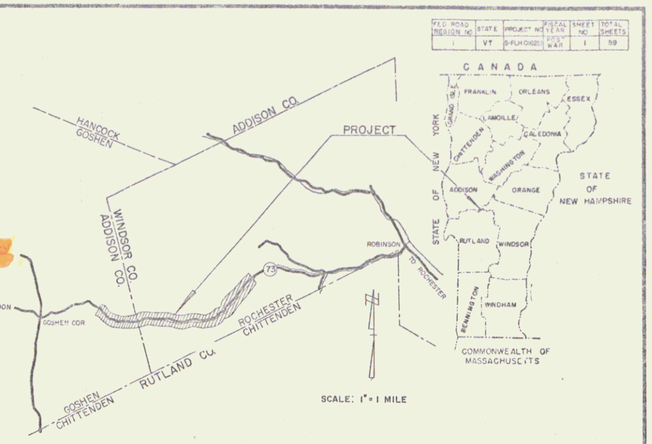

Project : S-FLH 0162(1)
PIN : 000419
Date : 06/30/1960

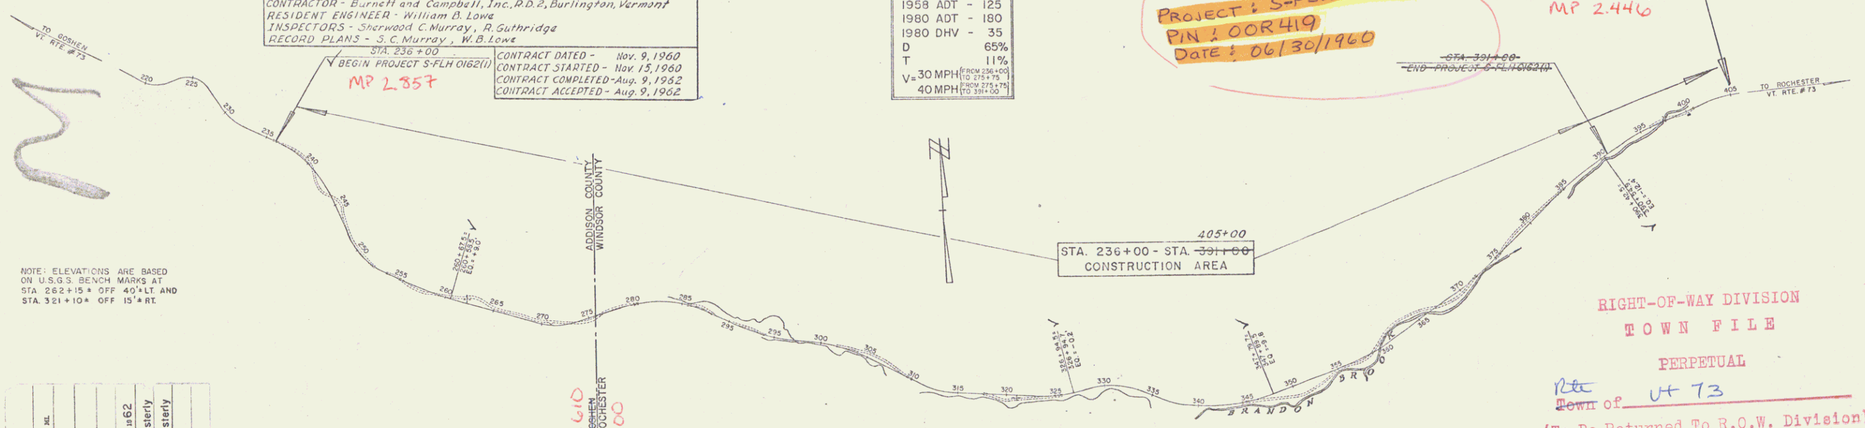

NOTE: ELEVATIONS ARE BASED ON U.S.G.S. BENCH MARKS AT STA. 262+15 ± OFF 40'± LT. AND STA. 321+10 ± OFF 15'± RT.

RIGHT-OF-WAY DIVISION
TOWN FILE
PERPETUAL
Rte ~~Town~~ of Vt 73
(To Be Returned To R.O.W. Division)

COUNTY
TOWN L
FENCE L
STOVE
UNFENC
GUARD
TRAVEL
RAILRO
RETAIN
CENTER
SURVEY
CULVER
DROP I
TROLLE
POWER
TELEPH
TREES
HEDGE

PROJECT GOSHEN-ROCHESTER LENGTH 3.198 MI.
PROJECT S-FLH 0162 (1)
TYPE BITUMINOUS CONCRETE
CONSTRUCTION BURNETT & CAMPBELL, INC. YEAR 1962
LOCATION Beginning at a point approximately 0.75 mile westerly of The Goshen – Rochester Town Line and extending easterly 3.198 mile.

R.O.W. DIVISION FILE
GOSHEN-ROCHESTER S-FLH 0162 (1)
CONTRACTOR - BURNETT AND CAMPBELL, INC.
CONSTRUCTION COMPLETED - AUGUST 9, 1962
RECORD PLANS - S.C. MURRAY & W.B. LOWE

GROUND ELEVATION — DATUM — USE ℄ LINE
GRADE ELEVATION — DATUM — ℄ LINE

CURVE DATA

DEFLECTION OF ANGLE	Δ
DEGREE OF CURVE	D
RADIUS OF CURVE	R
TANGENT DISTANCE	T
LENGTH OF CURVE	L
EXTERNAL DISTANCE	E
POINT OF INTERSECTION	P.I.
POINT OF CURVE	P.C.
POINT OF TANGENT	P.T.
POINT ON TANGENT	POT
POINT ON SUB-TANGENT	POST

SCALES

TITLE		1" = 600'
TYPICAL		1" = 2'
PLAN		1" = 50'
PROFILE	HORIZONTAL	1" = 50'
	VERTICAL	1" = 10'
CROSS-SECTIONS		1" = 10'

NOTE: ANY FURTHER INFORMATION PERTAINING FINAL QUANTITIES, AMOUNTS OR OTHER DETAILS RELATIVE TO THIS PROJECT MAY BE FOUND IN EITHER THE FIELD BOOKS OR THE ESTIMATE FILE.

THESE PLANS ARE SUBJECT TO SUCH REVISIONS AS MAY BE REQUIRED BY THE BUREAU OF PUBLIC ROADS OR THE COMMISSIONER OF HIGHWAYS.

CONSTRUCTION IS TO BE CARRIED ON IN ACCORDANCE WITH THE PLANS AND THE STANDARD SPECIFICATIONS FOR HIGHWAY AND BRIDGE CONSTRUCTION OF JANUARY 1956 SUBMITTED TO THE BUREAU OF PUBLIC ROADS AS APPROVED JULY 5, 1956, INCLUDING ALL SUBSEQUENT APPROVED REVISIONS AND SUCH REVISED SPECIFICATIONS AND SPECIAL PROVISIONS AS ARE SUBMITTED WITH THE PLANS.

DEPARTMENT OF COMMERCE
BUREAU OF PUBLIC ROADS
APPROVED
DIVISION ENGINEER — DATE

APPROVED R.H. Hoyt, SECONDARY ENGINEER	APPROVED E.H. Stickney, CONSTRUCTION ENGINEER	APPROVED BRIDGE ENGINEER	APPROVED K.C. Perkins, DISTRICT ENGINEER	APPROVED G.M. Love, HIGHWAY ENGINEER	APPROVED A.D. Tinkham, CHIEF ENGINEER
DATE June 3, 1960	DATE June 3, 1960	DATE	DATE June 3, 1960	DATE June 3, 1960	DATE June 3, 1960 SUBMITTED BY ORDER OF THE STATE HIGHWAY BOARD

PROJECT S-FLH NO. 0162 (1)
SHEET 1 OF 59 SHEETS

FED. ROAD REGION NO.	STATE	PROJECT NO.	FISCAL YEAR	SHEET NO.	TOTAL SHEETS
1	VT	S-FLH 0162(1)	1961 WAR	1	59