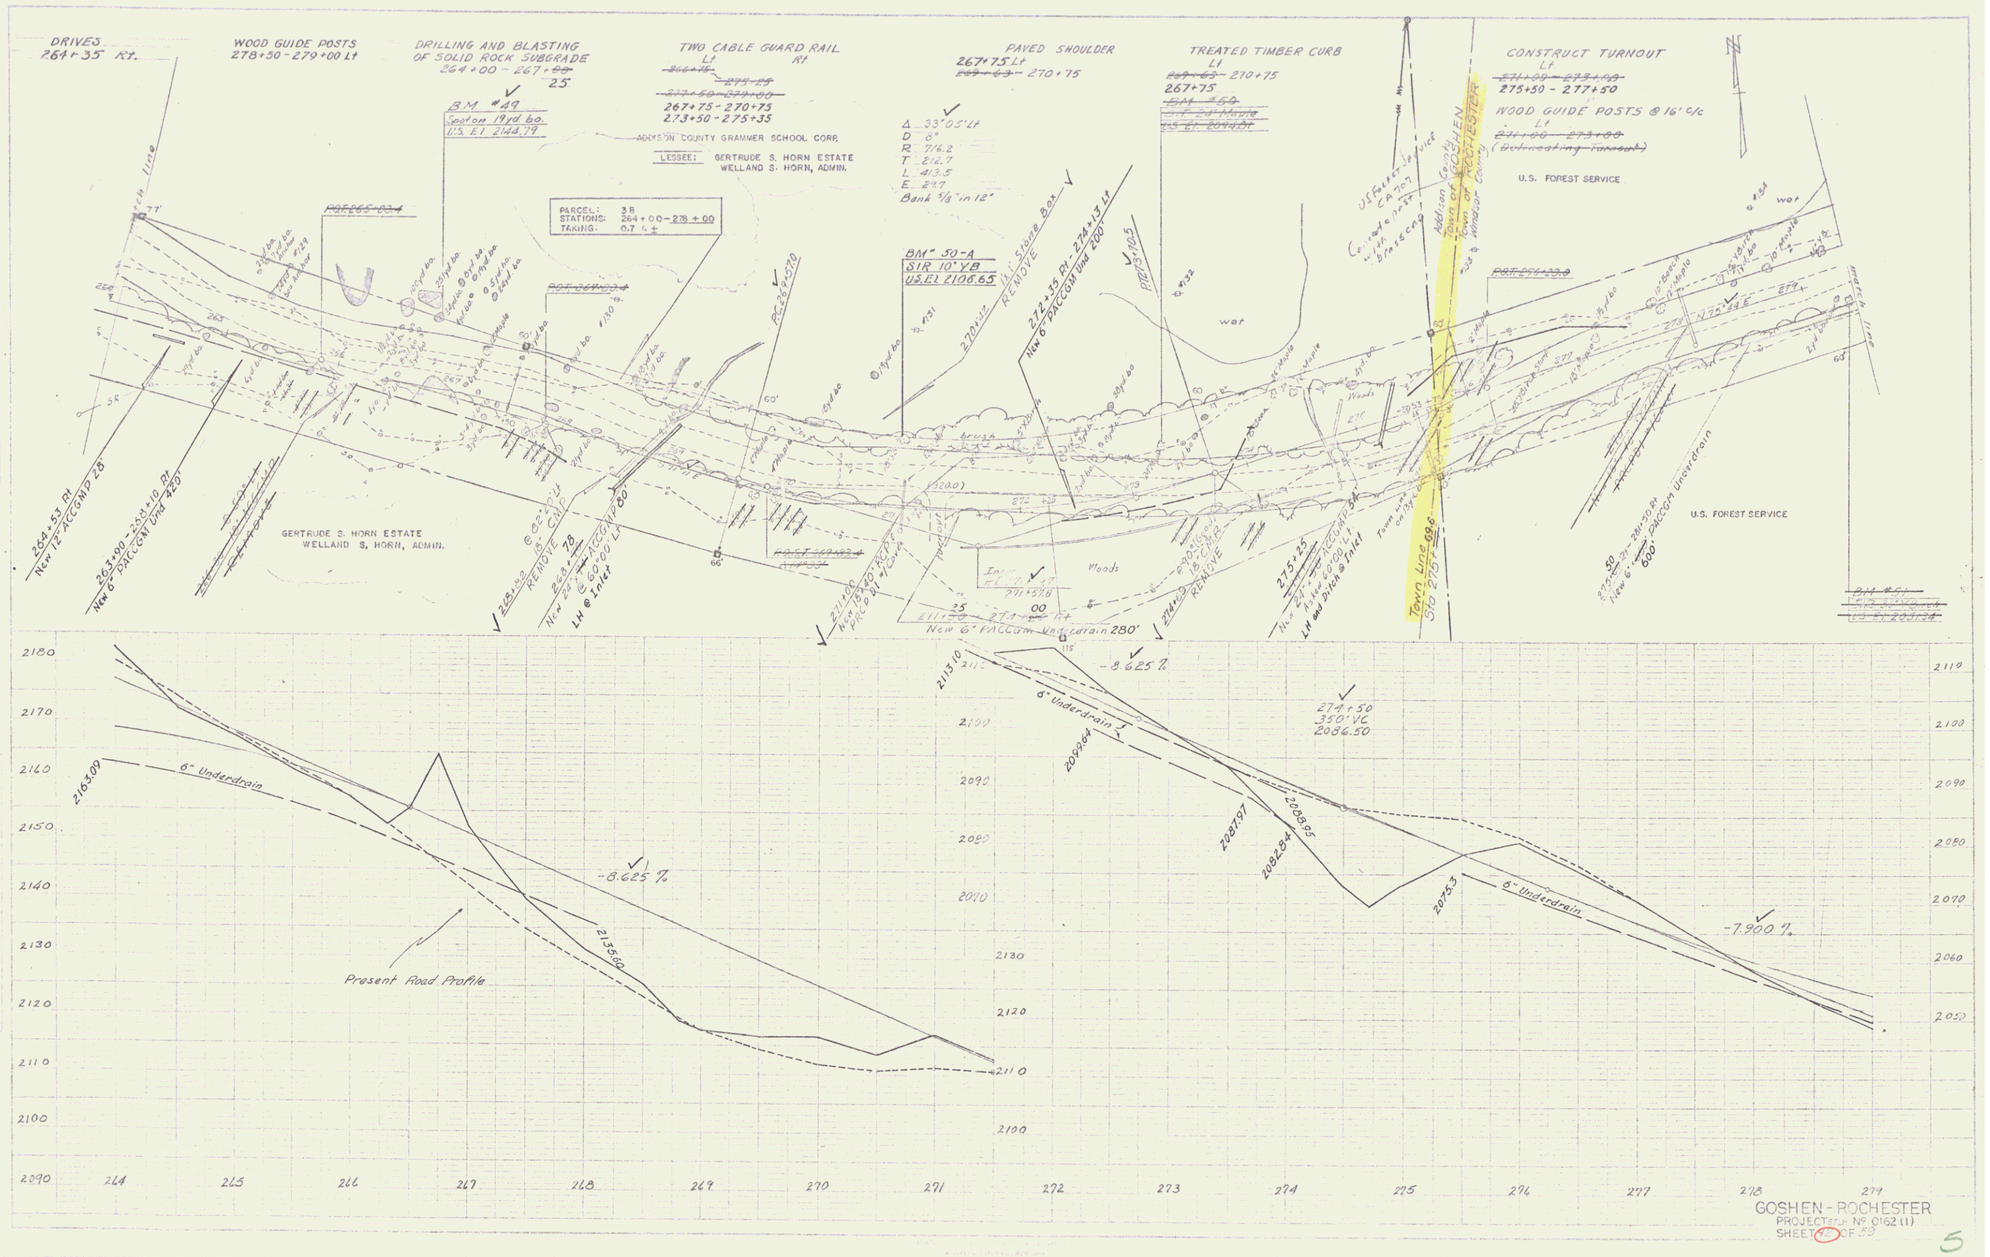

GOSHEN - ROCHESTER
PROJECT No. 0162 (1)
SHEET 5 OF 59

5