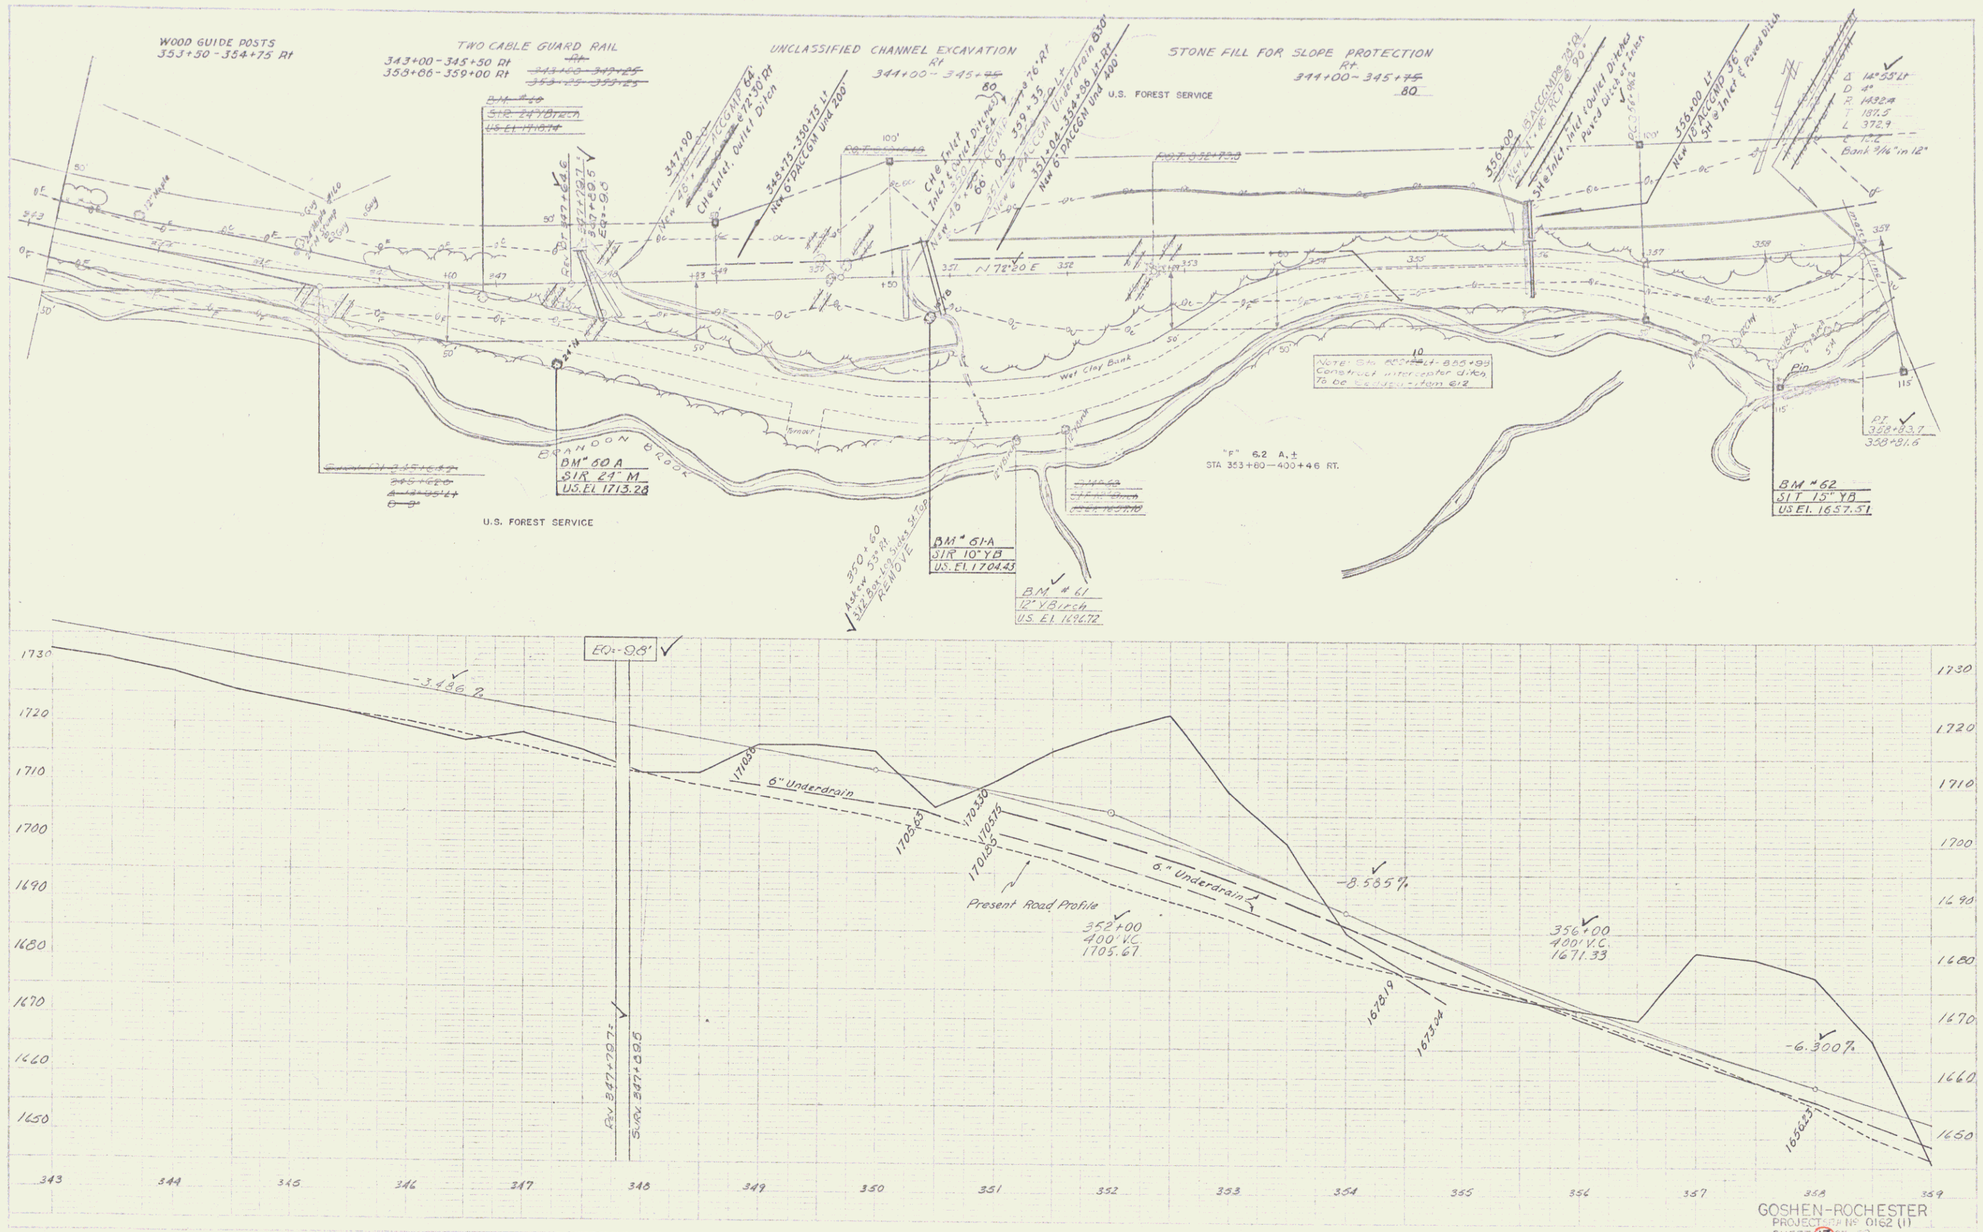
WOOD GUIDE POSTS
353+50 - 354+75 Rt
TWO CABLE GUARD RAIL
343+00 - 345+50 Rt
358+66 - 359+00 Rt
UNCLASSIFIED CHANNEL EXCAVATION
Rt
344+00 - 345+80
STONE FILL FOR SLOPE PROTECTION
Rt
344+00 - 345+80
U.S. FOREST SERVICE
BRANDON BLOCK
BM # 60 A
SIR 24" M
US. El 1713.28
BM # 61 A
SIR 10" YB
US. El. 1704.43
BM # 61
12" V Birch
US. El. 1696.72
BM # 62
SIT 15" YB
US. El. 1657.51
"F" 6.2 A.±
STA 353+80 — 400+46 RT.
Wet Clay Bank
Pin
Present Road Profile
6" Underdrain
-3.486 %
-8.585 %
-6.300 %
EQ = -9.8'
Rev. 347+79.7
S.Rx. 347+28.5
352+00
400' V.C.
1705.67
356+00
400' V.C.
1671.33
GOSHEN-ROCHESTER
PROJECT NO. 0162 (1)
SHEET 17 OF 53