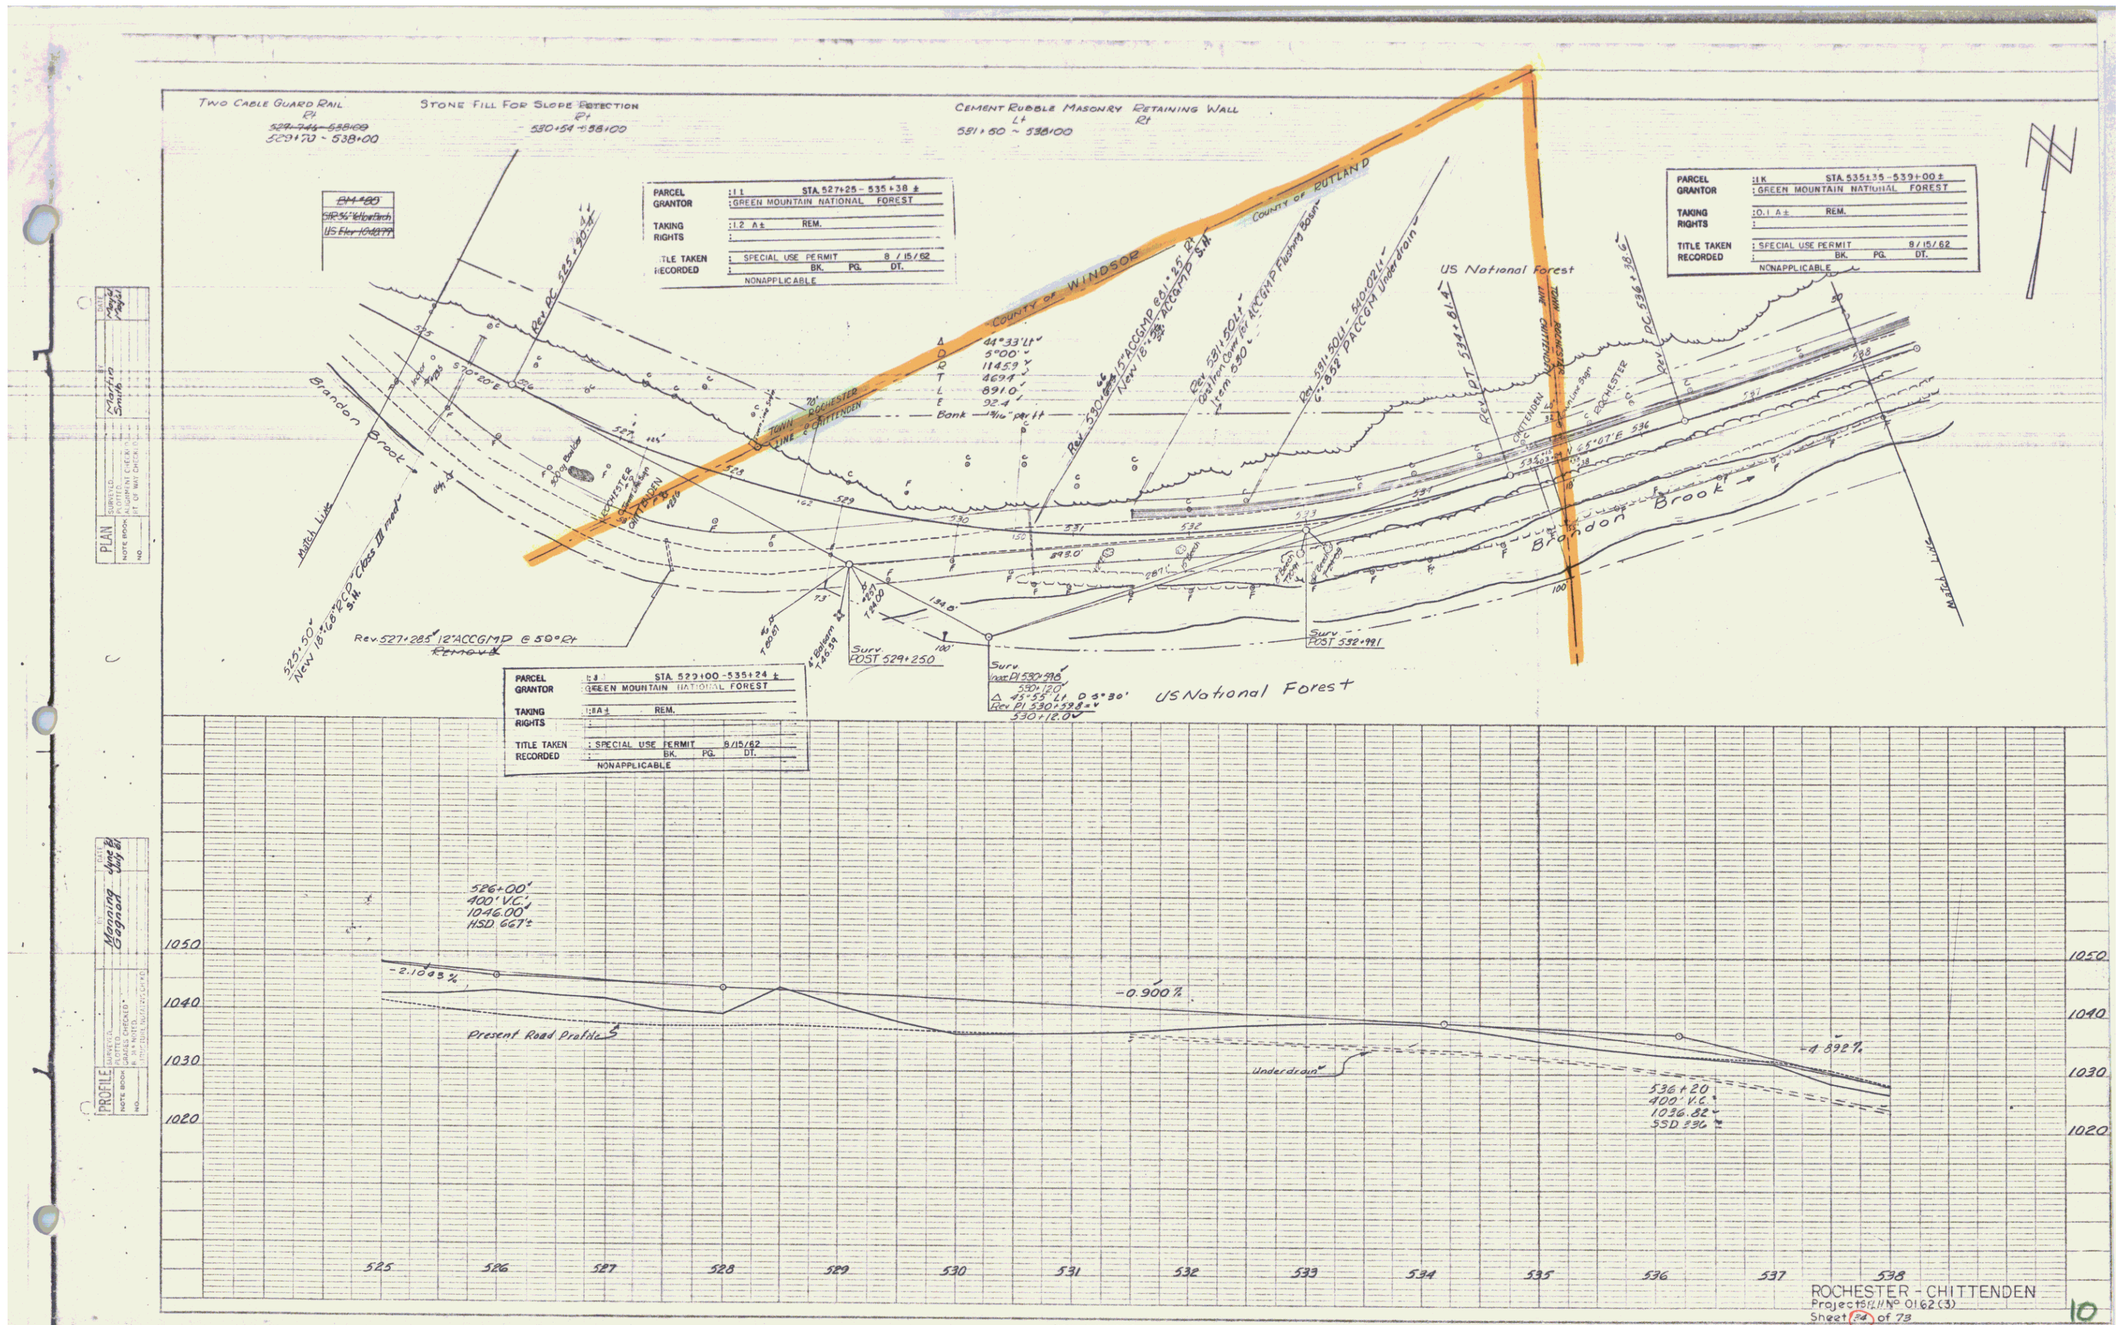

PLATE 3 - PLAN - PROFILE O.P.R.&R.E. STANDARD
REGITEL & BEIER CO., NEW YORK