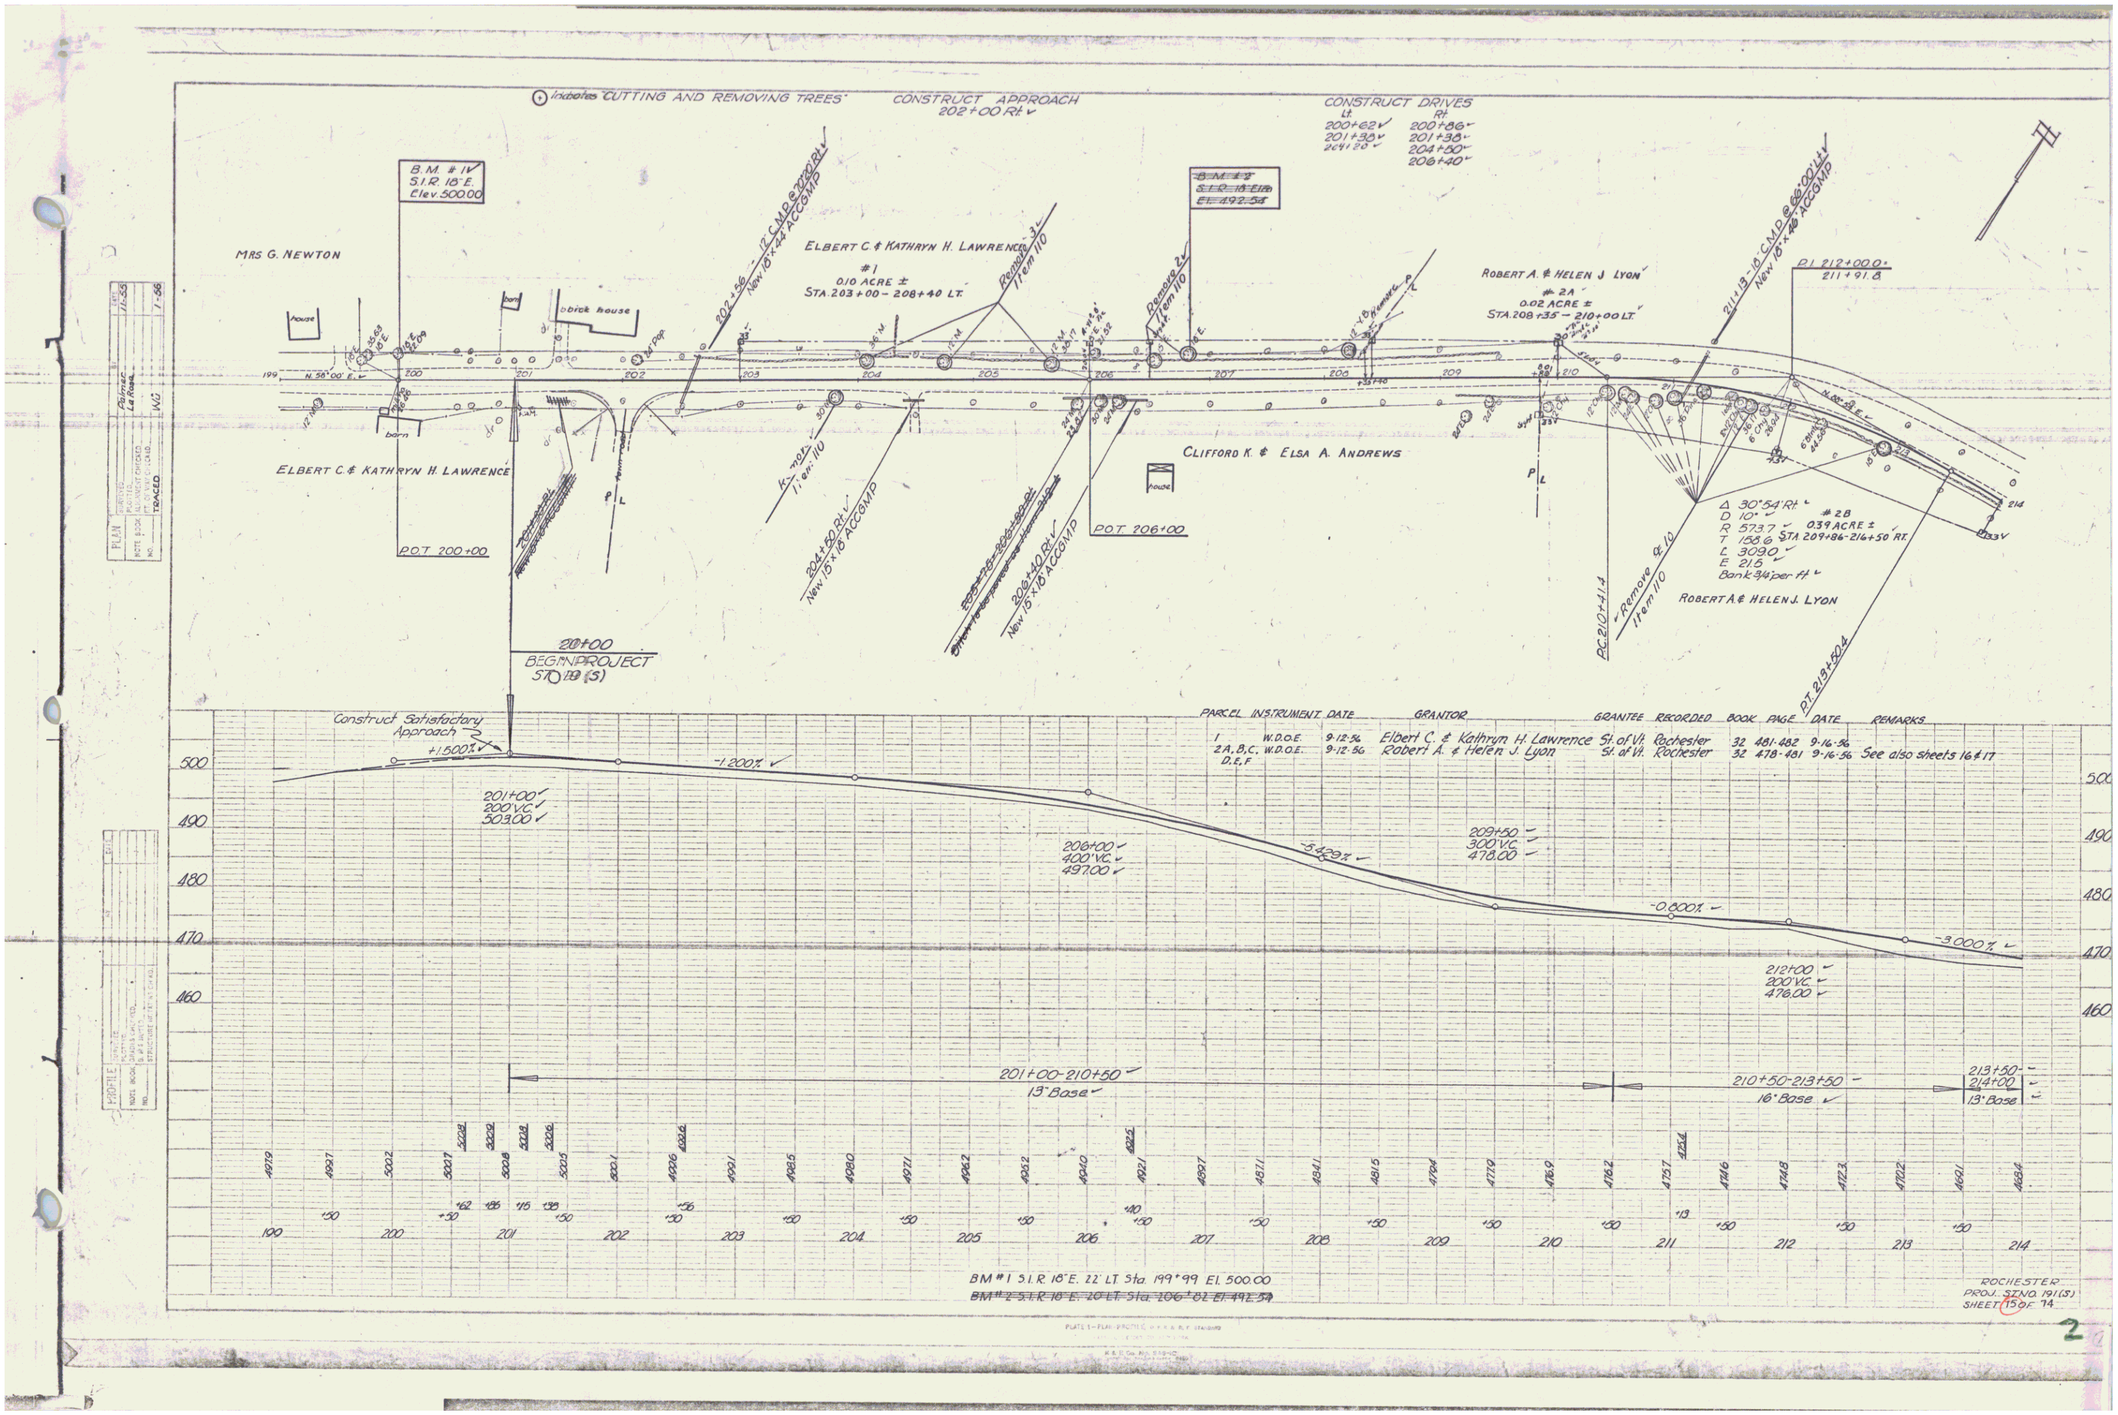

PARCEL	INSTRUMENT	DATE	GRANTOR	GRANTEE	RECORDED BOOK	PAGE	DATE	REMARKS
1	W.D.O.E.	9-12-56	Elbert C. & Kathryn H. Lawrence	St. of Vt.	Rochester 32	481-482	9-16-56	
2A, B, C, D, E, F	W.D.O.E.	9-12-56	Robert A. & Helen J. Lyon	St. of Vt.	Rochester 32	478-481	9-16-56	See also sheets 16 & 17

2