⊙ Indicates "Cutting and Removing Trees", Item 110

TWO CABLE GUARD RAIL
Lt Rt
~~216+64 - 220+64~~
Wood Guide Posts
Lt
224+64 - 225+44
218+50 - 220+66

CONSTRUCT DRIVES
Lt Rt
221+00 — 221+00
223+00 — 223+00
224+28 — 221+75
213+50 — 224+75

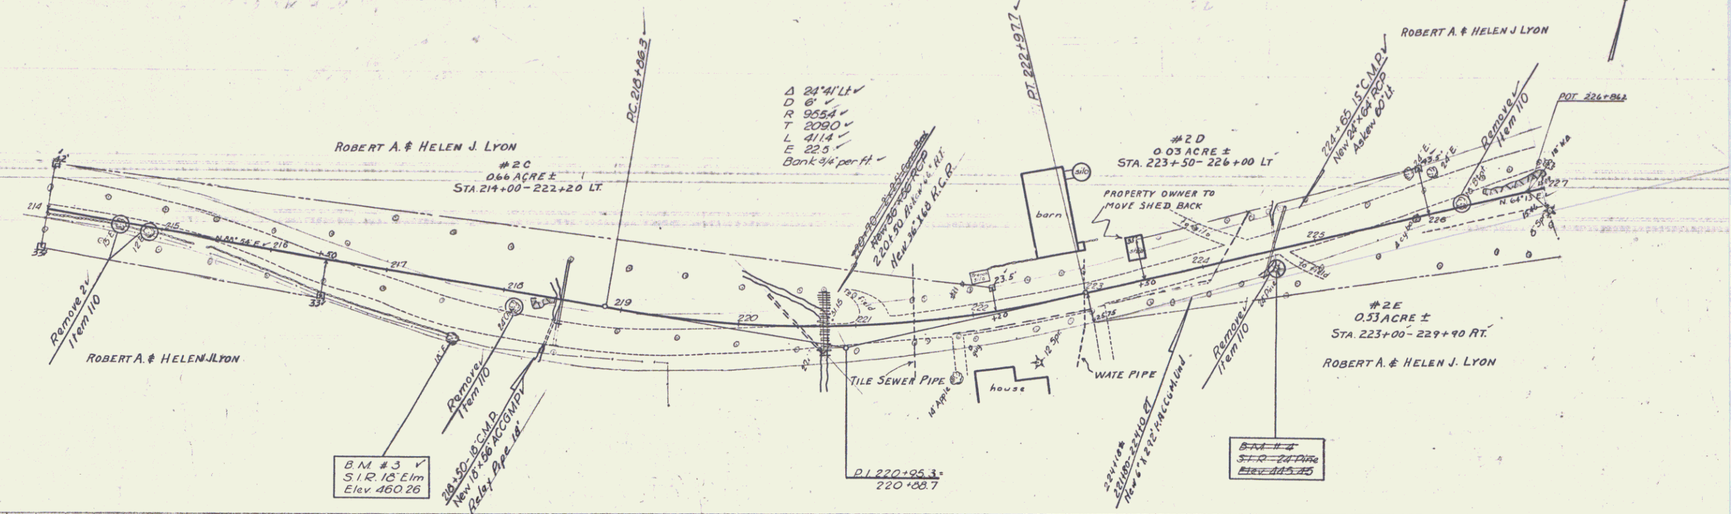

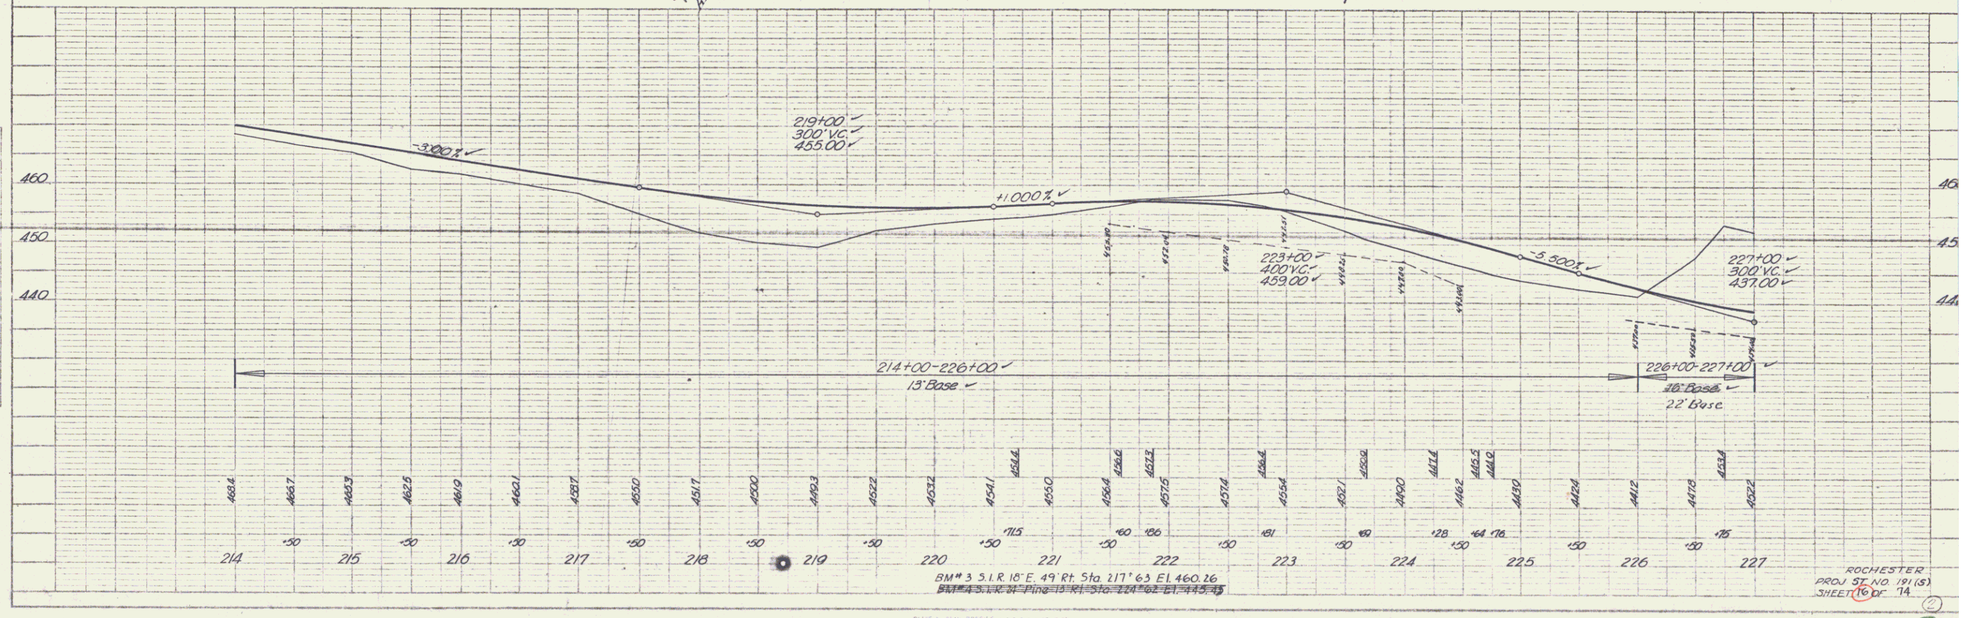

PLAN
SURVEYED
PLOTTED
ALIGNMENT CHECKED
NOTE BOOK
NO.
NO. OF RAF CHECKED
TRACED
Dumas
Lakeas
WG
1.55
1.56
1.56

PROFILE
SURVEYED
PLOTTED
GRADES CHECKED
R.M.S. PLOTTED
NOTE BOOK
NO.
STANDARD GRADES CHECKED

ROCHESTER
PROJ ST. NO. 191 (S)
SHEET 16 OF 14

3