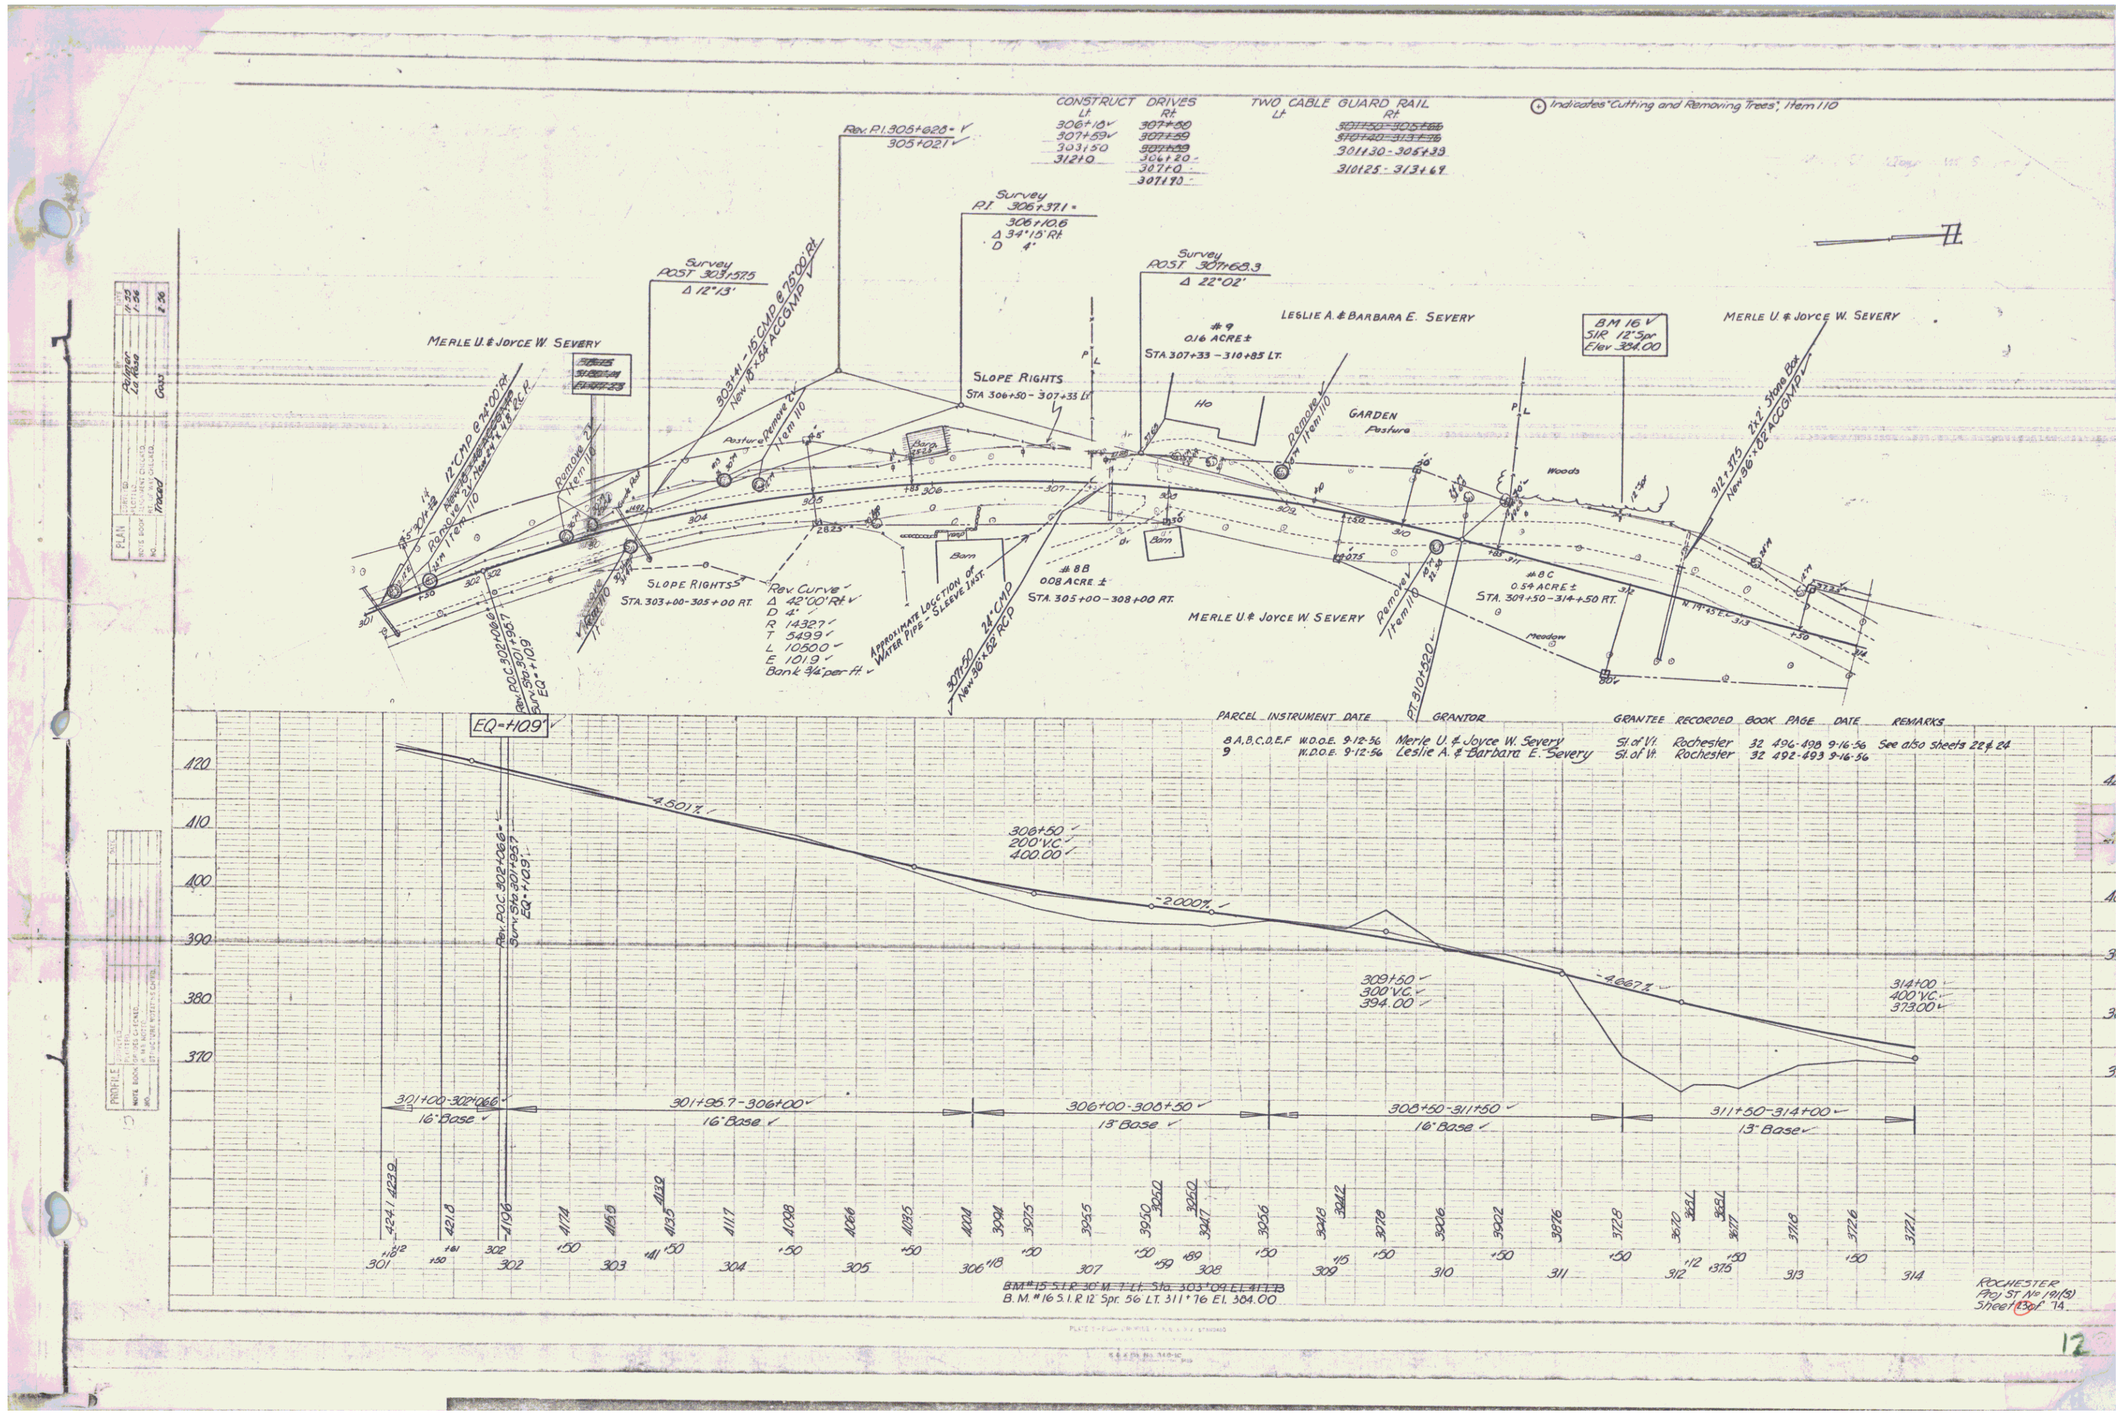

PARCEL	INSTRUMENT	DATE	GRANTOR	GRANTEE	RECORDED BOOK	PAGE	DATE	REMARKS
8 A, B, C, D, E, F	W.D.O.E.	9-12-56	Merle U. & Joyce W. Severy	St. of Vt.	Rochester	32	496-498 9-16-56	See also Sheets 22 & 24
9	W.D.O.E.	9-12-56	Leslie A. & Barbara E. Severy	St. of Vt.	Rochester	32	492-493 9-16-56	