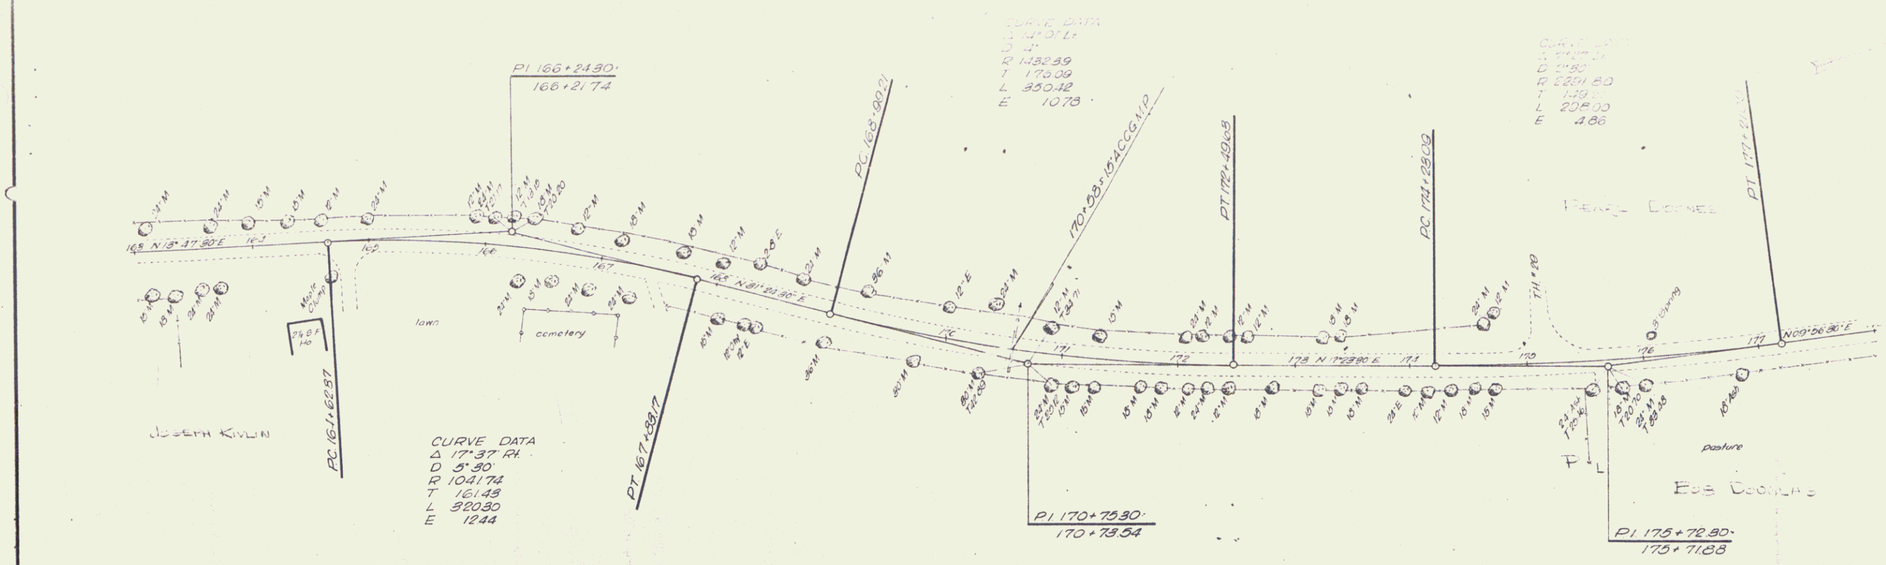
P.I. 166+24.30'
166+21.74
PC 166+90.21
170+58.15 ACCGMP
PT 171+49.03
PT 171+
PEARL DONES
N 13°47.90' E
N 21°21.90' E
N 17°39.90' E
N 09°56.30' E
lawn
cemetery
JOSEPH KIVLIN
PC 161+62.37
PT 167+68.17
CURVE DATA
Δ 17°37' Rt.
D 5°30'
R 1041.74
T 161.43
L 320.30
E 12.44
CURVE DATA
Δ 17°
D 4°
R 1482.39
T 173.09
L 350.42
E 10.78
P.I. 170+78.30'
170+78.54
P.I. 175+72.80'
175+71.88
pasture
BOB DOONES

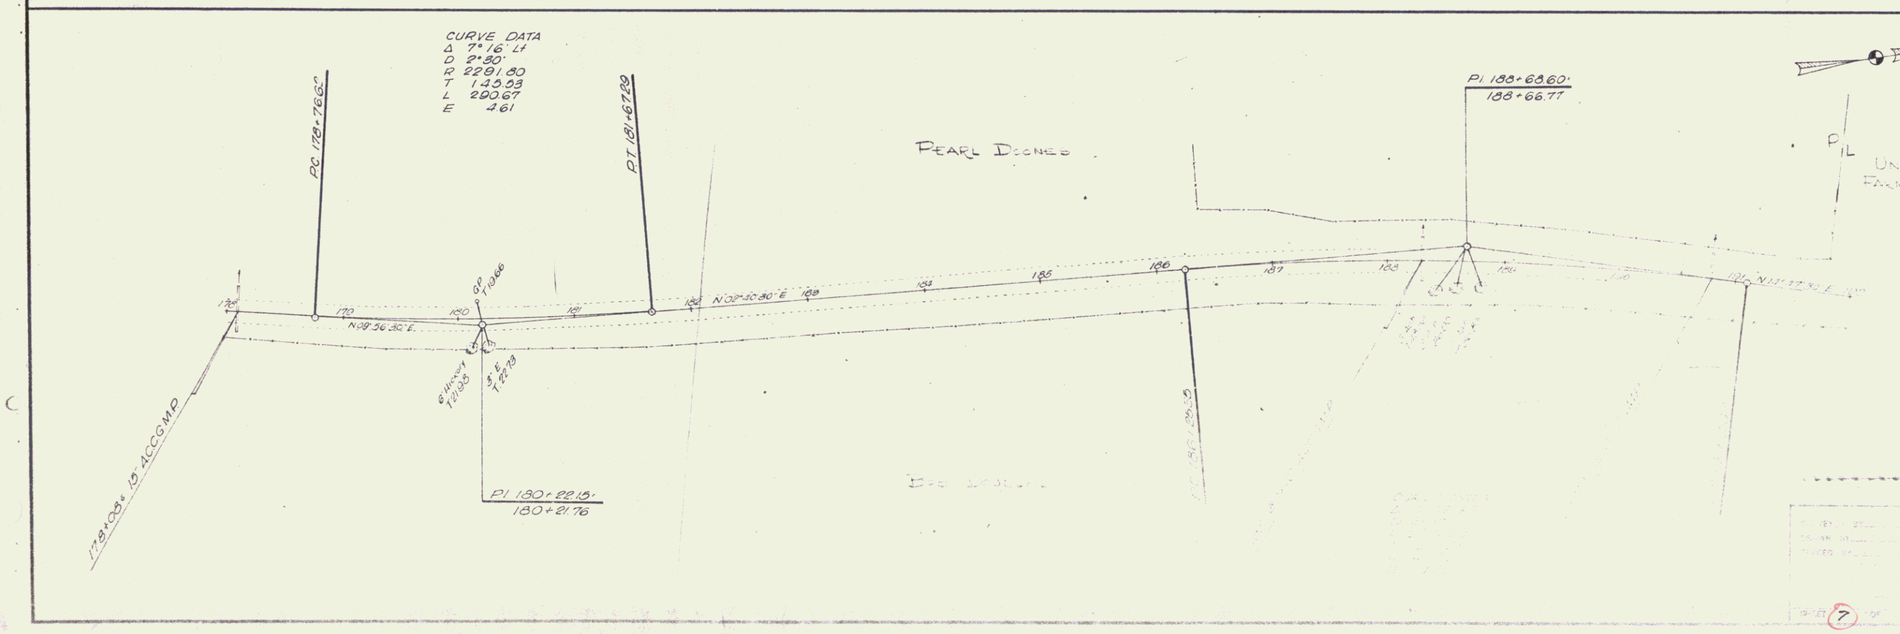
CURVE DATA
Δ 7°16' Lt
D 2°30'
R 2291.80
T 145.53
L 290.67
E 4.61
PC 178+76.62
PT 181+67.29
PEARL DONES
P.I. 188+68.60'
188+66.77
178+05.15 ACCGMP
N 09°56.30' E
N 09°30.30' E
P.I. 180+22.15'
180+21.76
UNITED FARMERS

7