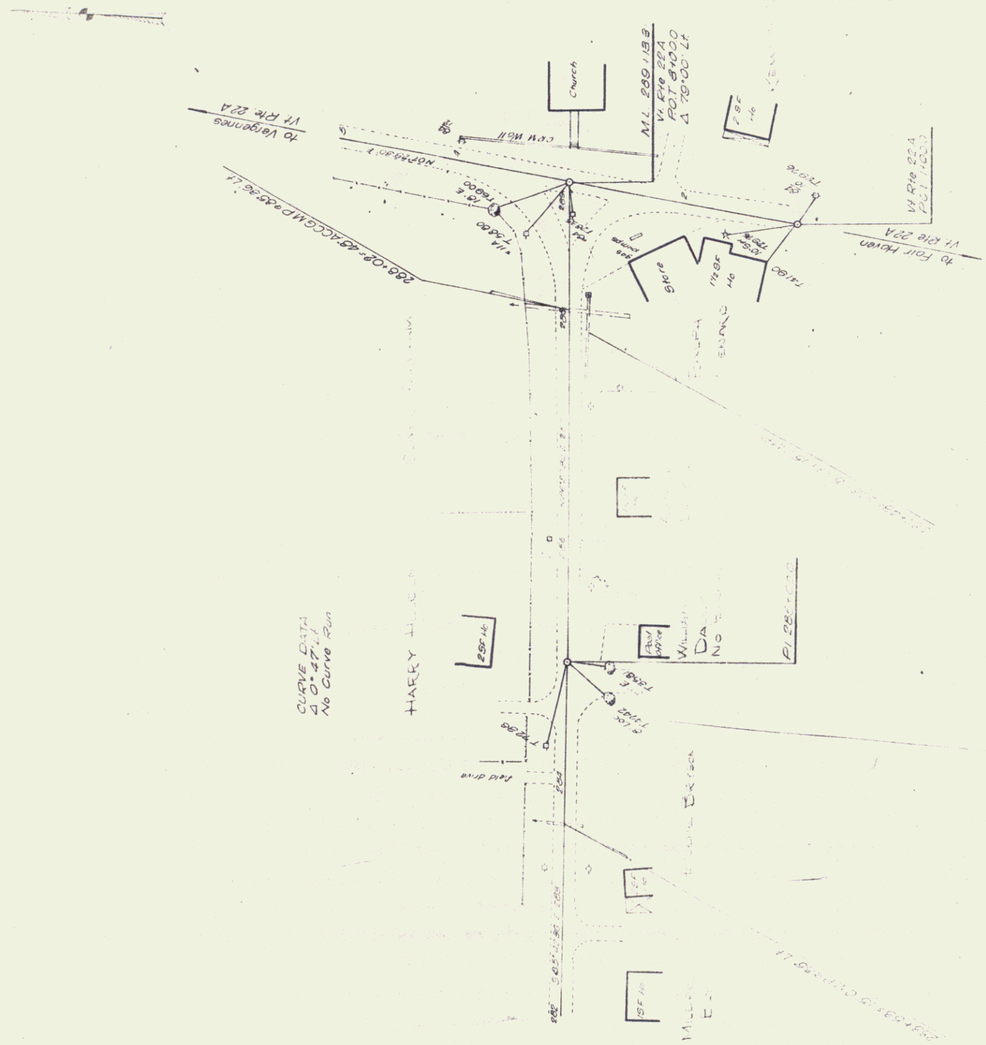
Church
Vt Rte 22A
Δ 79°00' Lt
To Vergennes
Vt Rte 22A
Vt Rte 22A
Vt Rte 22A
POT 1000
CURVE DATA
No Curve Run
HARRY
Wilbur
Da
No
Pl Rec