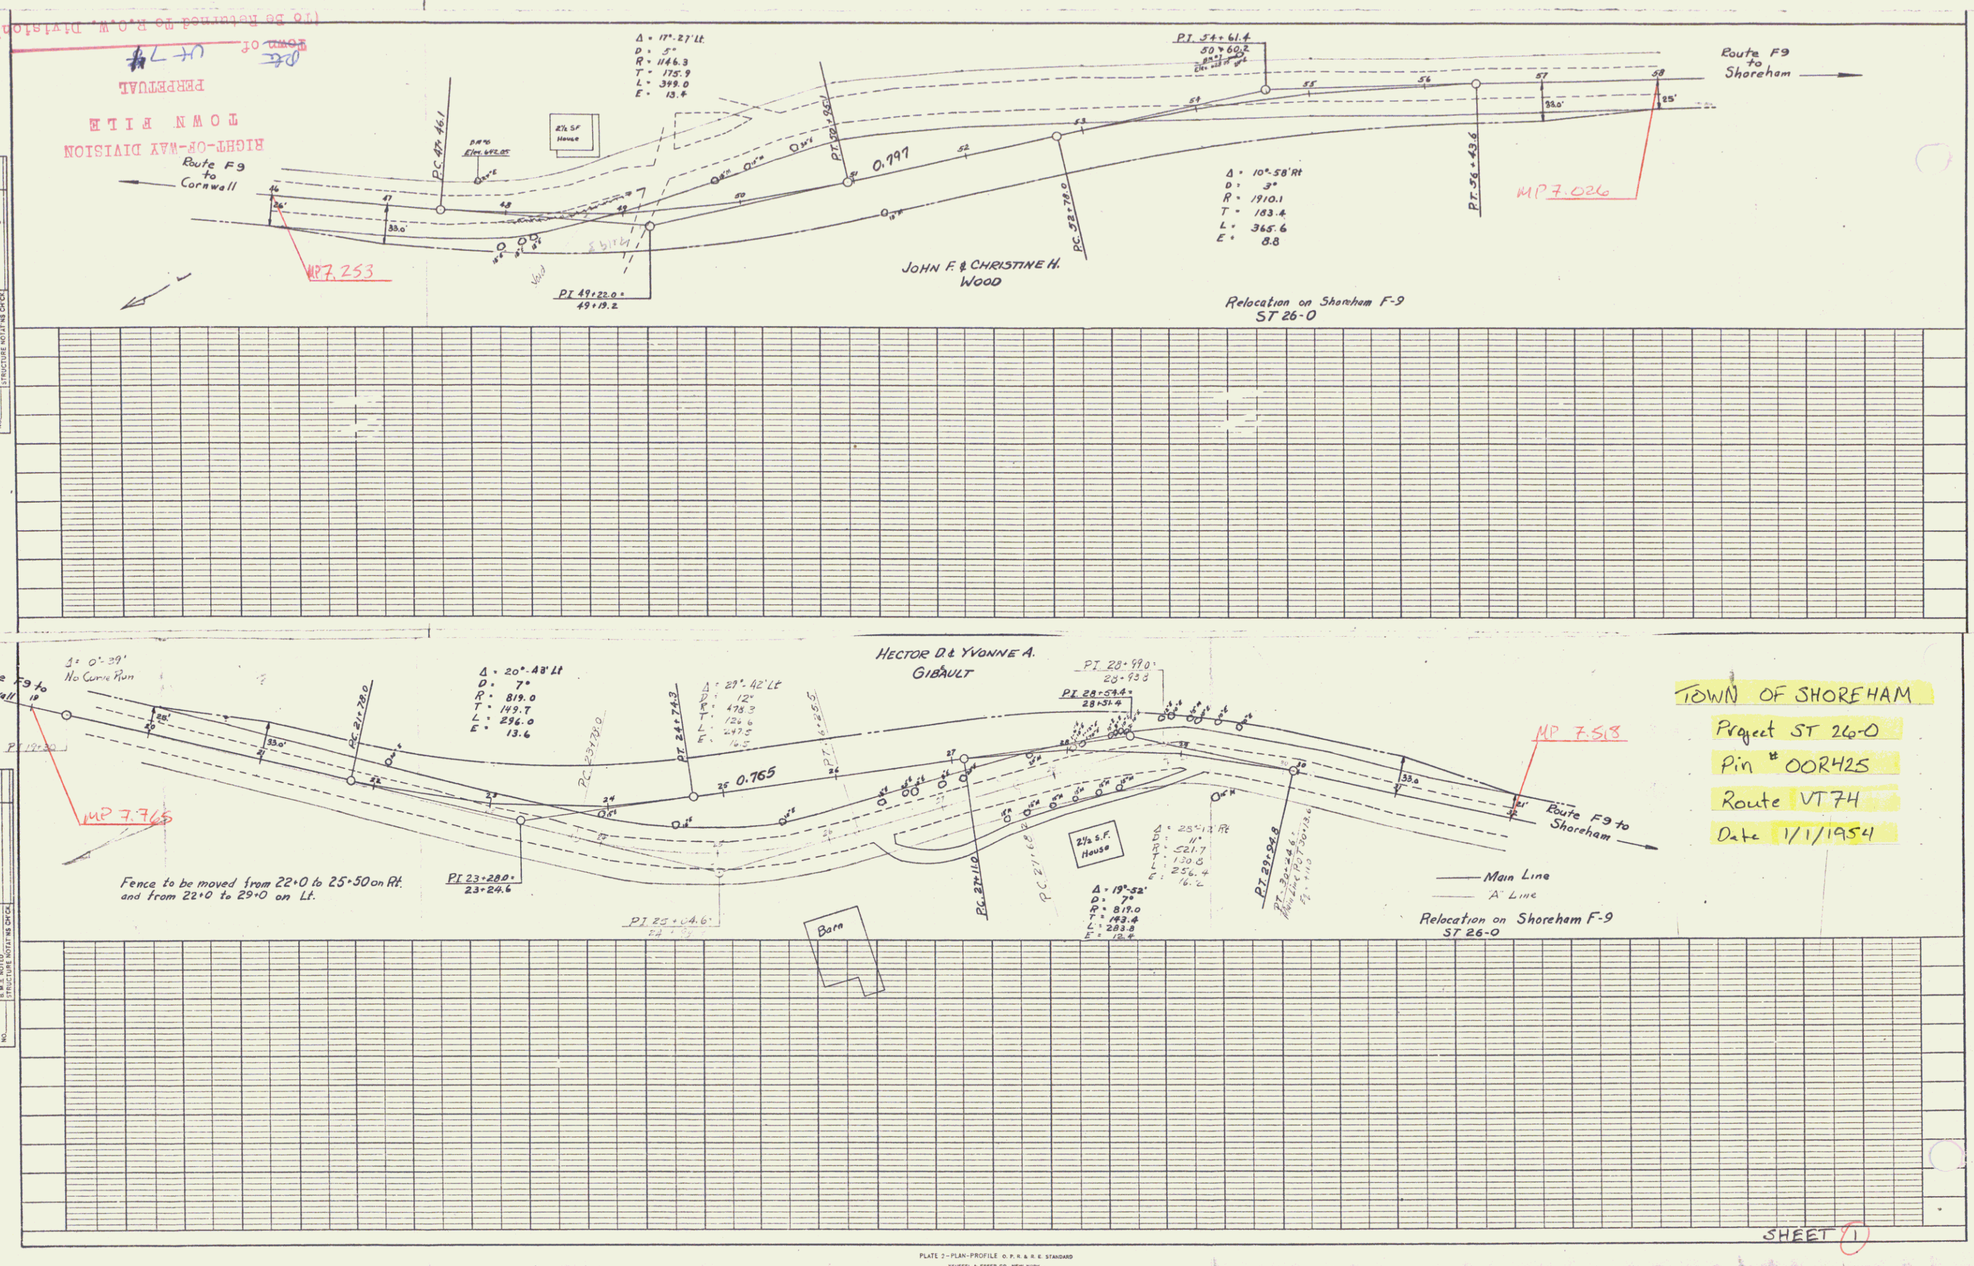

RIGHT-OF-WAY DIVISION
TOWN FILE
PERPETUAL
Dept. of Hwys. VT 74
(To Be Returned To R.O.W. Division)

SHEET 1

PLATE 2 – PLAN-PROFILE O. P. R. & R. E. STANDARD
REIFFEL & ESSER CO., NEW YORK.