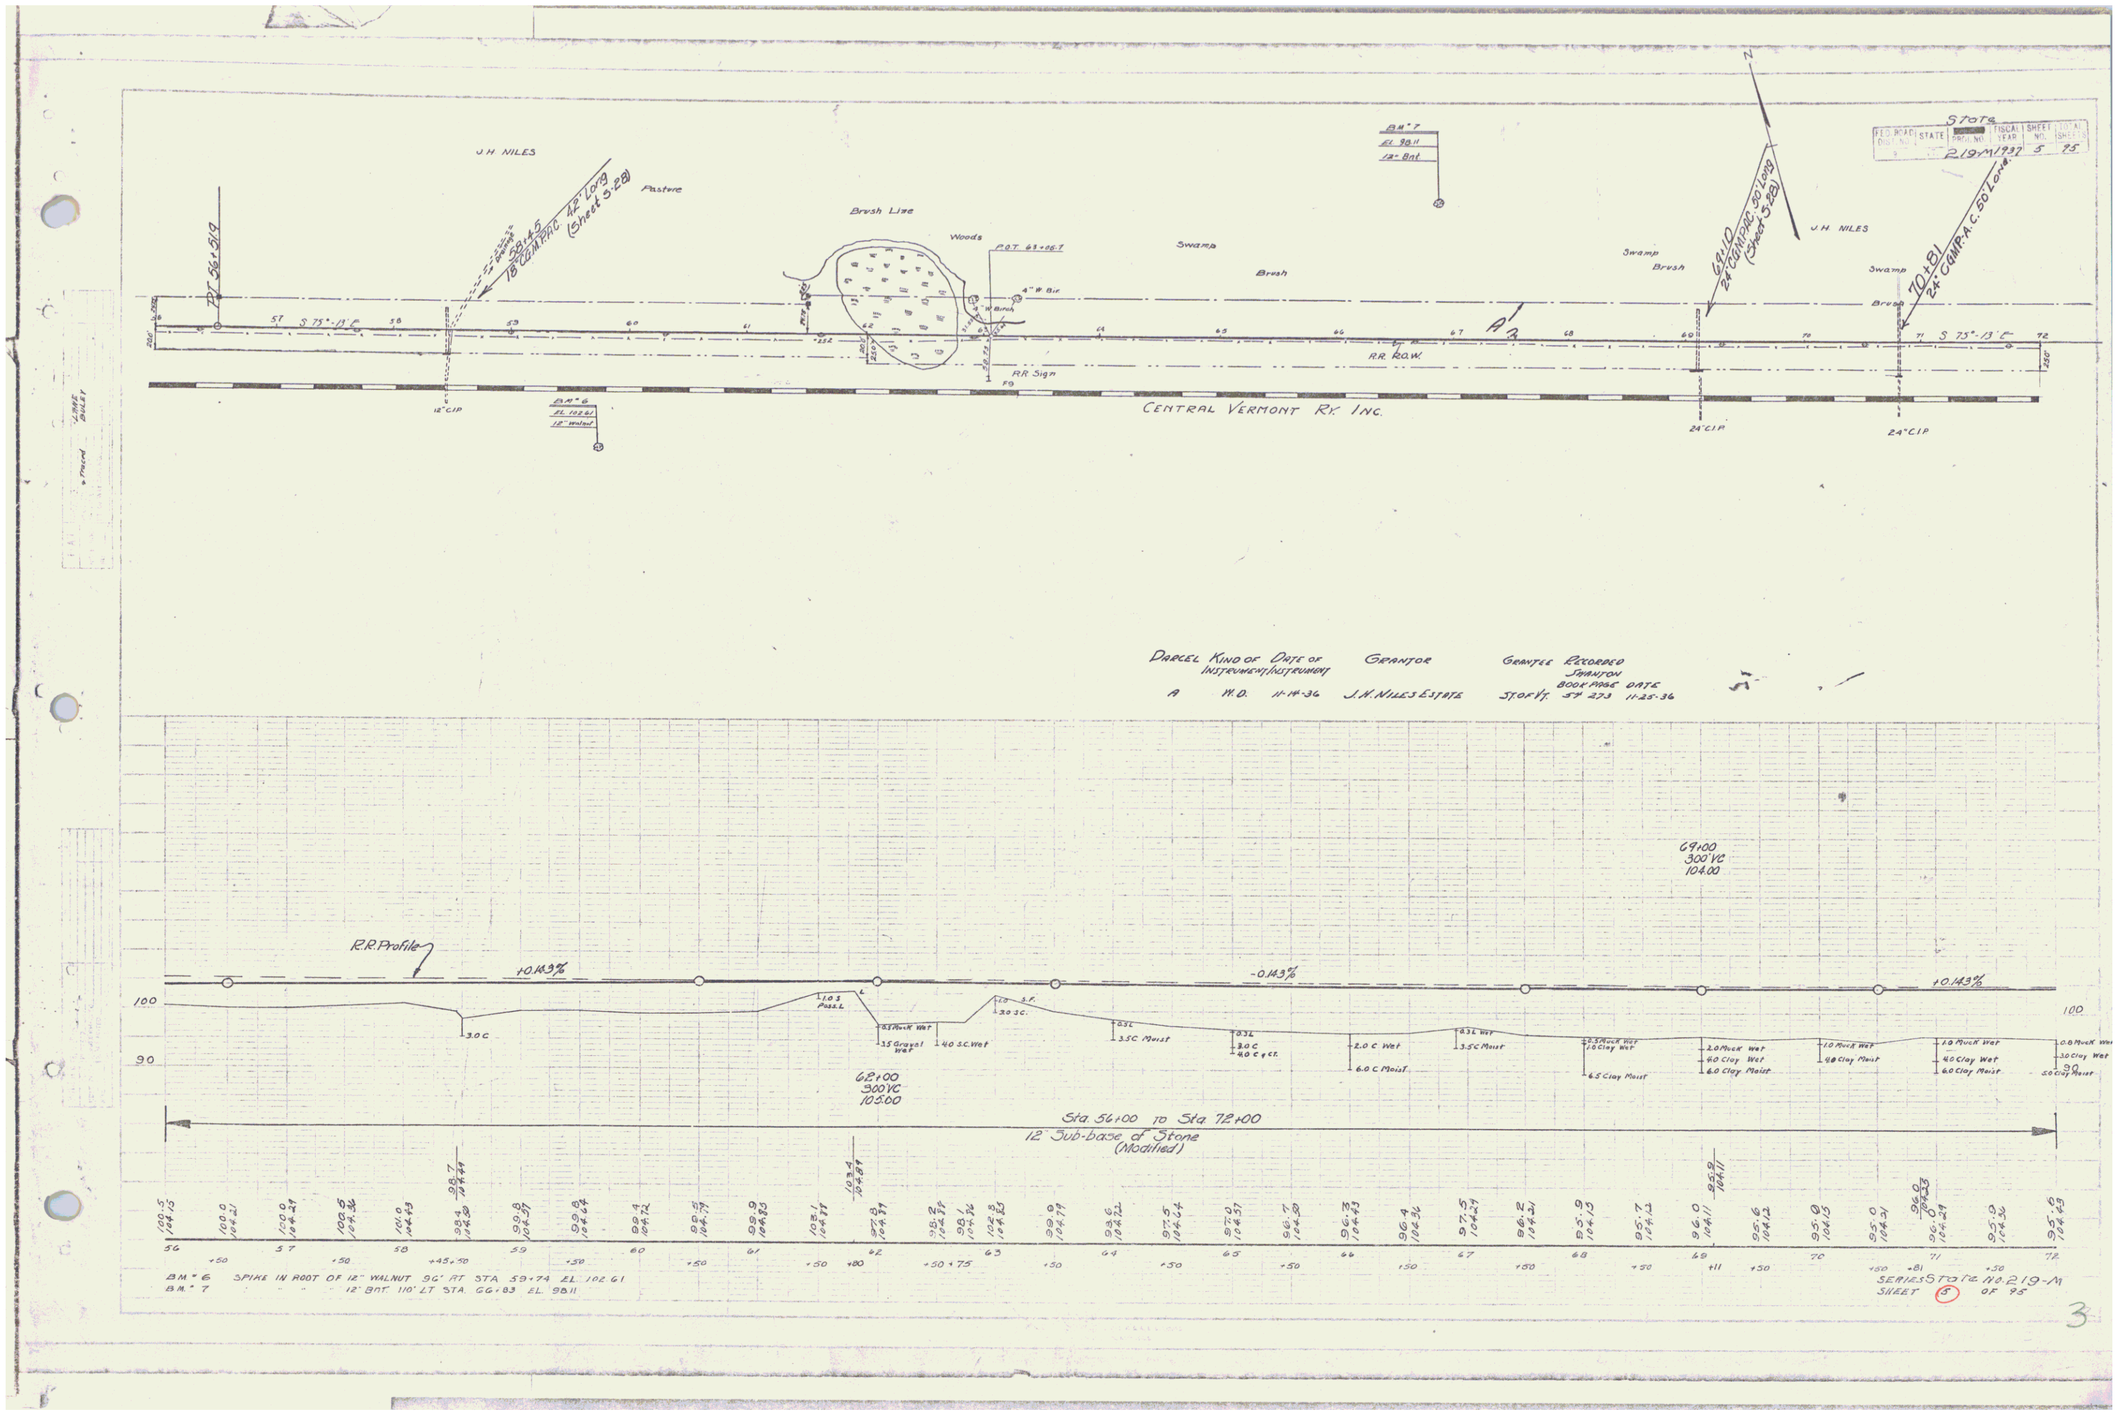

STATE
FED. ROAD DIST. NO. 9
STATE
PROJ. NO.
FISCAL YEAR
SHEET NO.
TOTAL SHEETS
219-M 1937
5
95
J.H. NILES
Pasture
Brush Line
Woods
Swamp
Brush
P.O.T. 63+06.7
4" W. Bir.
R.R. Sign
R.R. R.O.W.
CENTRAL VERMONT RY. INC.
12" C.I.P.
24" C.I.P.
BM. 7
EL. 98.11
12" Bnt.
BM. 6
EL. 102.61
12" Walnut
PT. 56+51.9
58+45
18" C.G.M.P.A.C. 42' Long (Sheet S-28)
69+10
24" C.G.M.P.A.C. 50' Long (Sheet S-28)
70+81
24" C.G.M.P.A.C. 50' Long
S 75°-13' E
DARCEL KIND OF INSTRUMENT
DATE OF INSTRUMENT
GRANTOR
GRANTEE
RECORDED SHANTON BOOK PAGE
DATE
A W.D. 11-14-36 J.H. NILES ESTATE ST. OF VT. 54 273 11-25-36
69+00
300' VC
104.00
R.R. Profile
+0.143%
-0.143%
+0.143%
100
90
62+00
300' VC
105.00
Sta. 56+00 to Sta. 72+00
12" Sub-base of Stone (Modified)
BM. 6 SPIKE IN ROOT OF 12" WALNUT 96' RT. STA. 59+74 EL. 102.61
BM. 7 12" BNT. 110' LT. STA. 66+83 EL. 98.11
SERIES STATE NO. 219-M
SHEET 5 OF 95
3