State
219-M/1937 7 95

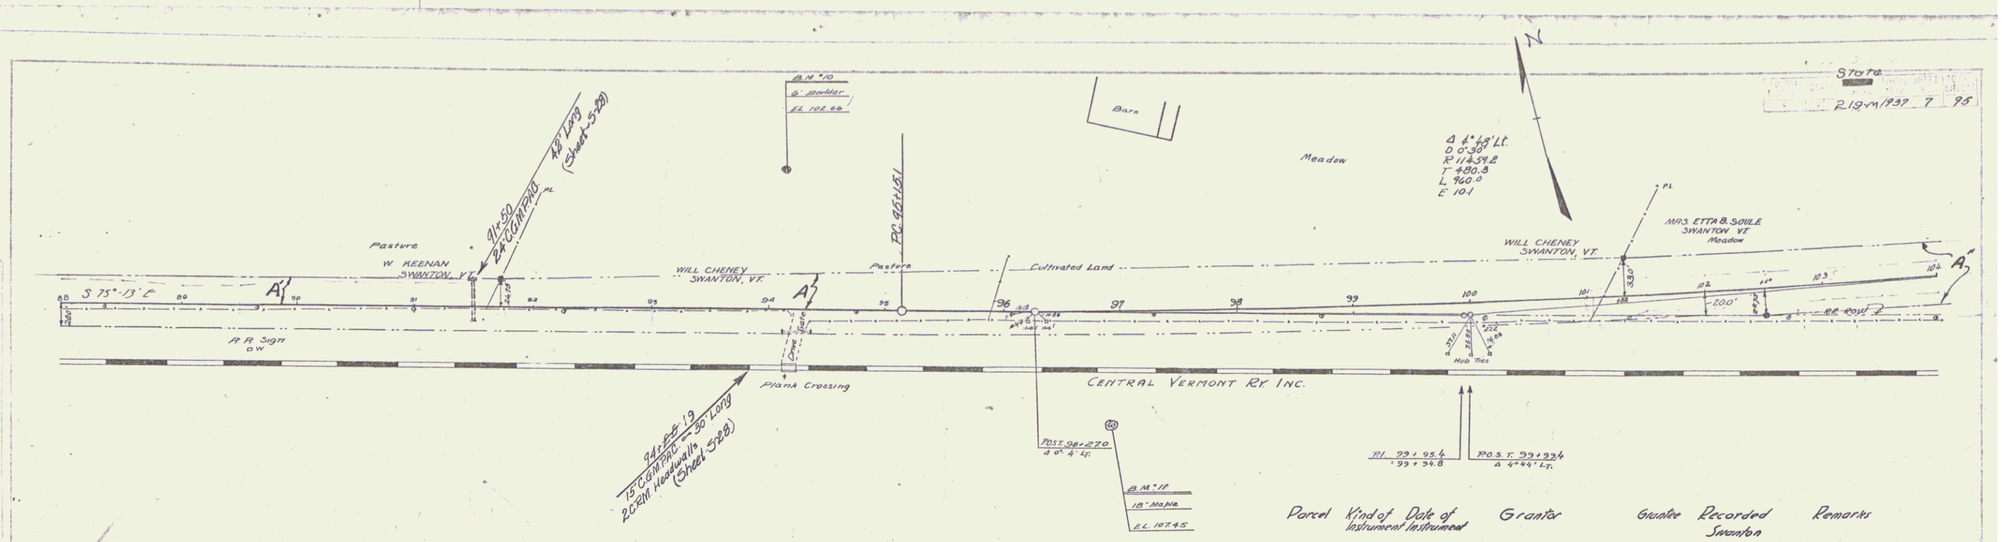

Parcel	Kind of Instrument	Date of Instrument	Grantor	Grantee	Recorded Swanton Book	Page	Date	Remarks
A	W.D.	11-6-36	Will Cheney	St. of Vt.	54	271	11-10-36	
A'	Q.C.D.	11-4-36	Washington Keenan & Wife	"	47	440	11-10-36	
A''	W.D.	11-4-36	Etta B. Soule	"	54	270	11-10-36	

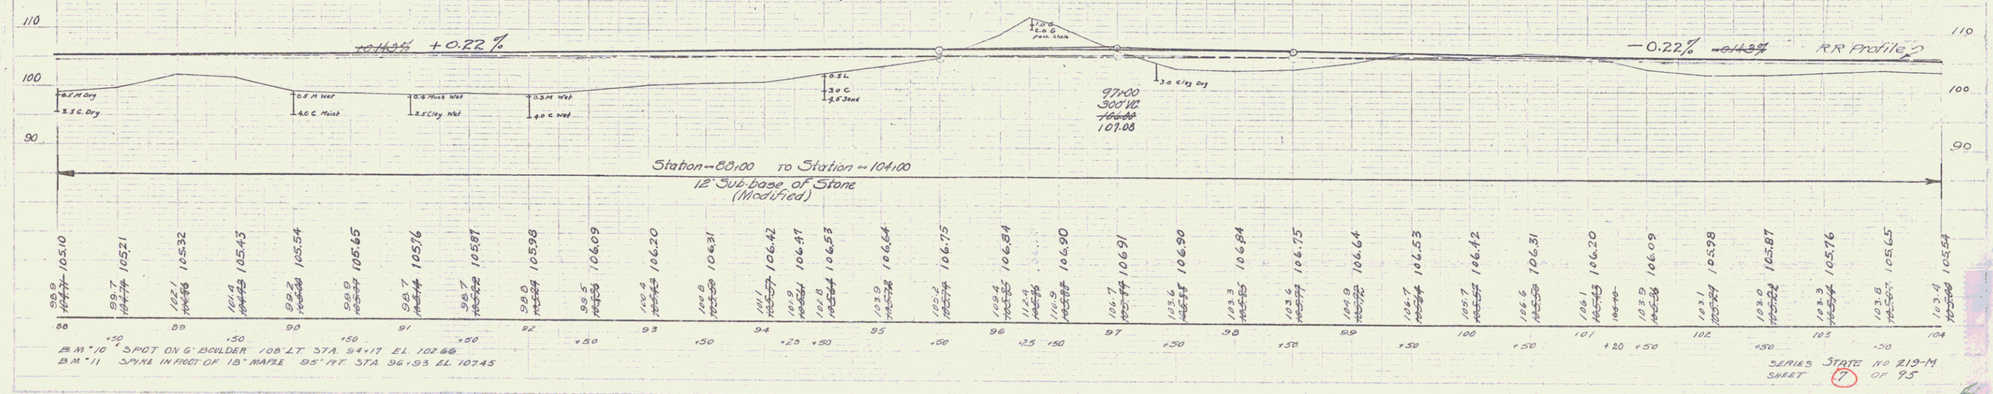

B.M. #10 SPOT ON 6' BOULDER 108' LT. STA. 94+17 EL. 102.66
B.M. #11 SPIKE IN FOOT OF 18" MAPLE 95' RT. STA. 96+93 EL. 107.45

SERIES STATE NO 219-M
SHEET 7 OF 95