F.A.I. ROAD DIST. NO.	STATE	STATE	FISCAL YEAR	SHEET NO.	TOTAL SHEETS
1	VT		219-M 1937	14	95

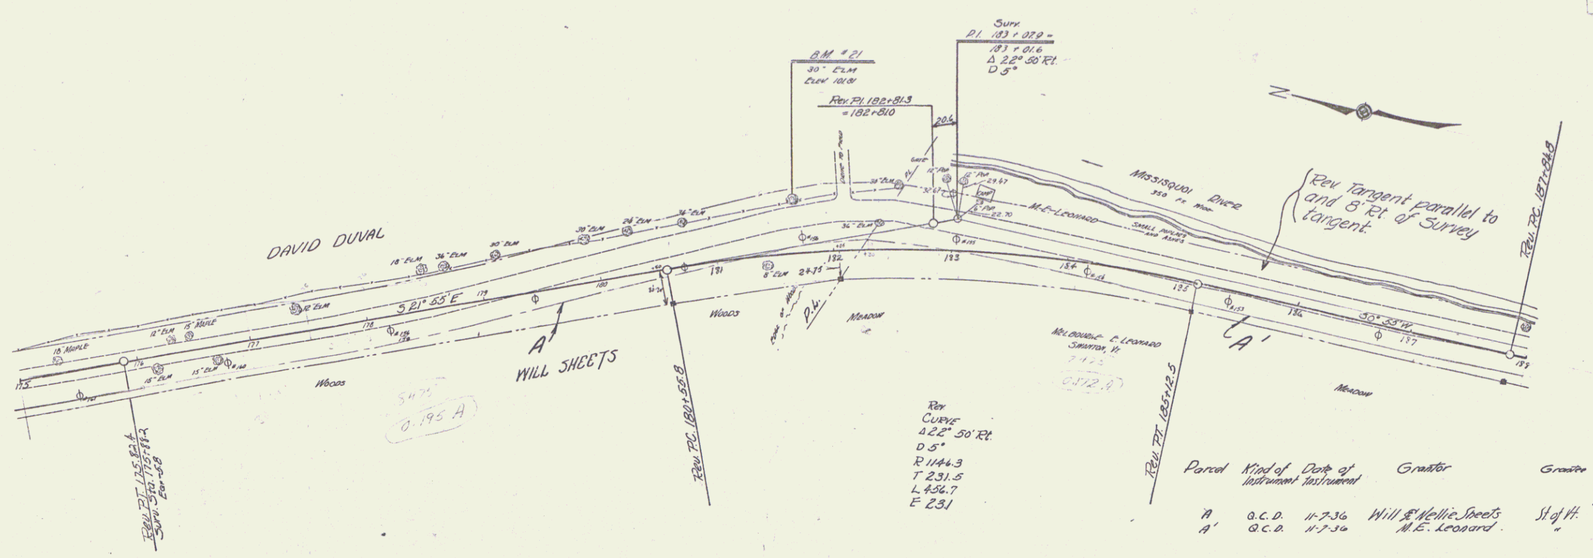

Parcel	Kind of Instrument	Date of Instrument	Grantor	Grantee	Recorded Swanton Book	Page	Date
A	Q.C.D.	11-7-36	Will & Nellie Sheets	St. of Vt.	45	455	11-10-36
A'	Q.C.D.	11-7-36	M.E. Leonard	"	45	456	11-10-36

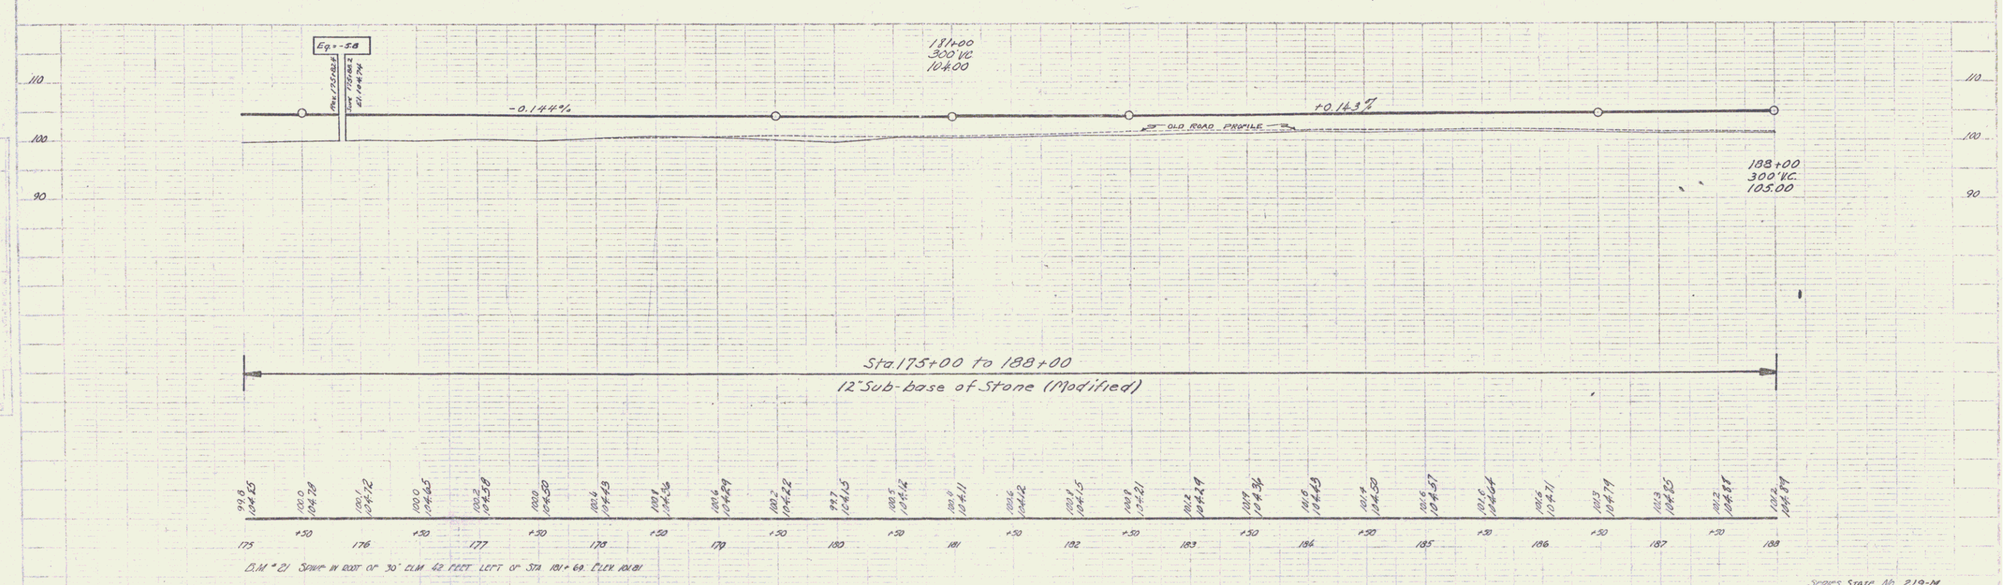

B.M. #21 Spike in root of 30" ELM 42 FEET LEFT of STA 181+69. ELEV 101.81

SHEET STATE No. 219-M
SHEET 14 OF 95 SHEETS.

12