| FED. AID PROJ. NO. | STATE | STATE PROJ. NO. | FISCAL YEAR | SHEET NO. | TOTAL SHEETS |
|---|---|---|---|---|---|
| 3 | VT. | 219-M | 1937 | 22 | 95 |

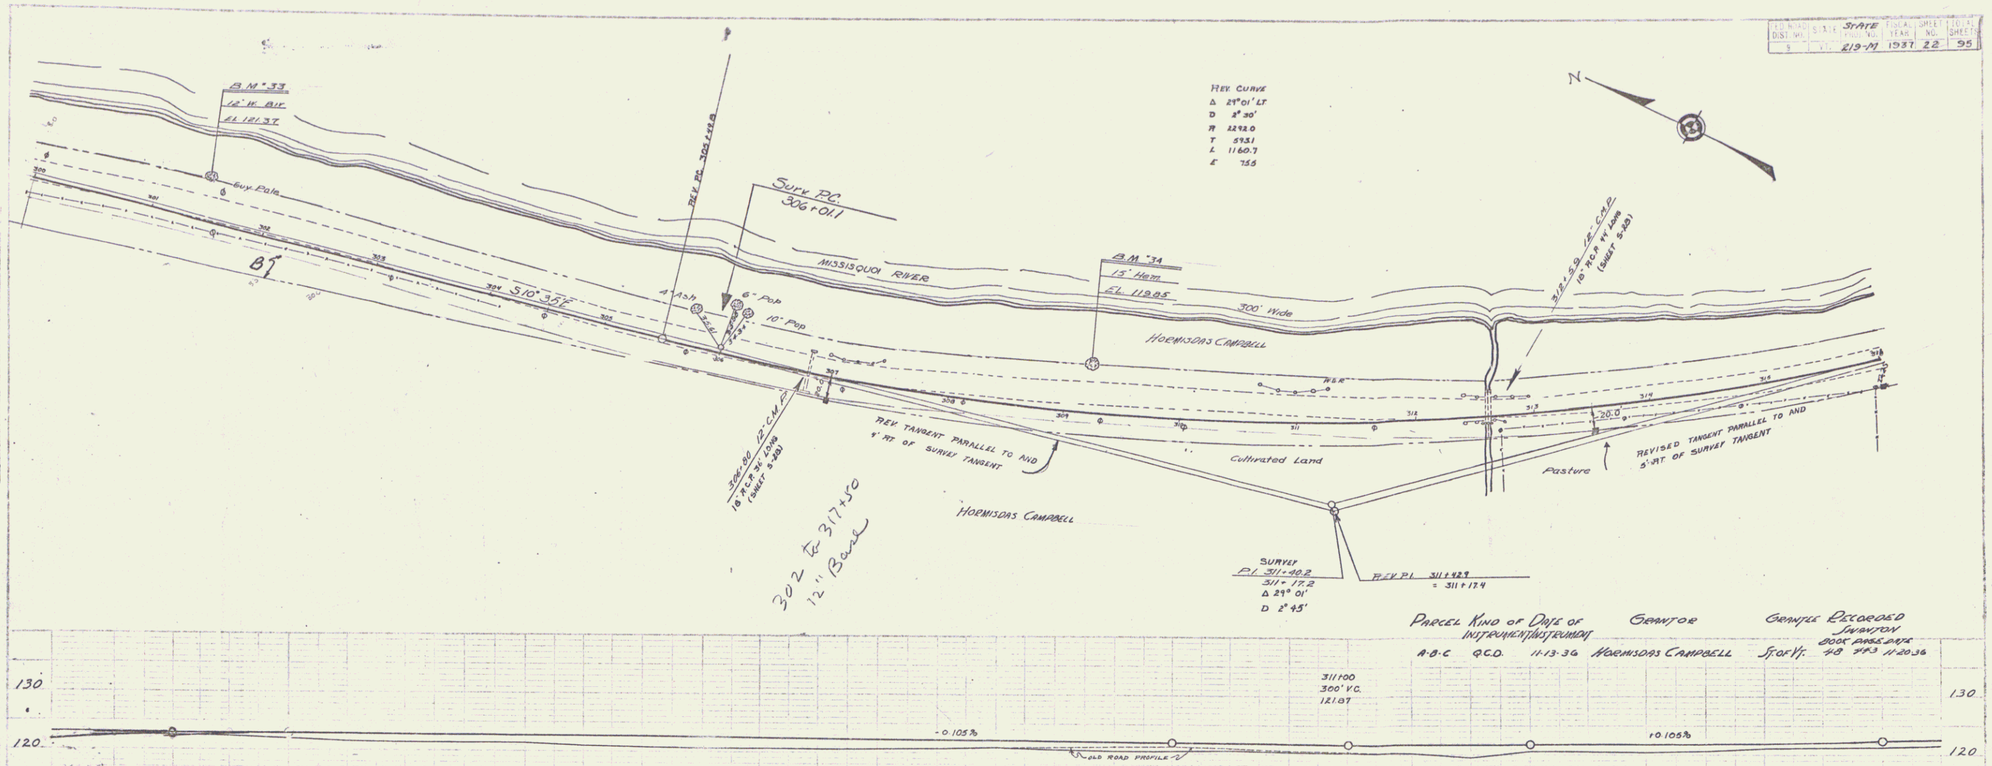


| Parcel | Kind of Use of Instrument | Grantor | Grantee | Recorded Swanton Book Page Date |
|---|---|---|---|---|
| A-B-C | Q.C.D. | 11-13-36 | Hormisdas Campbell | Sr. of Vt. 48 443 11-20-36 |

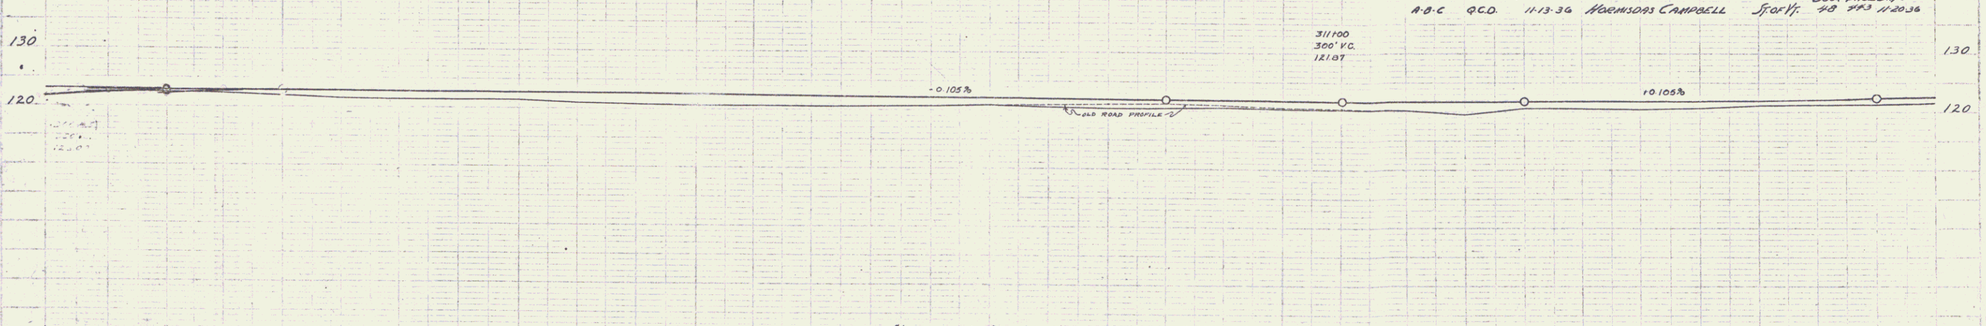


B.M. 33 SPIKE IN ROOT OF 12" W. BIRCH 32' LT. STA. 301+47 EL. 121.37
B.M. 34 " " " 15" HEMLOCK 37' LT. STA. 309+19 EL. 119.85

SERIES STATE NO. 219-M
SHEET 22 OF 95

20