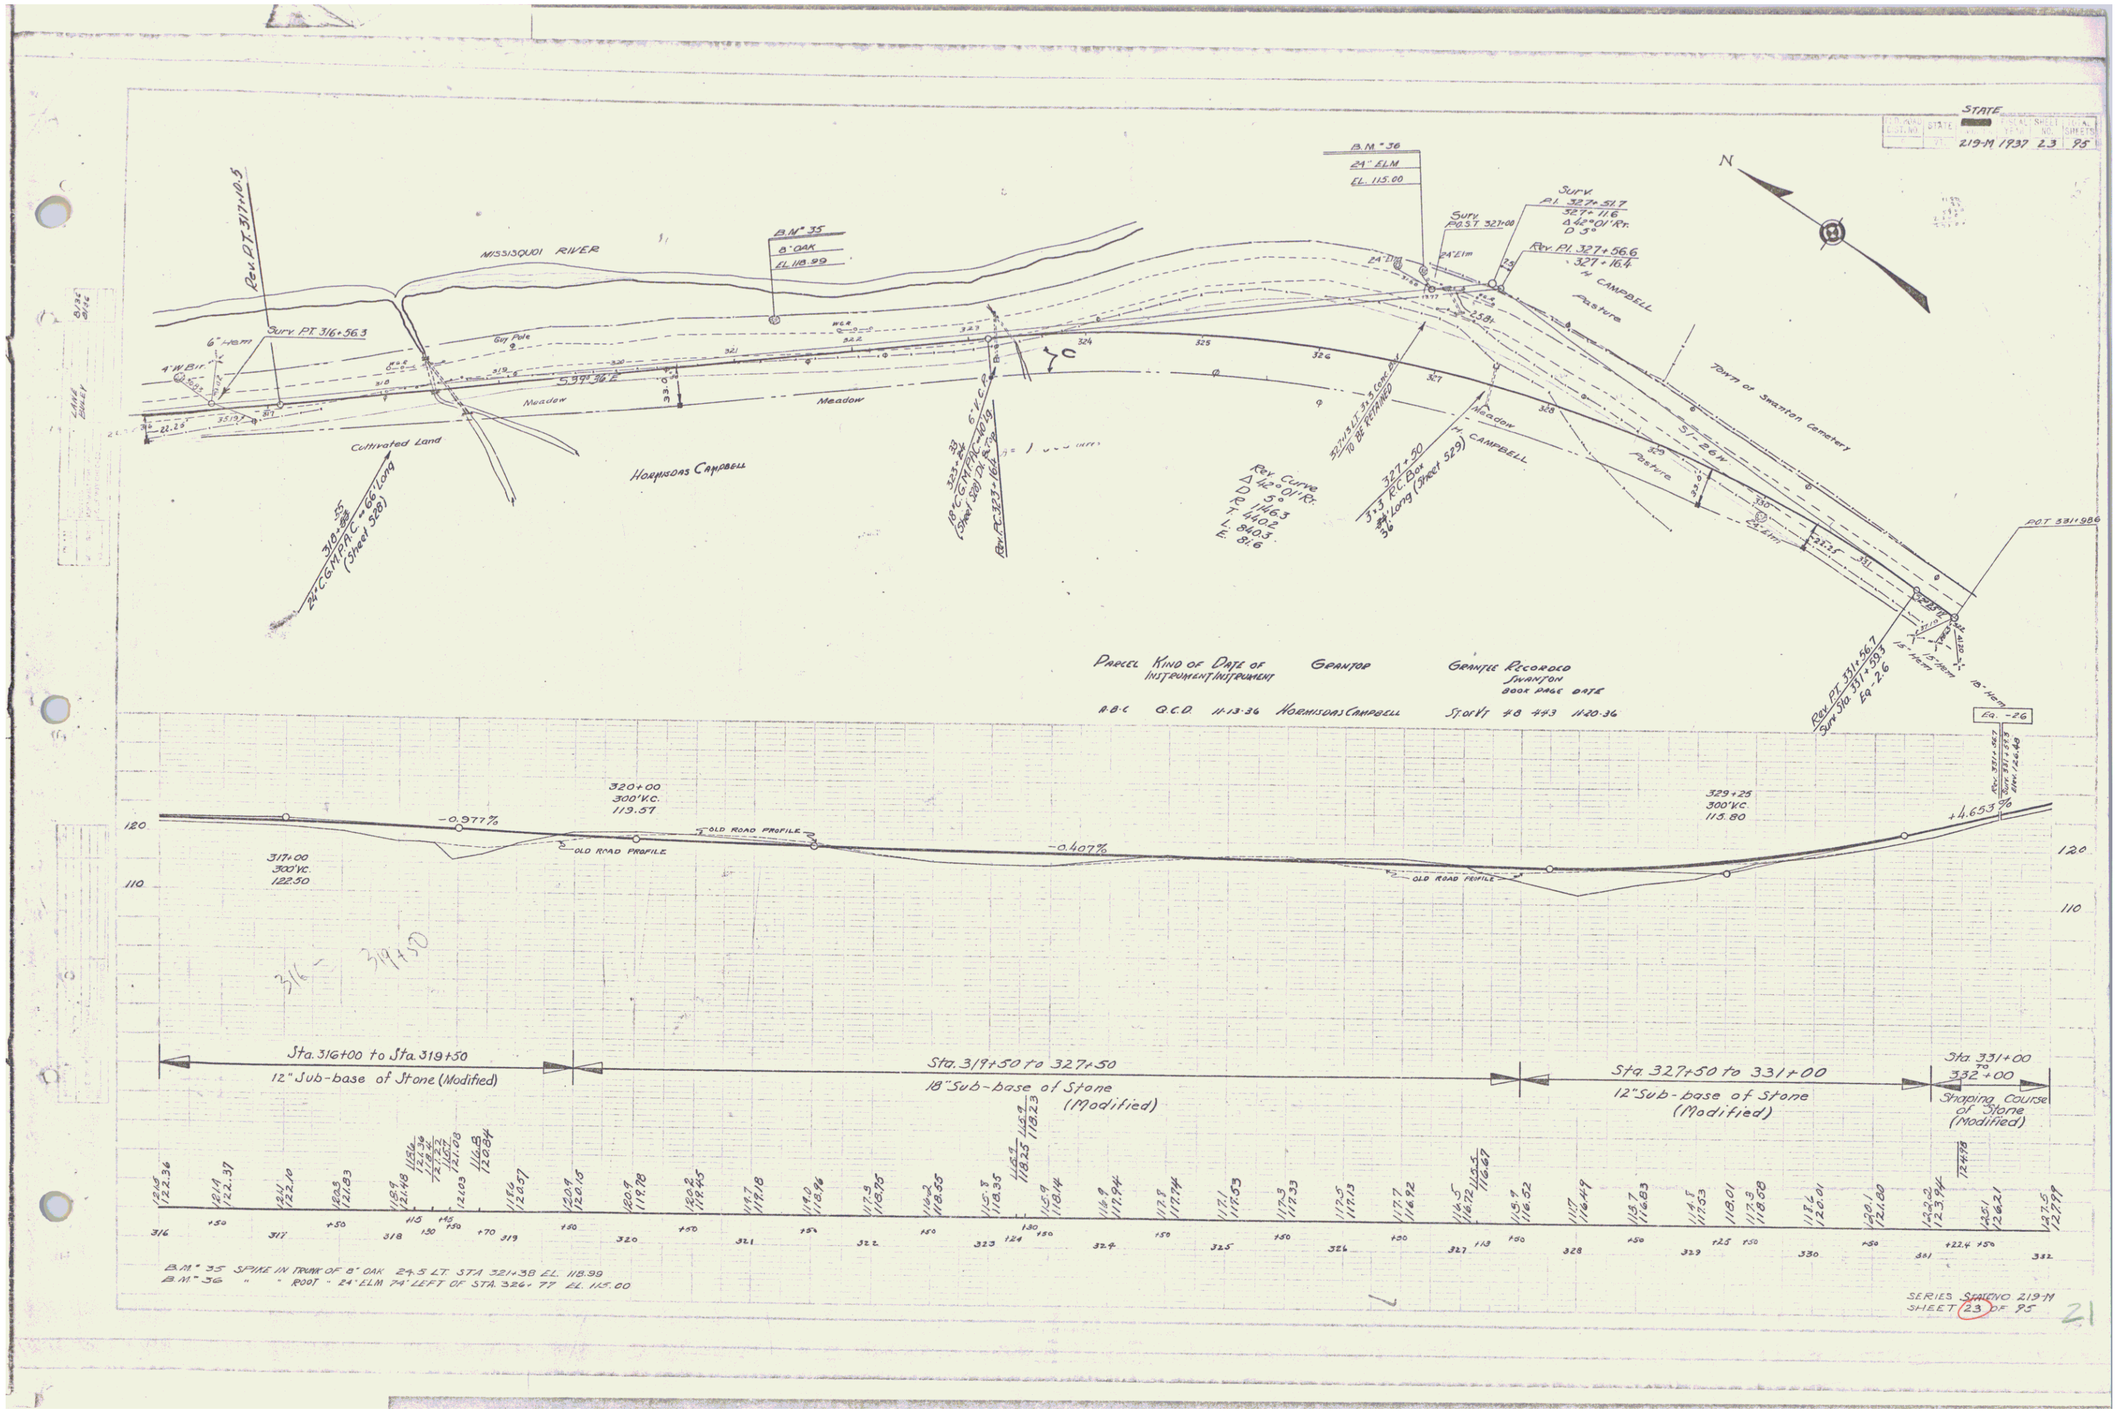
STATE
219-M 1937 23 95
MISSISQUOI RIVER
Rev. PT. 317+10.5
Surv. PT. 316+56.3
6" Hem
4" W. Bir.
B.M. 35
8" OAK
EL. 118.99
B.M. 36
24" ELM
EL. 115.00
Surv. PI 327+51.7
327+11.6
Δ 42°01' Rt.
D 3°
Surv. PA.S.T. 327+08
Rev. PI. 327+56.6
327+16.4
24" Elm
H. CAMPBELL
Pasture
Town of Swanton Cemetery
Guy Pole
Meadow
Cultivated Land
Horatio Campbell
S 39° 36' E
Rev. Curve
Δ 42°01' Rt.
D 3°
R 1463
T 840.3
L 1460.2
E 81.6
Rev. PT. 331+98.6
Rev. PT. 331+56.7
Surv. Sta. 331+53.3
Eq. 2.6
Eq. -26
Rev. PI. 331+53.5
Surv. PI. 331+50.0
Elev. 126.40
15" Hem
Parcel Kind of Deed Date of Instrument Grantor Grantee Recorded Swanton Book Page Date
A.B.C. Q.C.D. 11-13-36 Horatio Campbell State of Vt. 48 443 11-20-36
-0.977%
-0.407%
+4.653%
OLD ROAD PROFILE
320+00
300' V.C.
119.57
317+00
300' V.C.
122.50
329+25
300' V.C.
115.80
120
110
316 - 319+50
Sta. 316+00 to Sta. 319+50
12" Sub-base of Stone (Modified)
Sta. 319+50 to 327+50
18" Sub-base of Stone (Modified)
Sta. 327+50 to 331+00
12" Sub-base of Stone (Modified)
Sta. 331+00 to 332+00
Shaping Course of Stone (Modified)
B.M. 35 SPIKE IN TRUNK OF 8" OAK 24.5 LT. STA. 321+38 EL. 118.99
B.M. 36 " " ROOT 24" ELM 74' LEFT OF STA. 326+77 EL. 115.00
SERIES STATE NO. 219-M
SHEET 23 OF 95