			WPSO		
9	VT.	201 A	1956	6	14

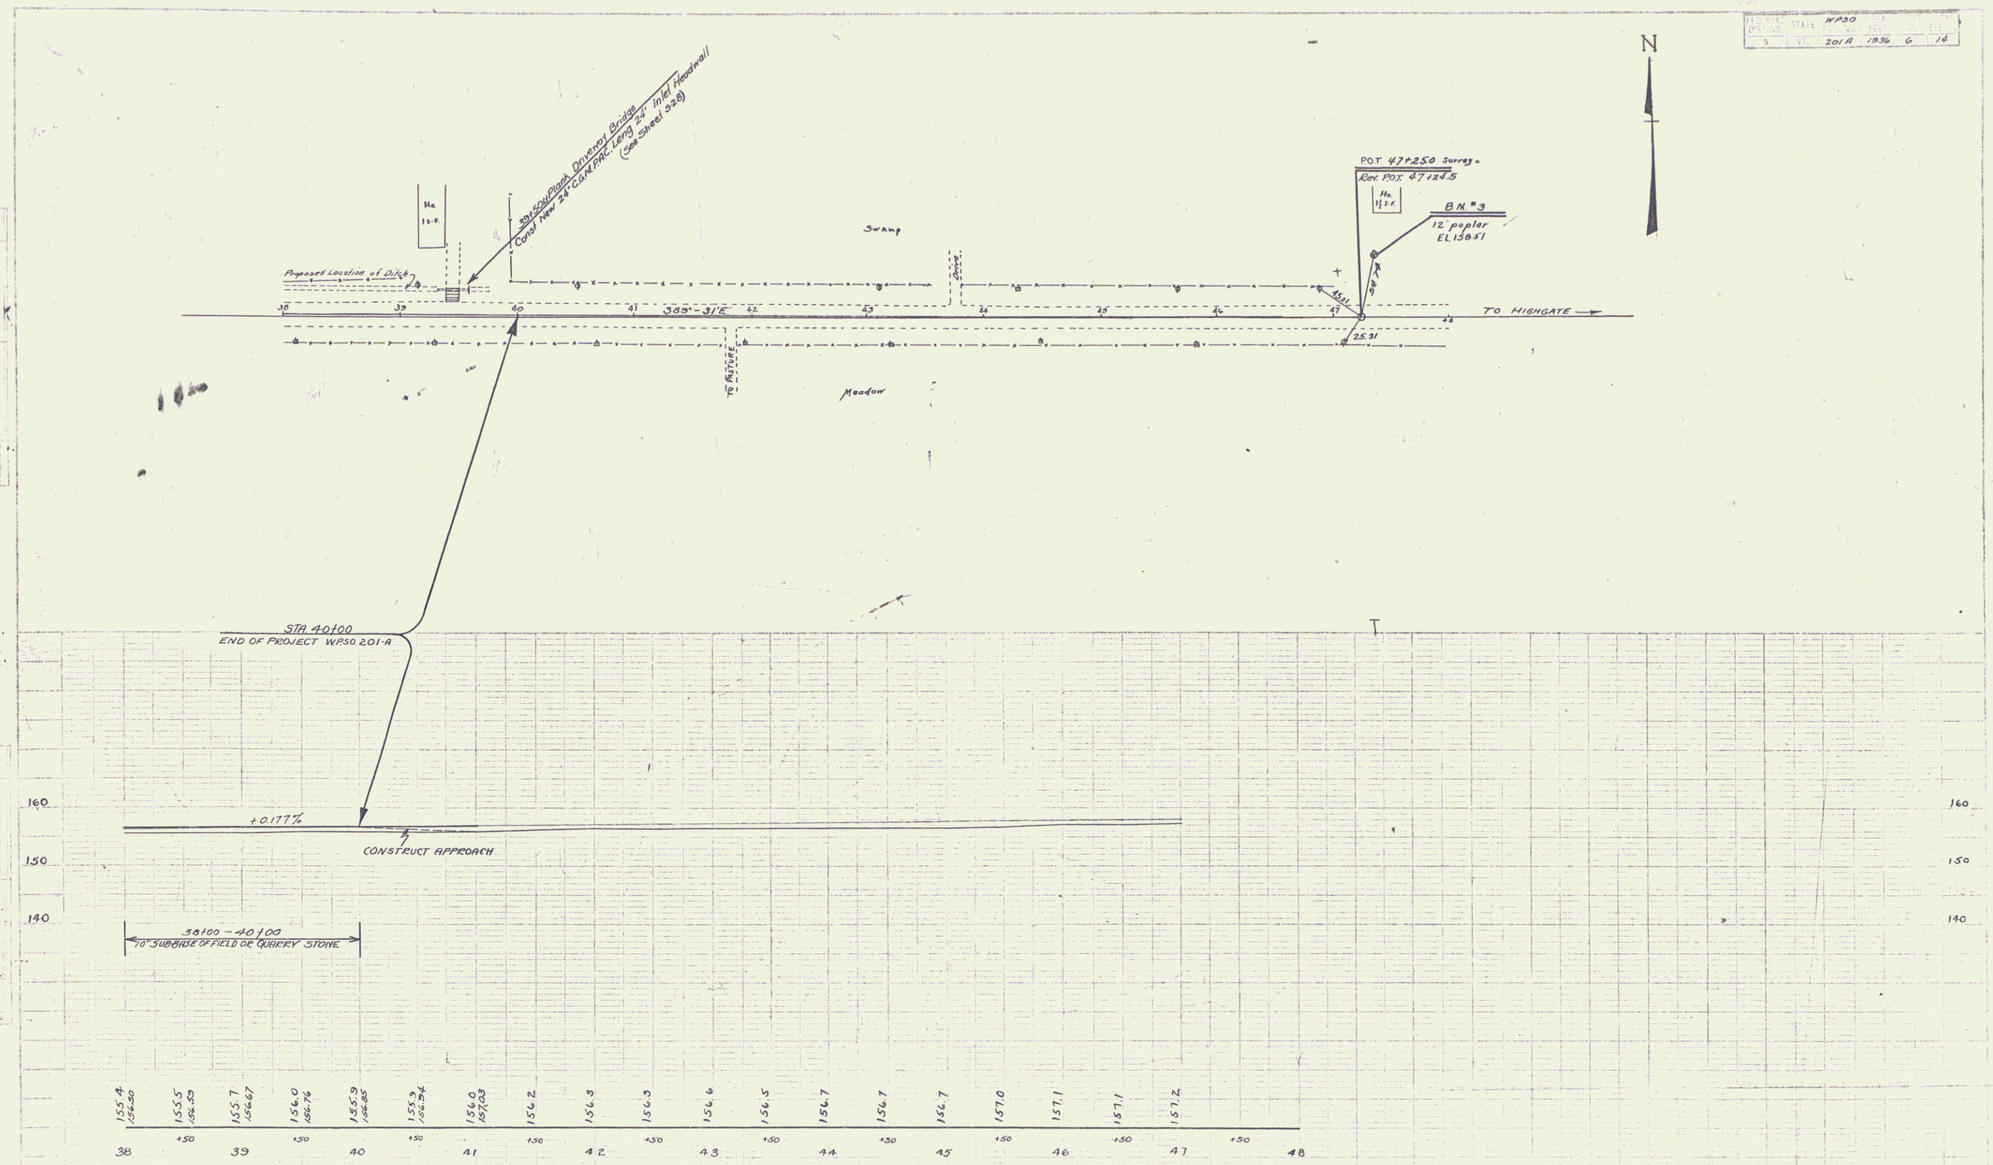

B.M. #3 ~ Spike in root of 12" poplar 52' left 47+36. Elev. = 158.51

SERIES WPSO No 201A
SHEET 6 OF 14

4