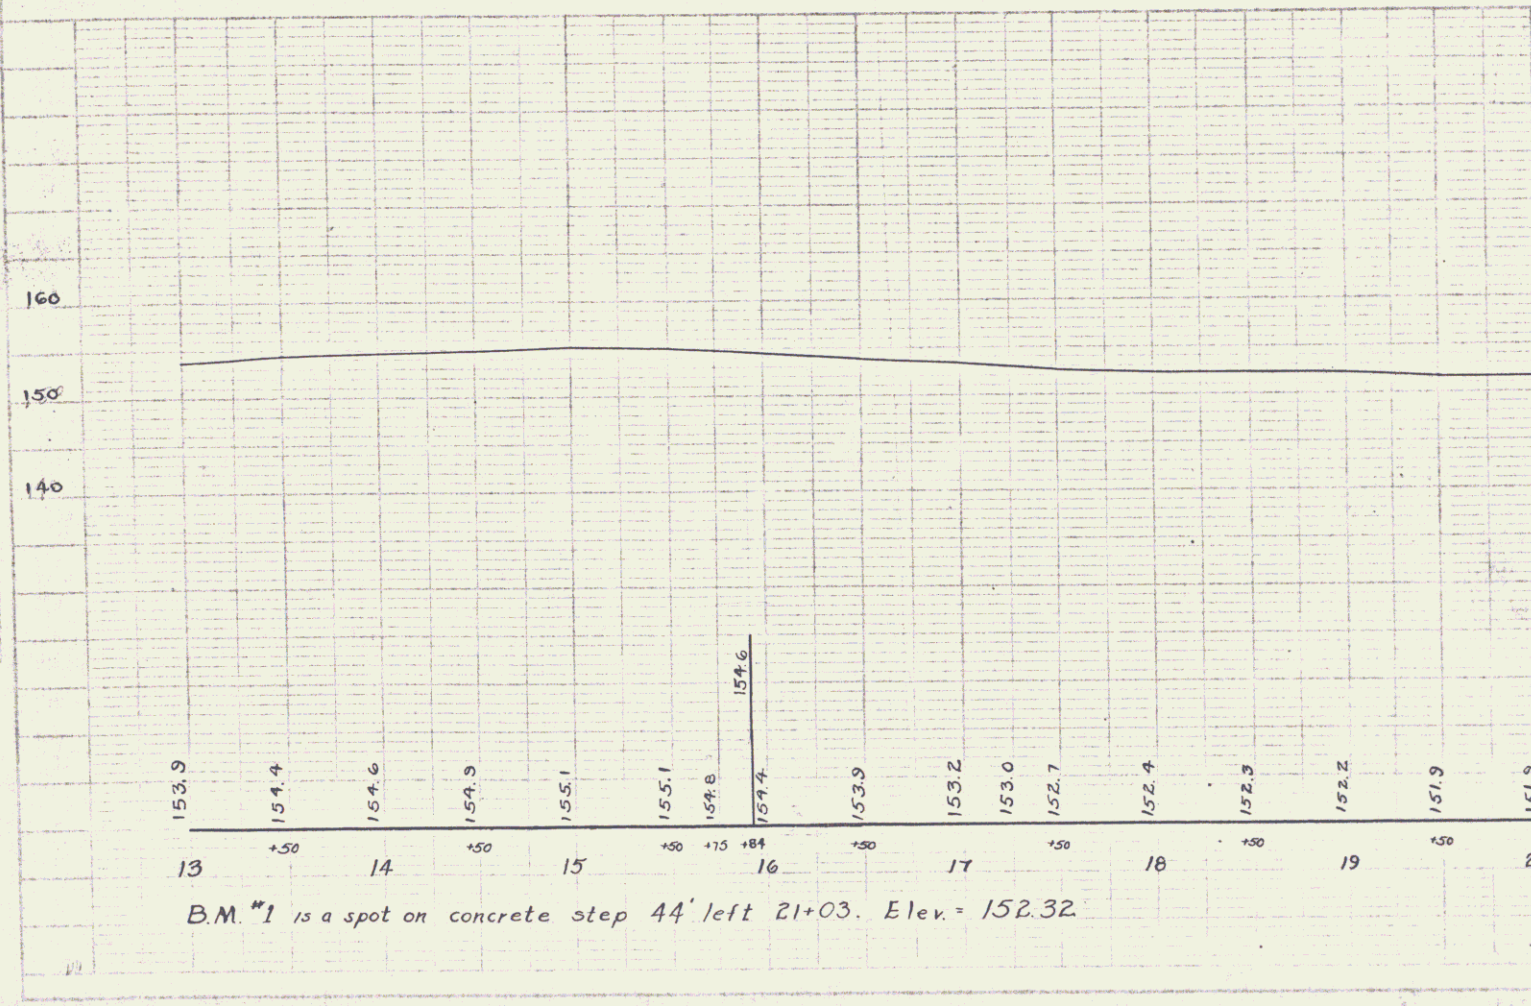

B.M. #1 is a spot on concrete step 44' left 21+03. Elev. = 152.32

Atram
Williams

8/29/85
9/14/85