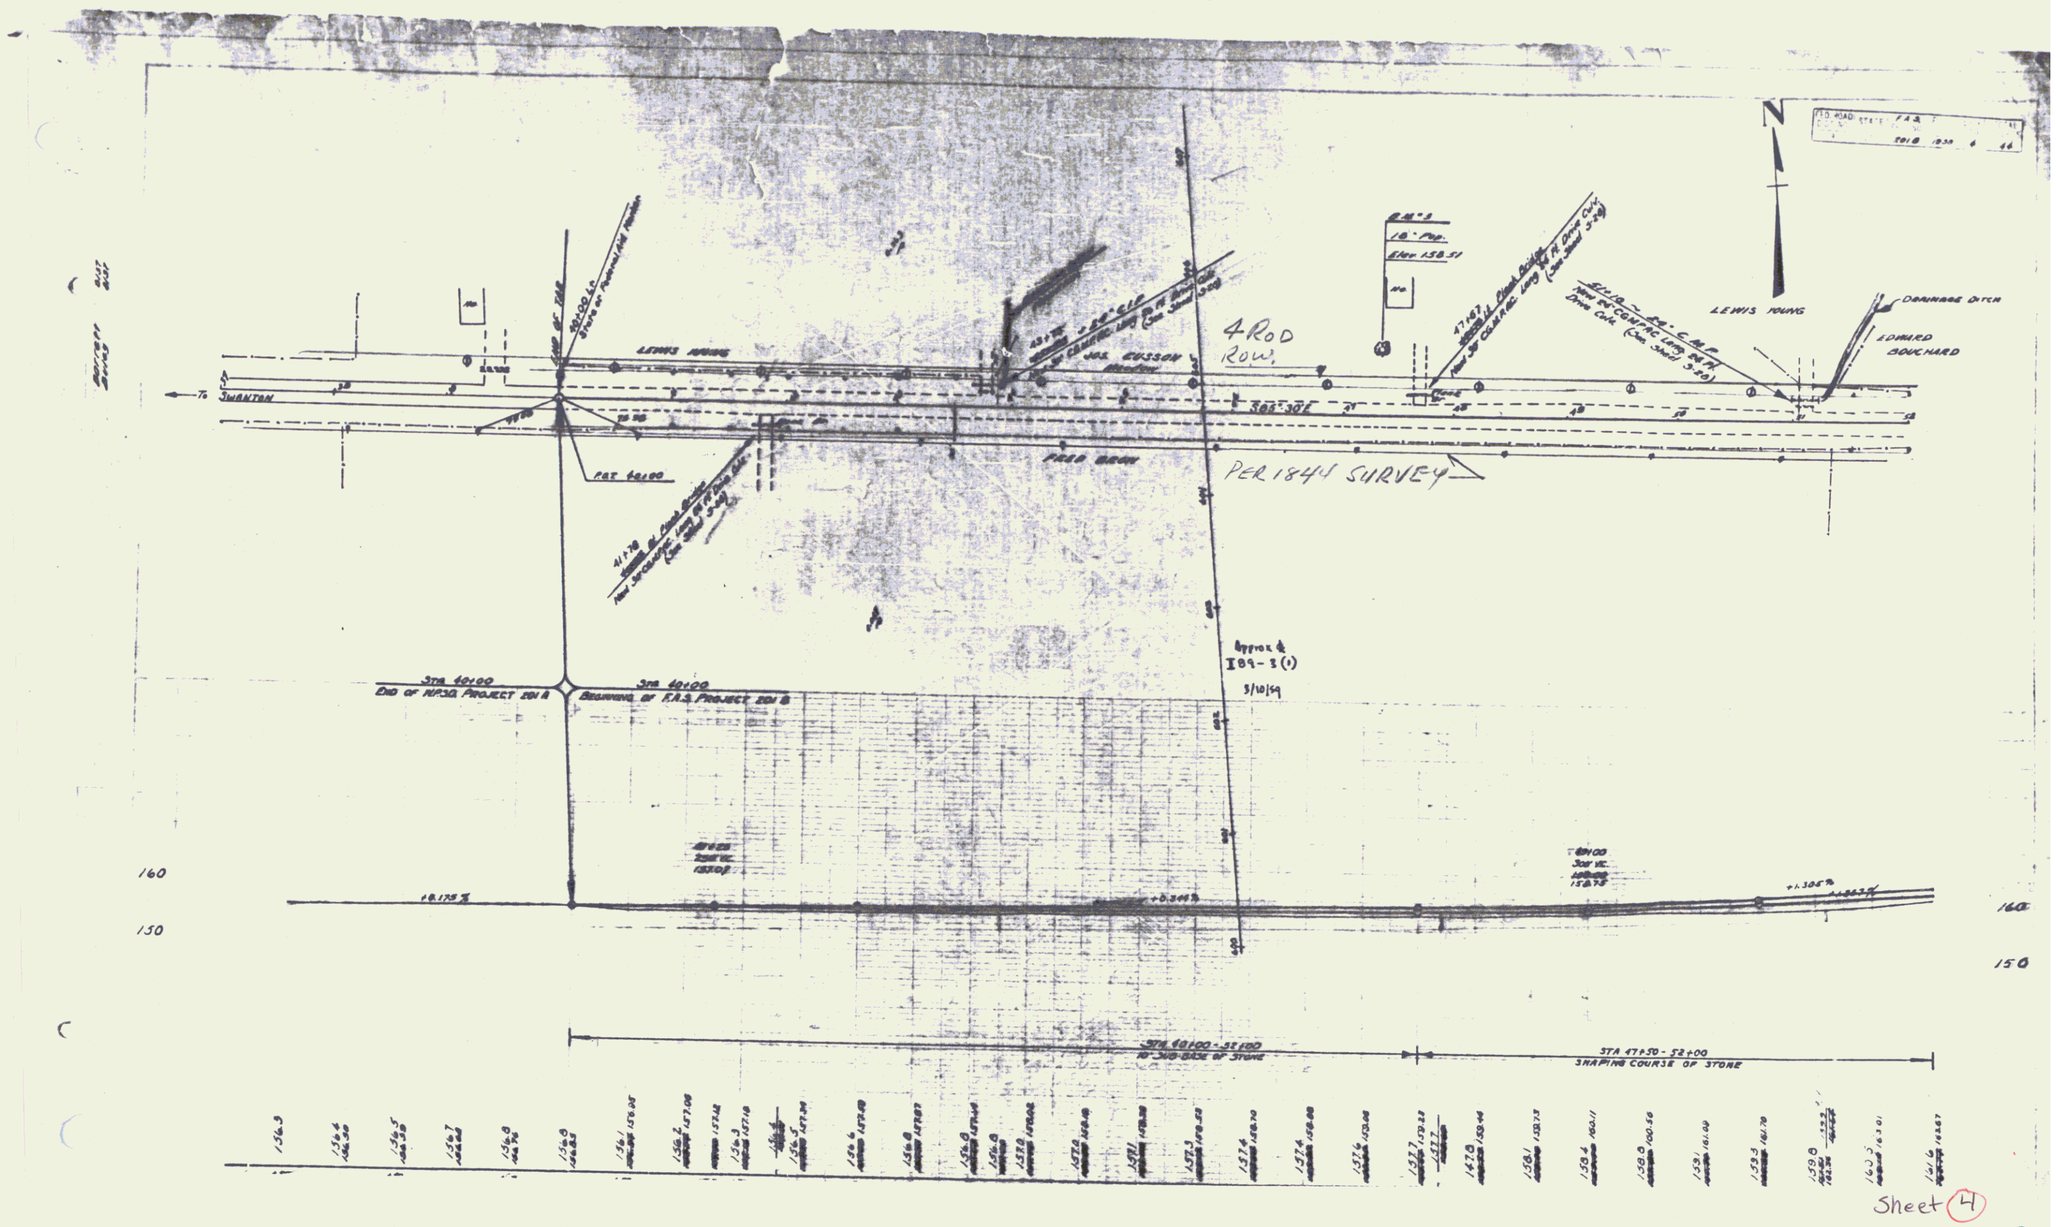
LEWIS YOUNG
SWANTON
JOS. GUSSON
FRED BROWN
4 ROD ROW
PER 1844 SURVEY
LEWIS YOUNG
DRAINAGE DITCH
EDWARD BOUCHARD
N
STA 40+00
END OF NPSD PROJECT 201 A
STA 40+00
BEGINNING OF F.A.S. PROJECT 201 B
Approx ℄
I 89-3(1)
3/10/59
160
150
STA 40+00 - 51+00
TO SHOULDER OF STONE
STA 47+50 - 52+00
SHAPING COURSE OF STONE
Sheet 4