


PLAN
 DRAWN BY
 CHECKED BY
 DATE
 SHEET NO.

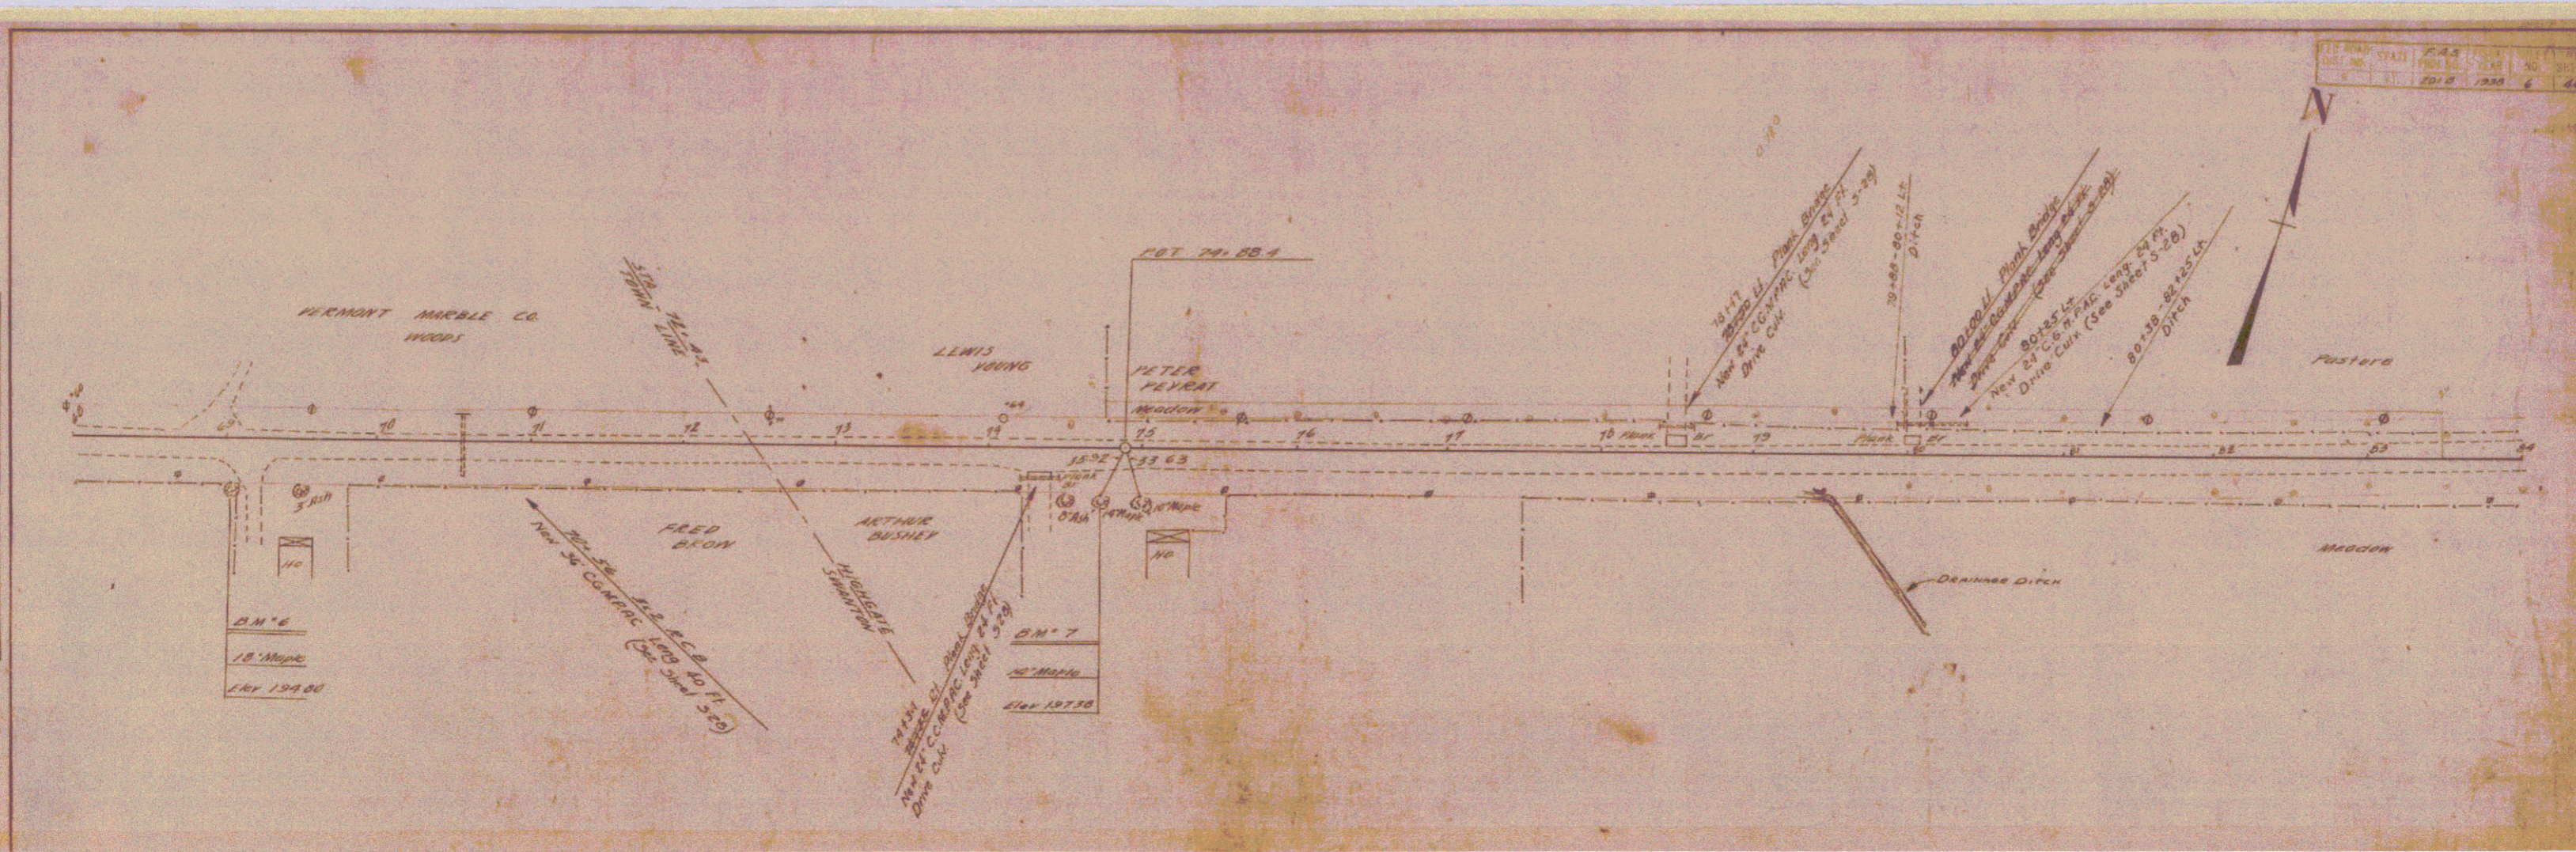

Sheet 6
 4