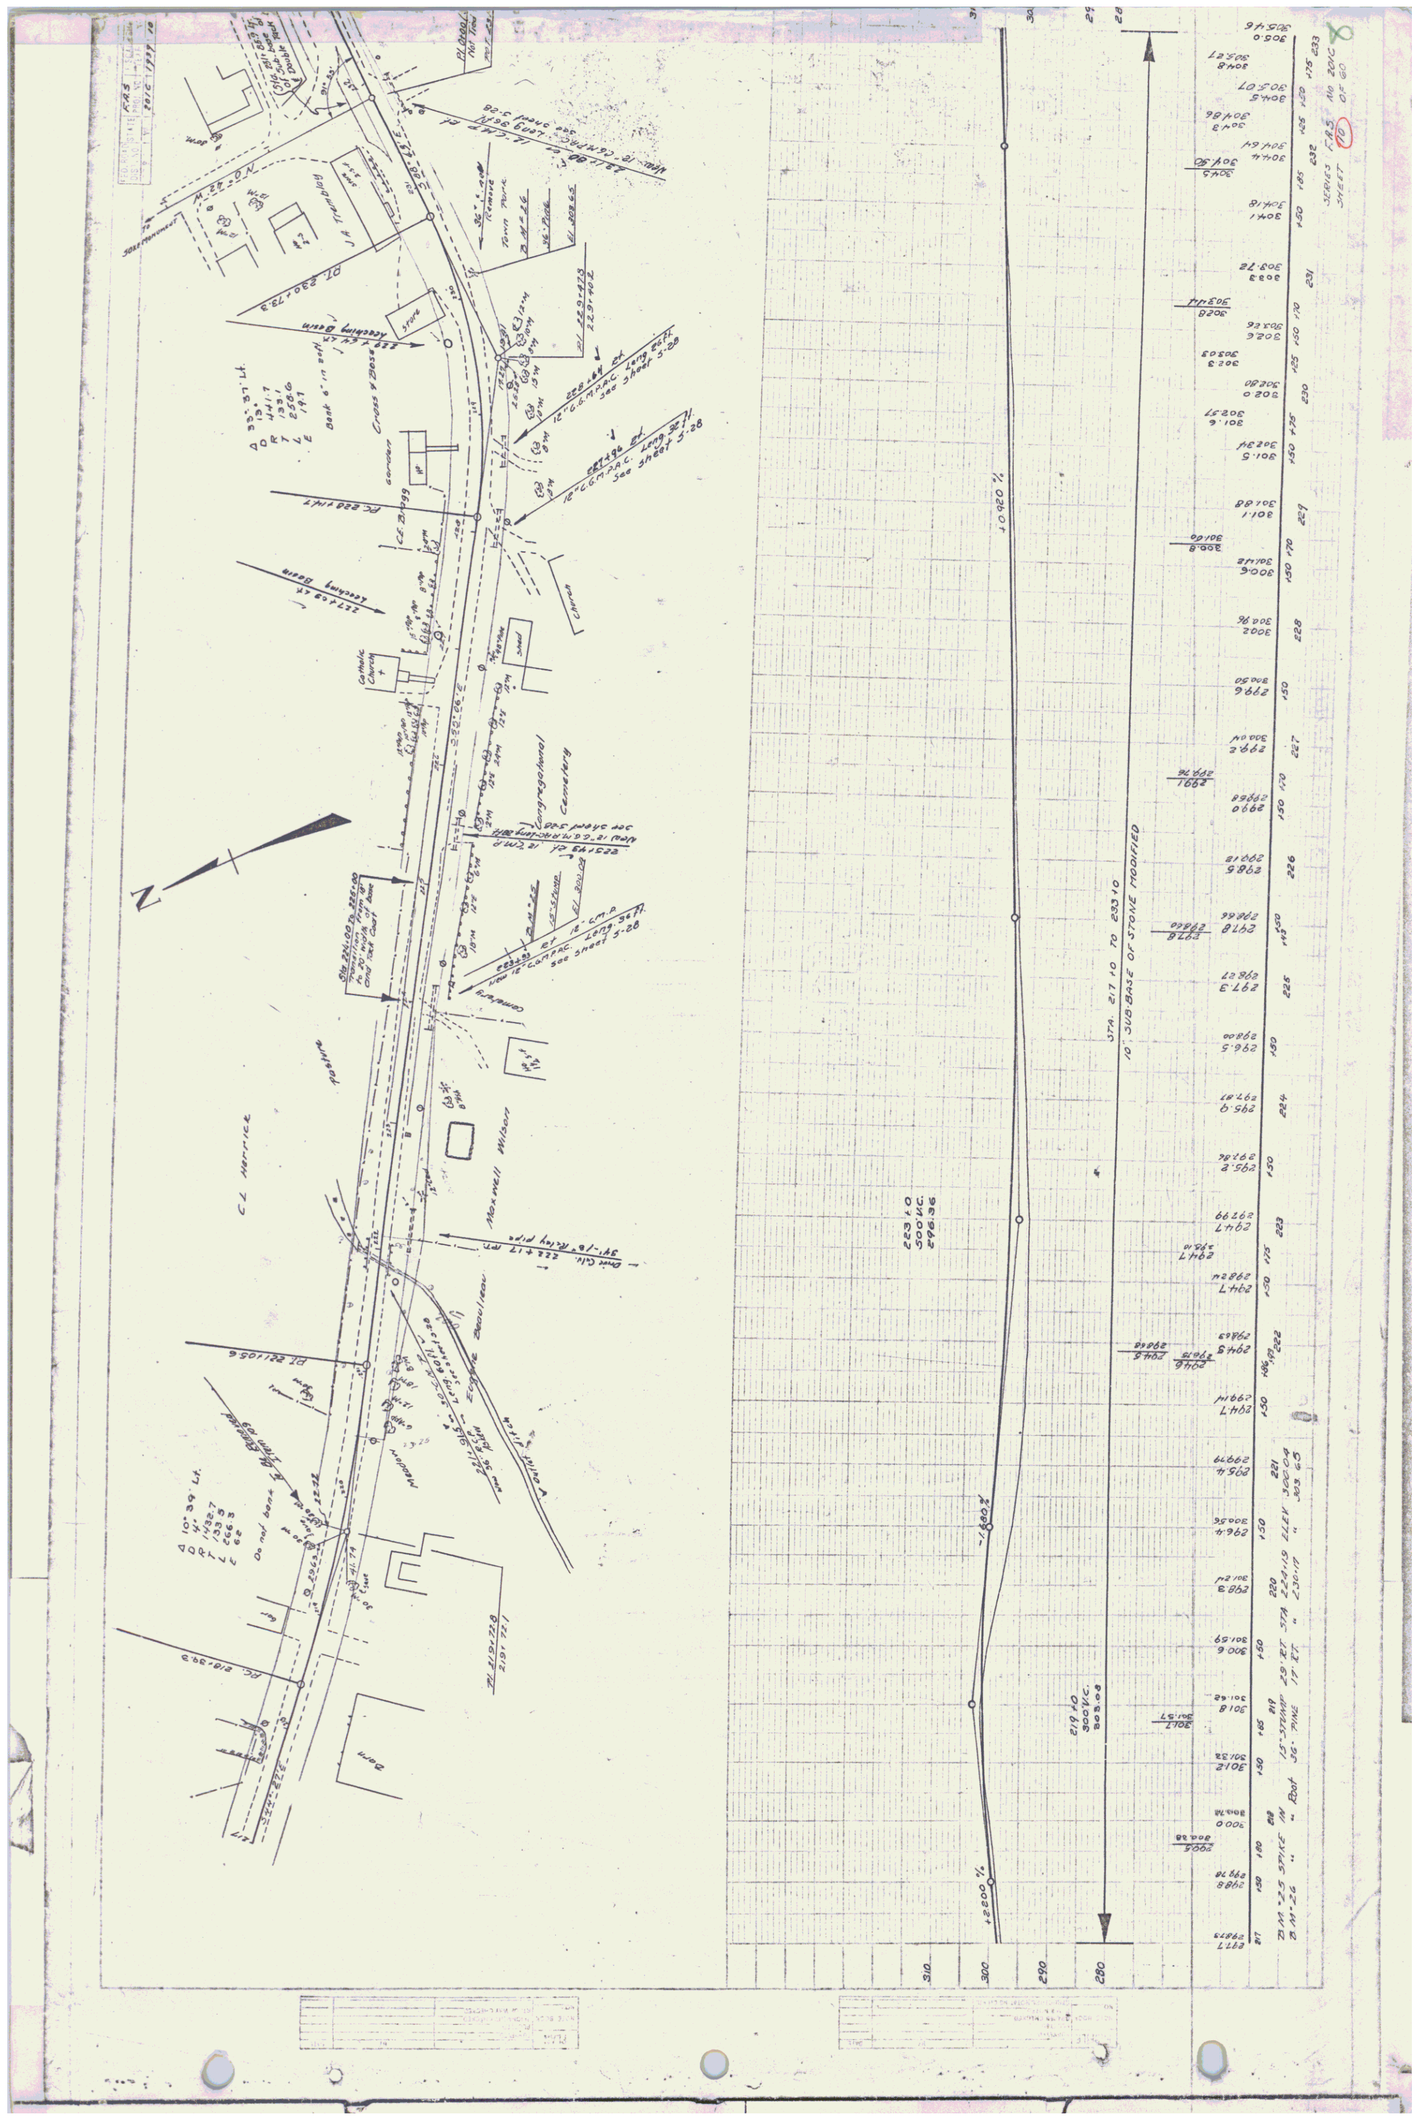
Cemetery
Maxwell Wilson
Cross & Bros
Accoring Basin
Catholic Church
Canal
Dam
Town Pump
Residence
Barn
Sand
Stone
Gender
