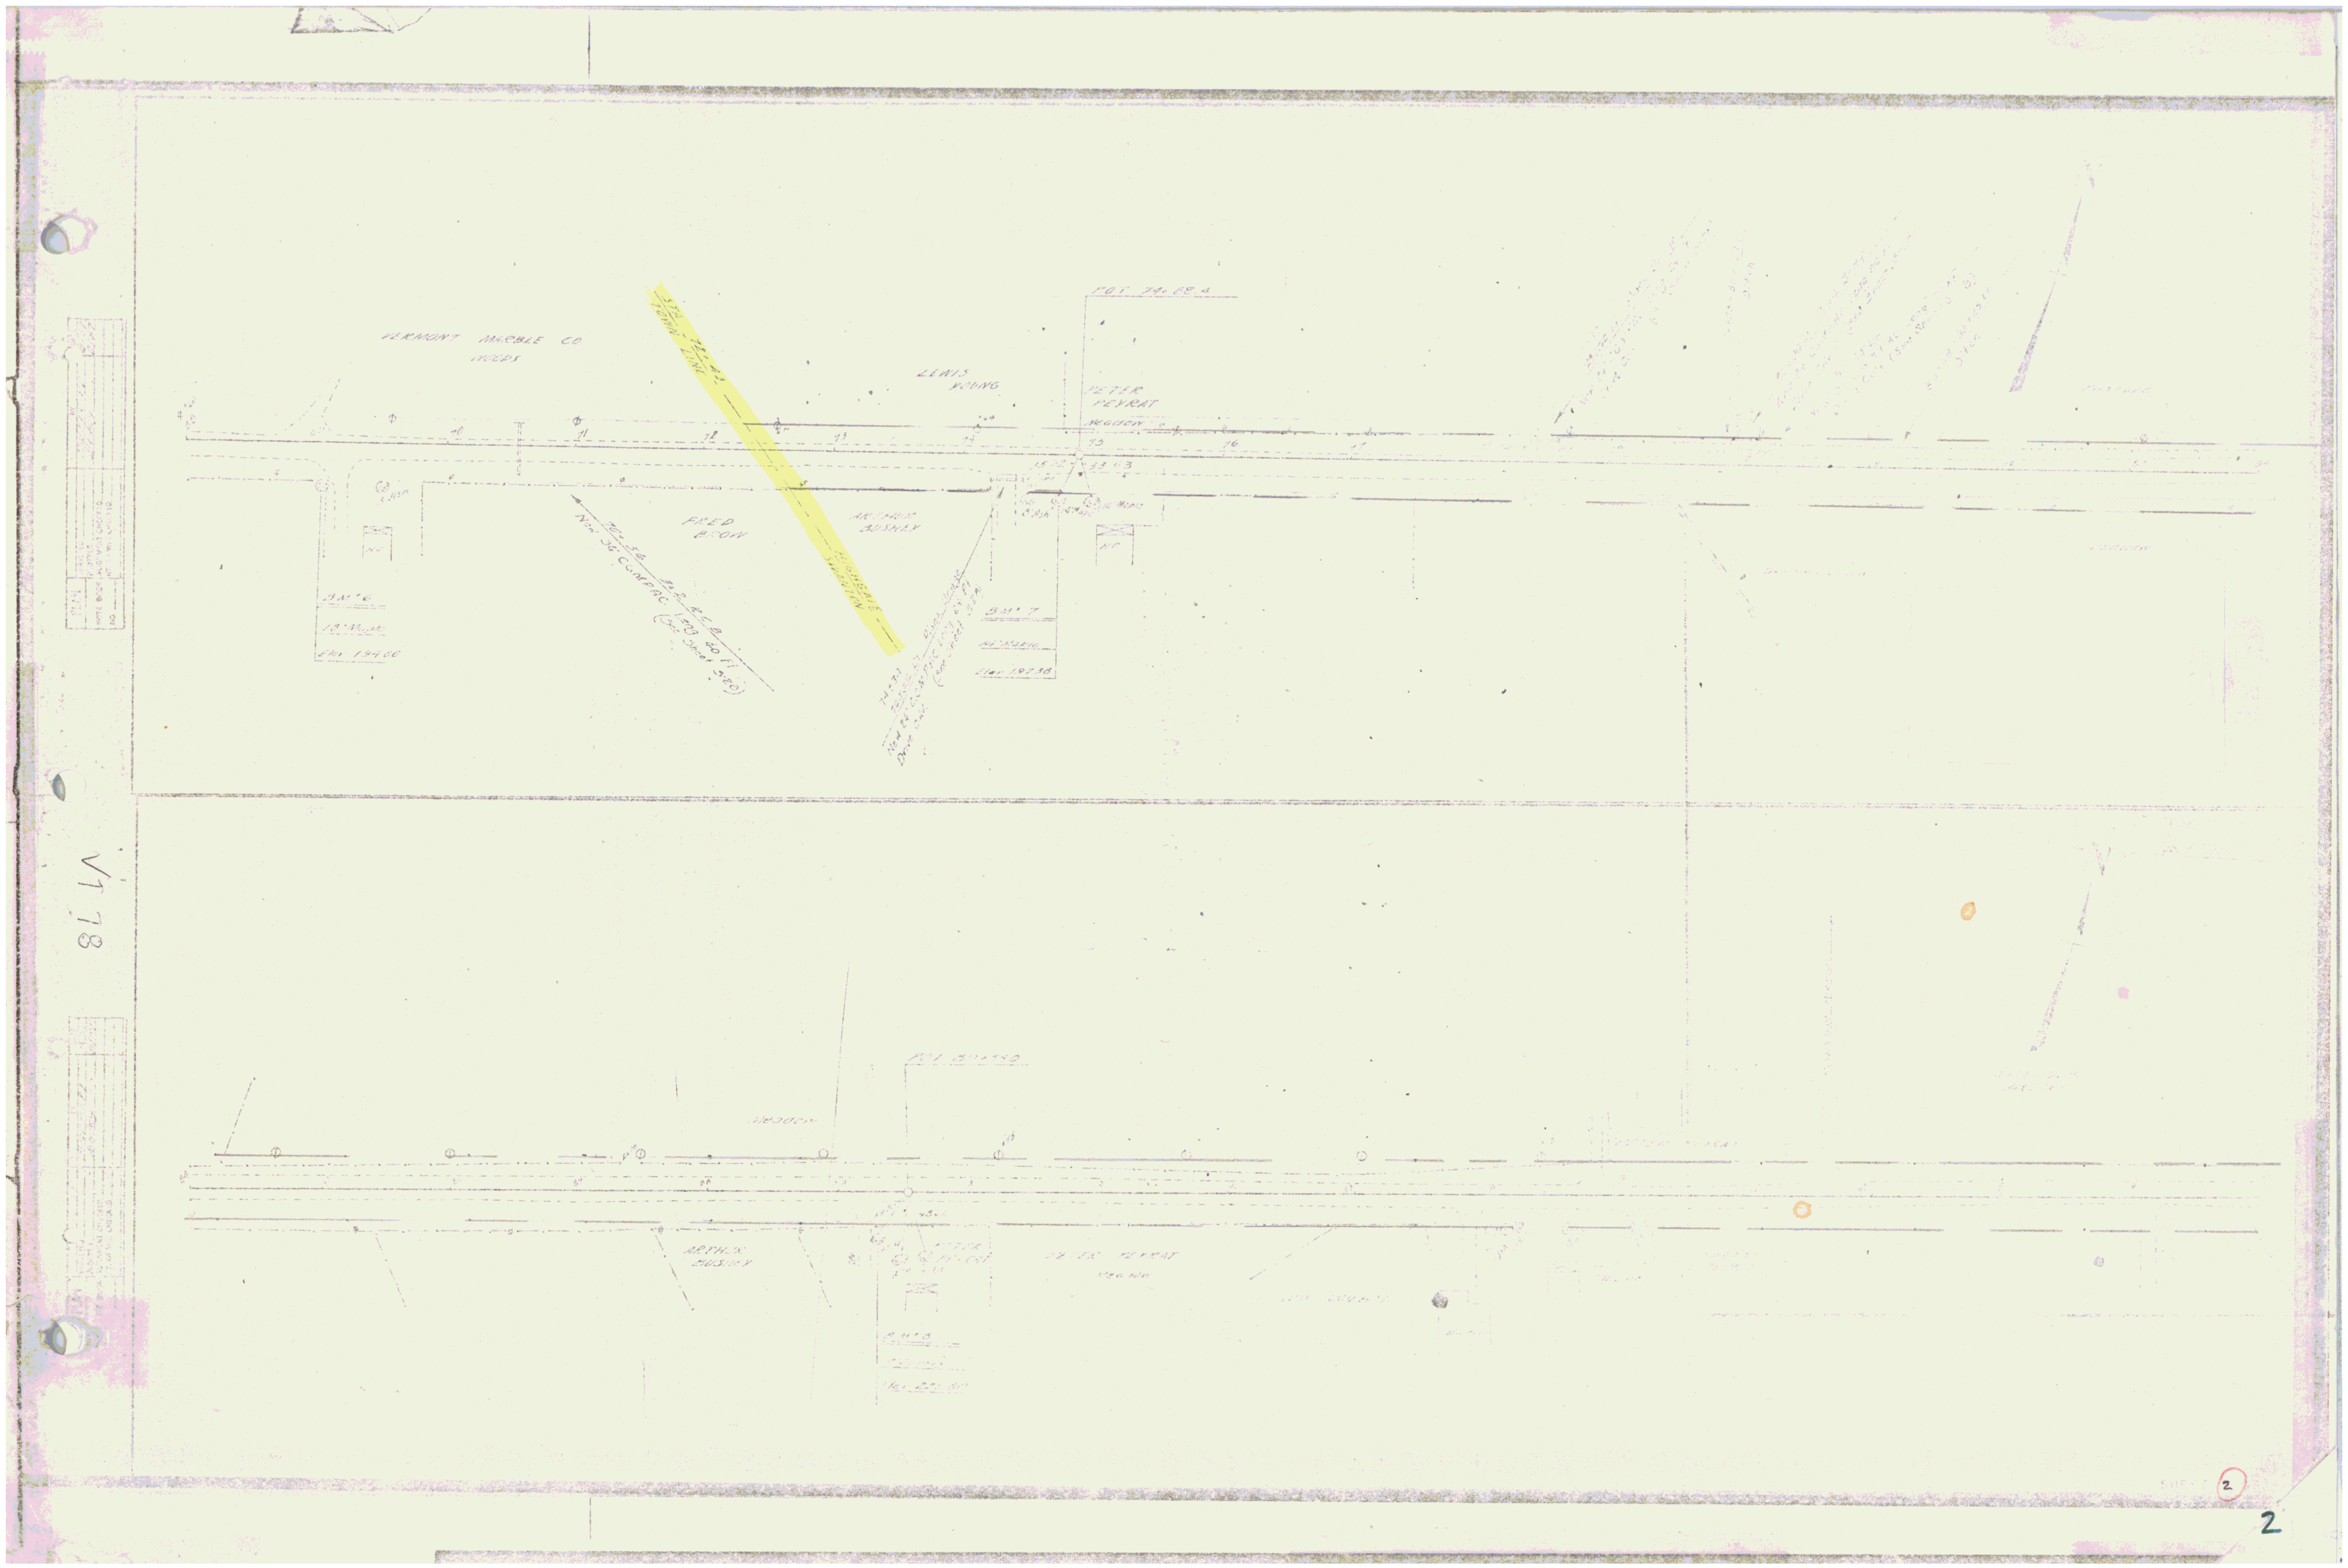
VERMONT MARBLE CO
WOODS
LEWIS
YOUNG
PETER
PEYRAT
POT 74+88.4
STA
TOWN LINE
HIGHGATE
SWANTON
FRED
BROW
ARTHUR
BUSHEY
New 36" C.M.PAC.
(See Sheet 3-20)
BM 6
18" Maple
Elev 194.00
BM 7
Elev 197.38
V178
2