POOR ORIGINAL COPY

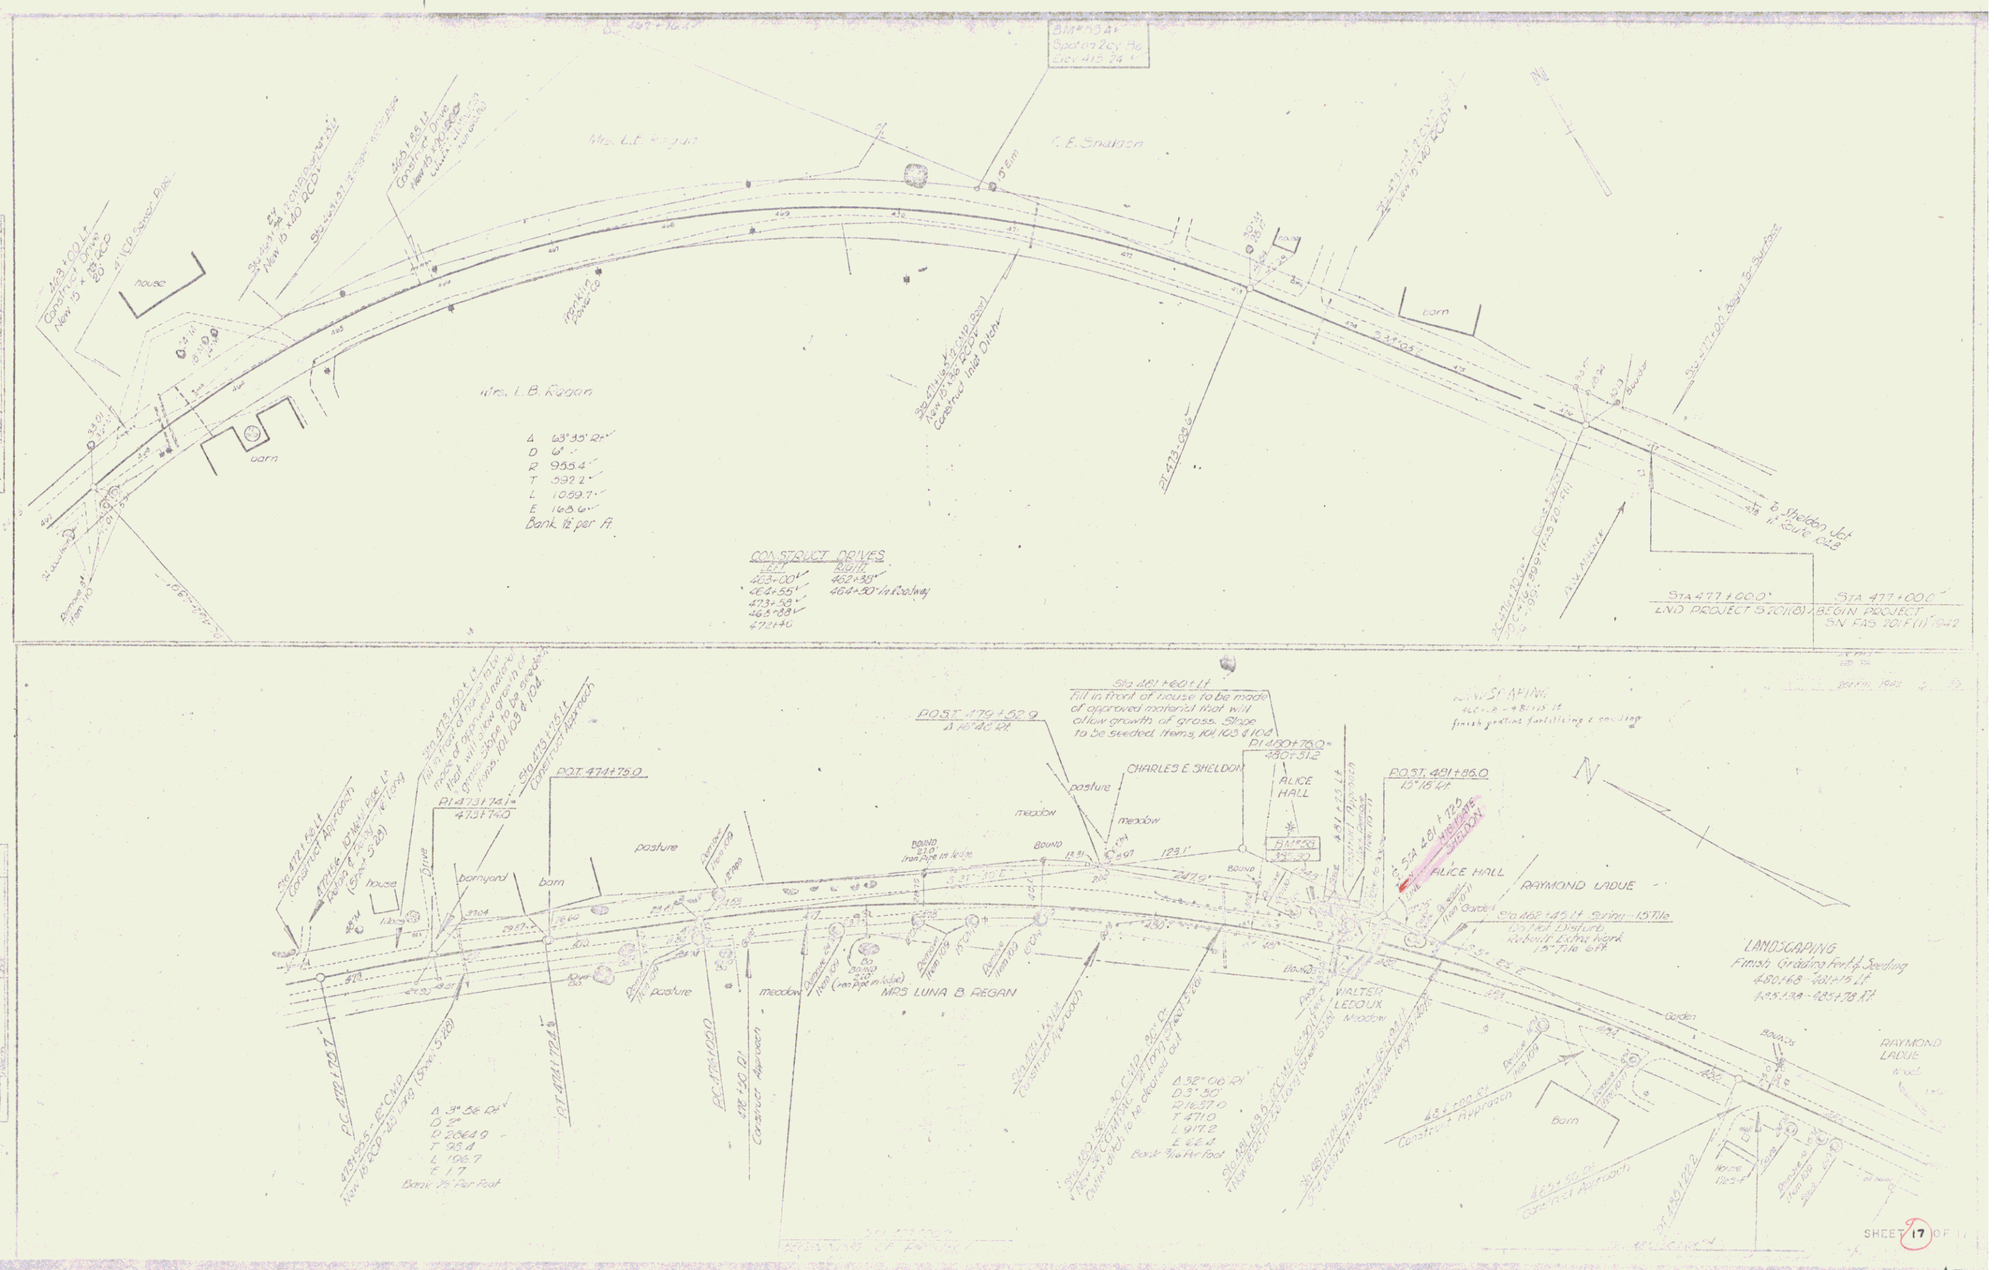

17