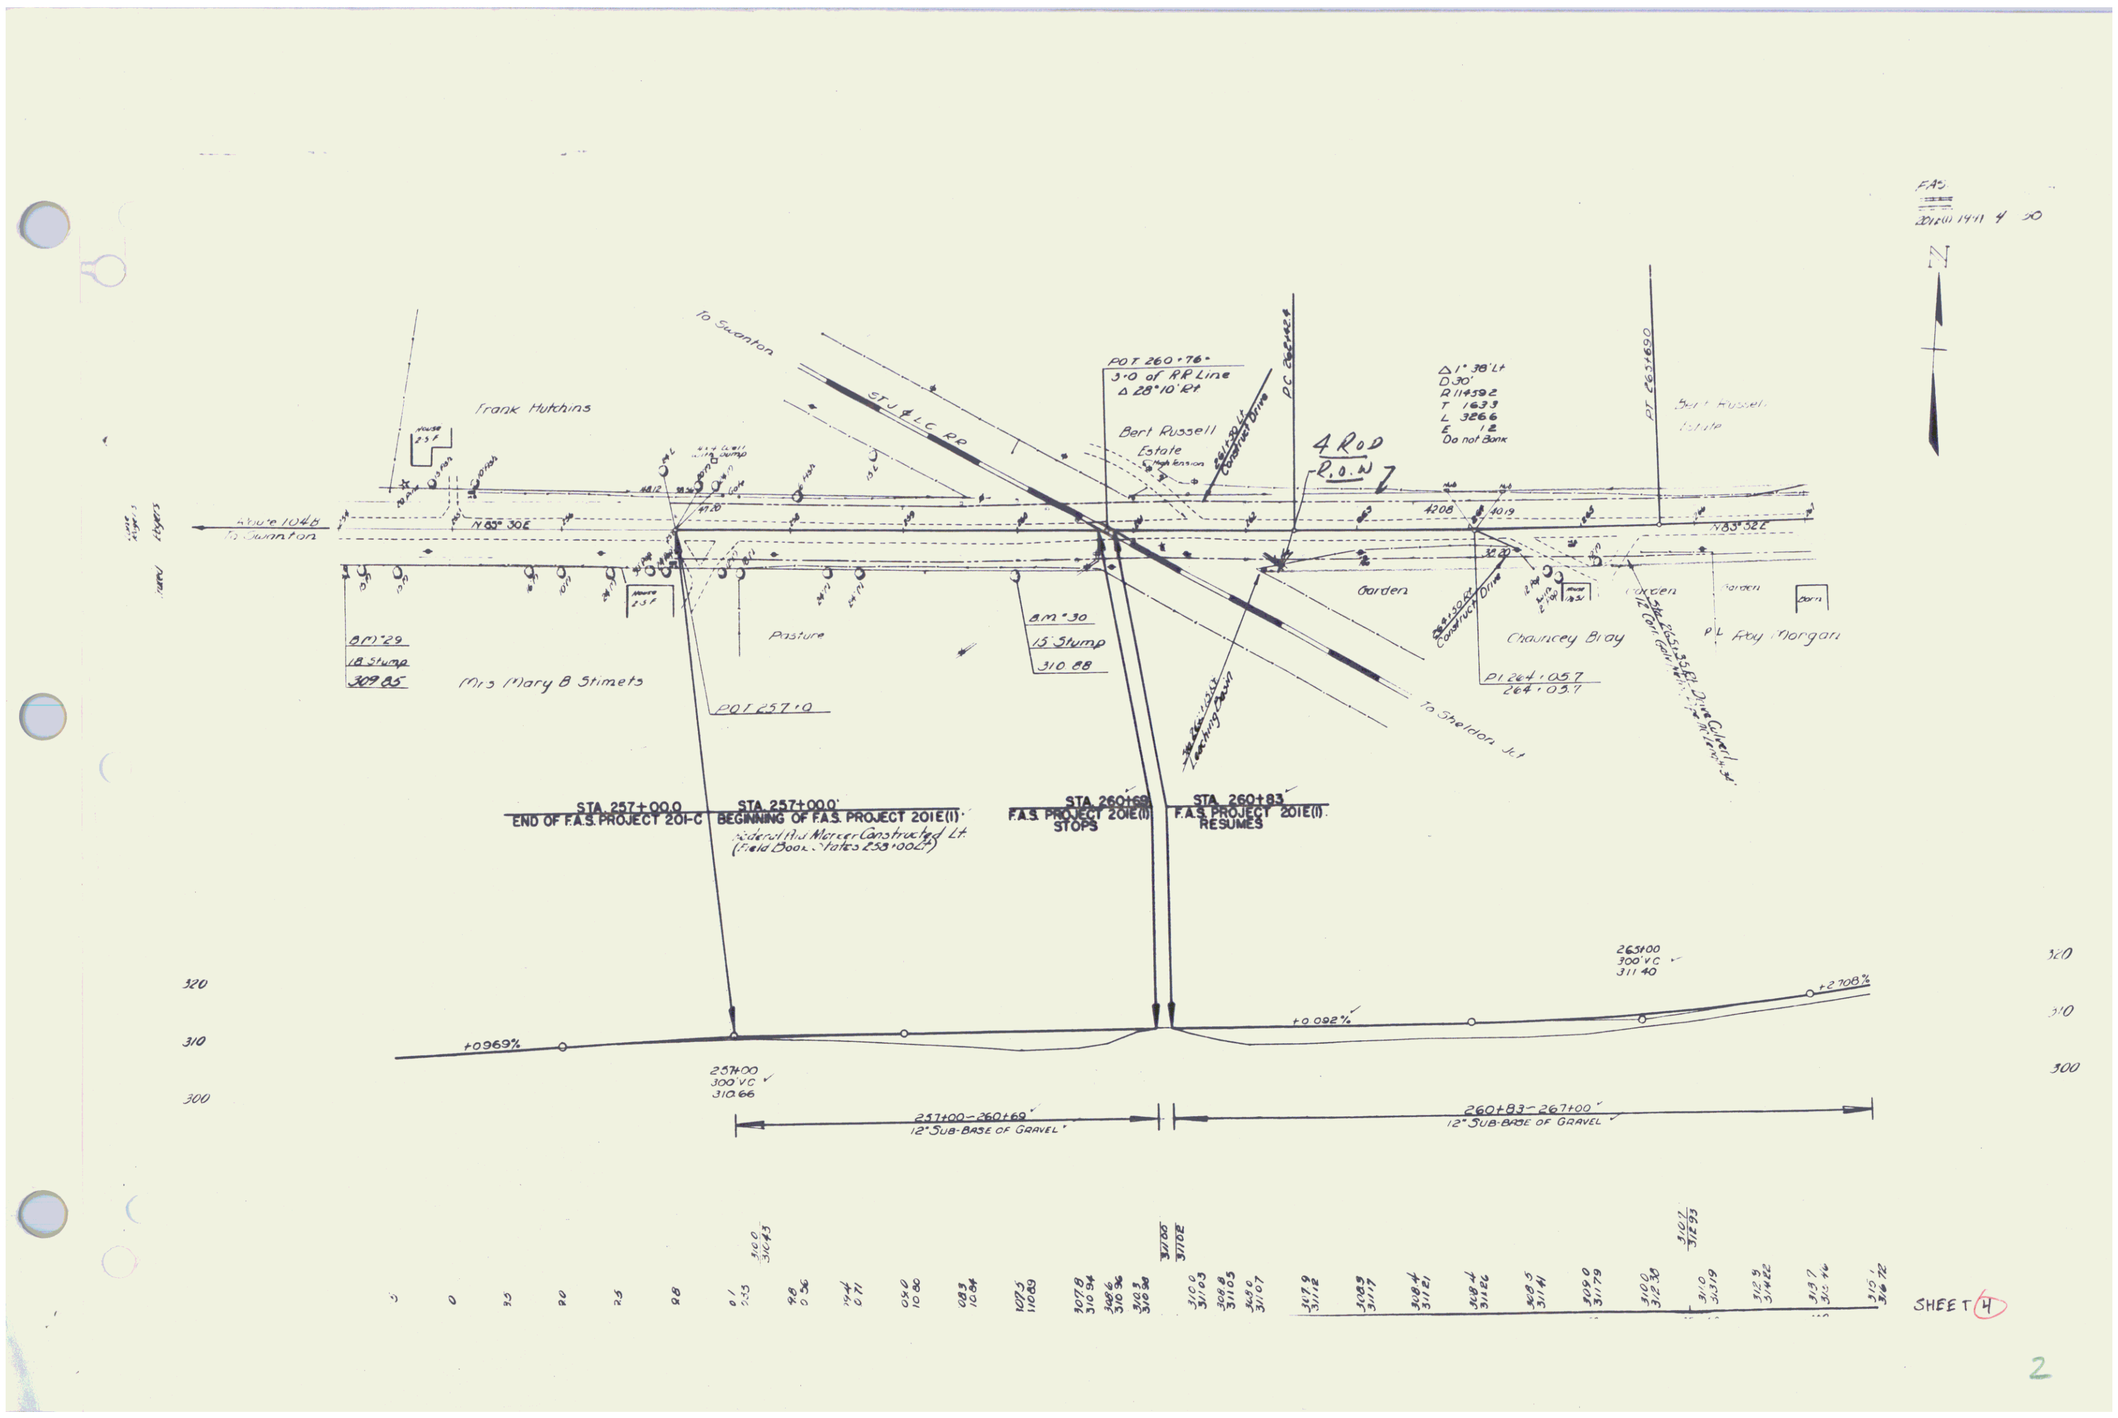
FAS
2011(1) 1411 4 20
N
Frank Hutchins
To Swanton
Route 104B
To Swanton
N 63° 30E
BM 29
18 Stump
309.85
Mrs Mary B Stimets
Pasture
POT 257+0
BM 30
15 Stump
310.88
POT 260+76
3.0 of RR Line
Δ 28°10' Rt
Bert Russell
Estate
Garden
4 ROD
R.O.W.
Δ 1°38' Lt
D 30'
R 1145.92
T 16.33
L 32.66
E 1.2
Do not Bank
4208
4019
N 83° 52E
Chauncey Bray
PI 264+05.7
264+05.7
To Sheldon Jct
STA 257+00.0
END OF F.A.S. PROJECT 201-C
STA 257+00.0
BEGINNING OF F.A.S. PROJECT 201E(1)
(Field Book - Notes 258+00 Lt)
STA 260+69
F.A.S. PROJECT 201E(1)
STOPS
STA 260+83
F.A.S. PROJECT 201E(1)
RESUMES
+0.969%
+0.092%
+2.708%
257+00
300' VC
310.66
263+00
300' VC
311.40
257+00 - 260+69
12" SUB-BASE OF GRAVEL
260+83 - 267+00
12" SUB-BASE OF GRAVEL
320
310
300
SHEET 4

2