FAS
20 DEC 1941 3.50

N

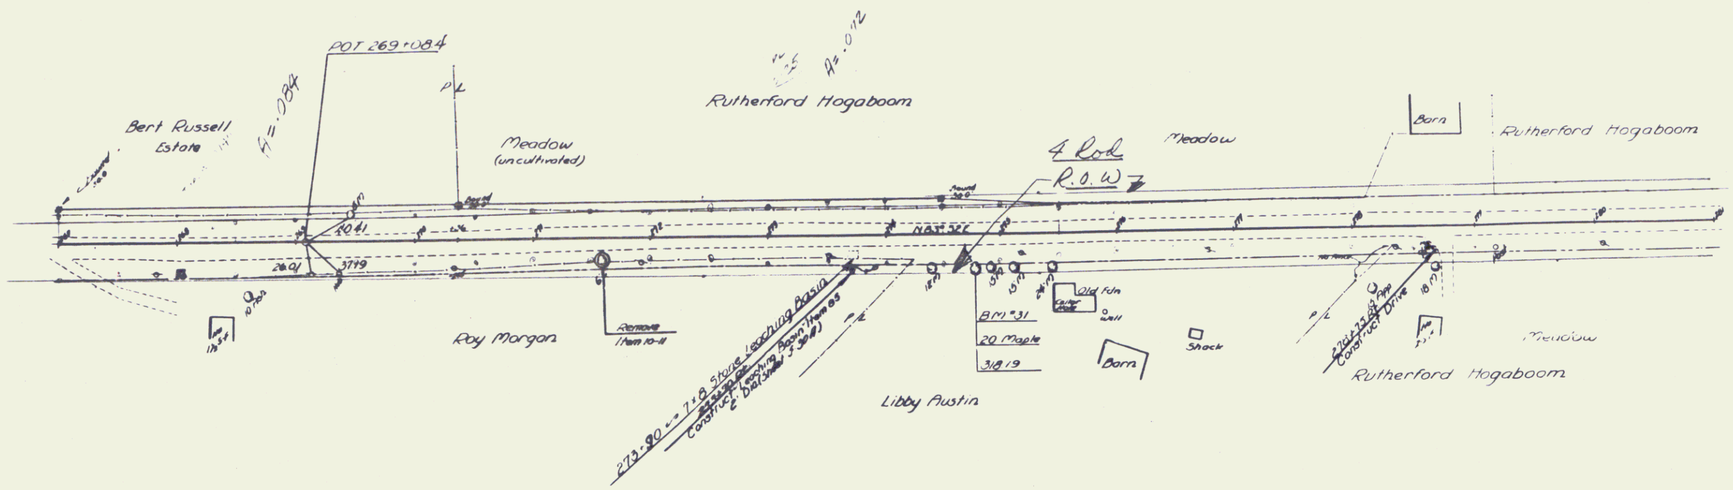

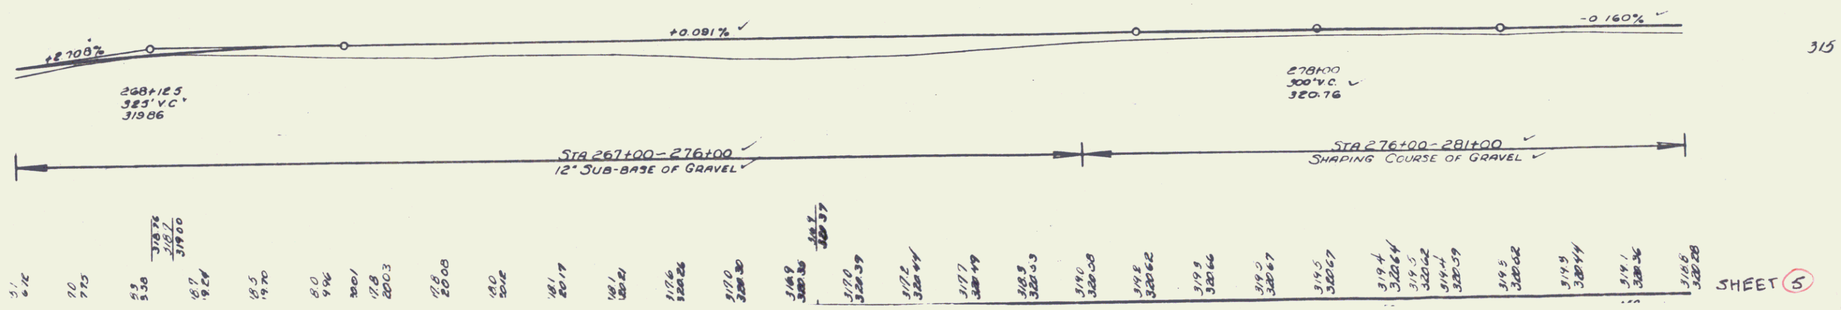

315

315

SHEET 5

3