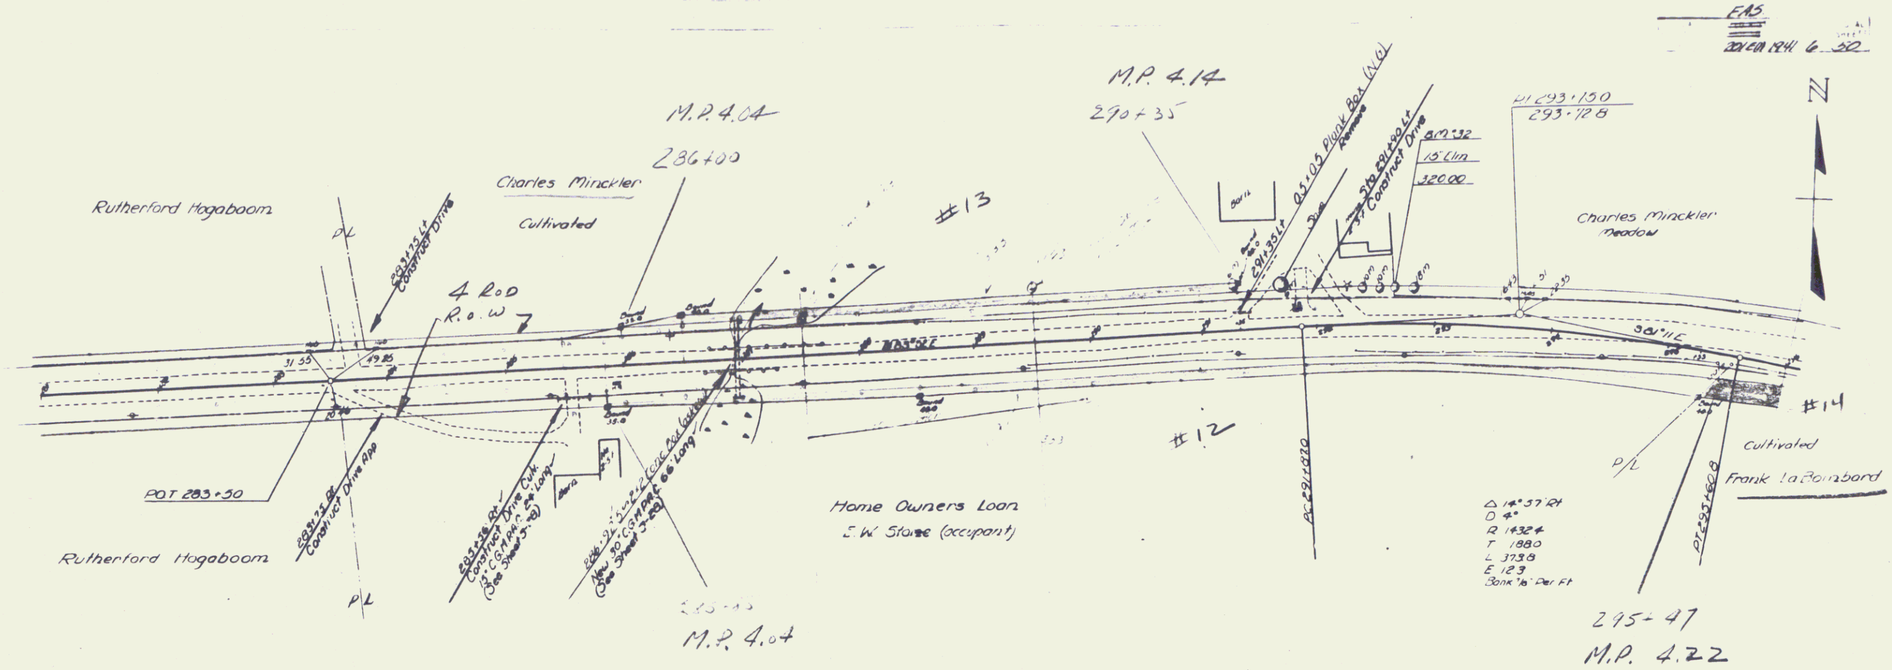
M.P. 4.04
286+00
Charles Minckler
Cultivated
Rutherford Hogaboom
4 Rod
R.o.W
#13
M.P. 4.14
290+35
Charles Minckler
Meadow
#12
#14
Cultivated
Frank la Bombard
Home Owners Loan
E.W. Stone (occupant)
Rutherford Hogaboom
POT 283+50
Construct Drive App
Construct Drive Curb
Construct Drive
Construct Drive Apr
Construct Drive App
Construct Drive
Construct Drive
Construct Drive