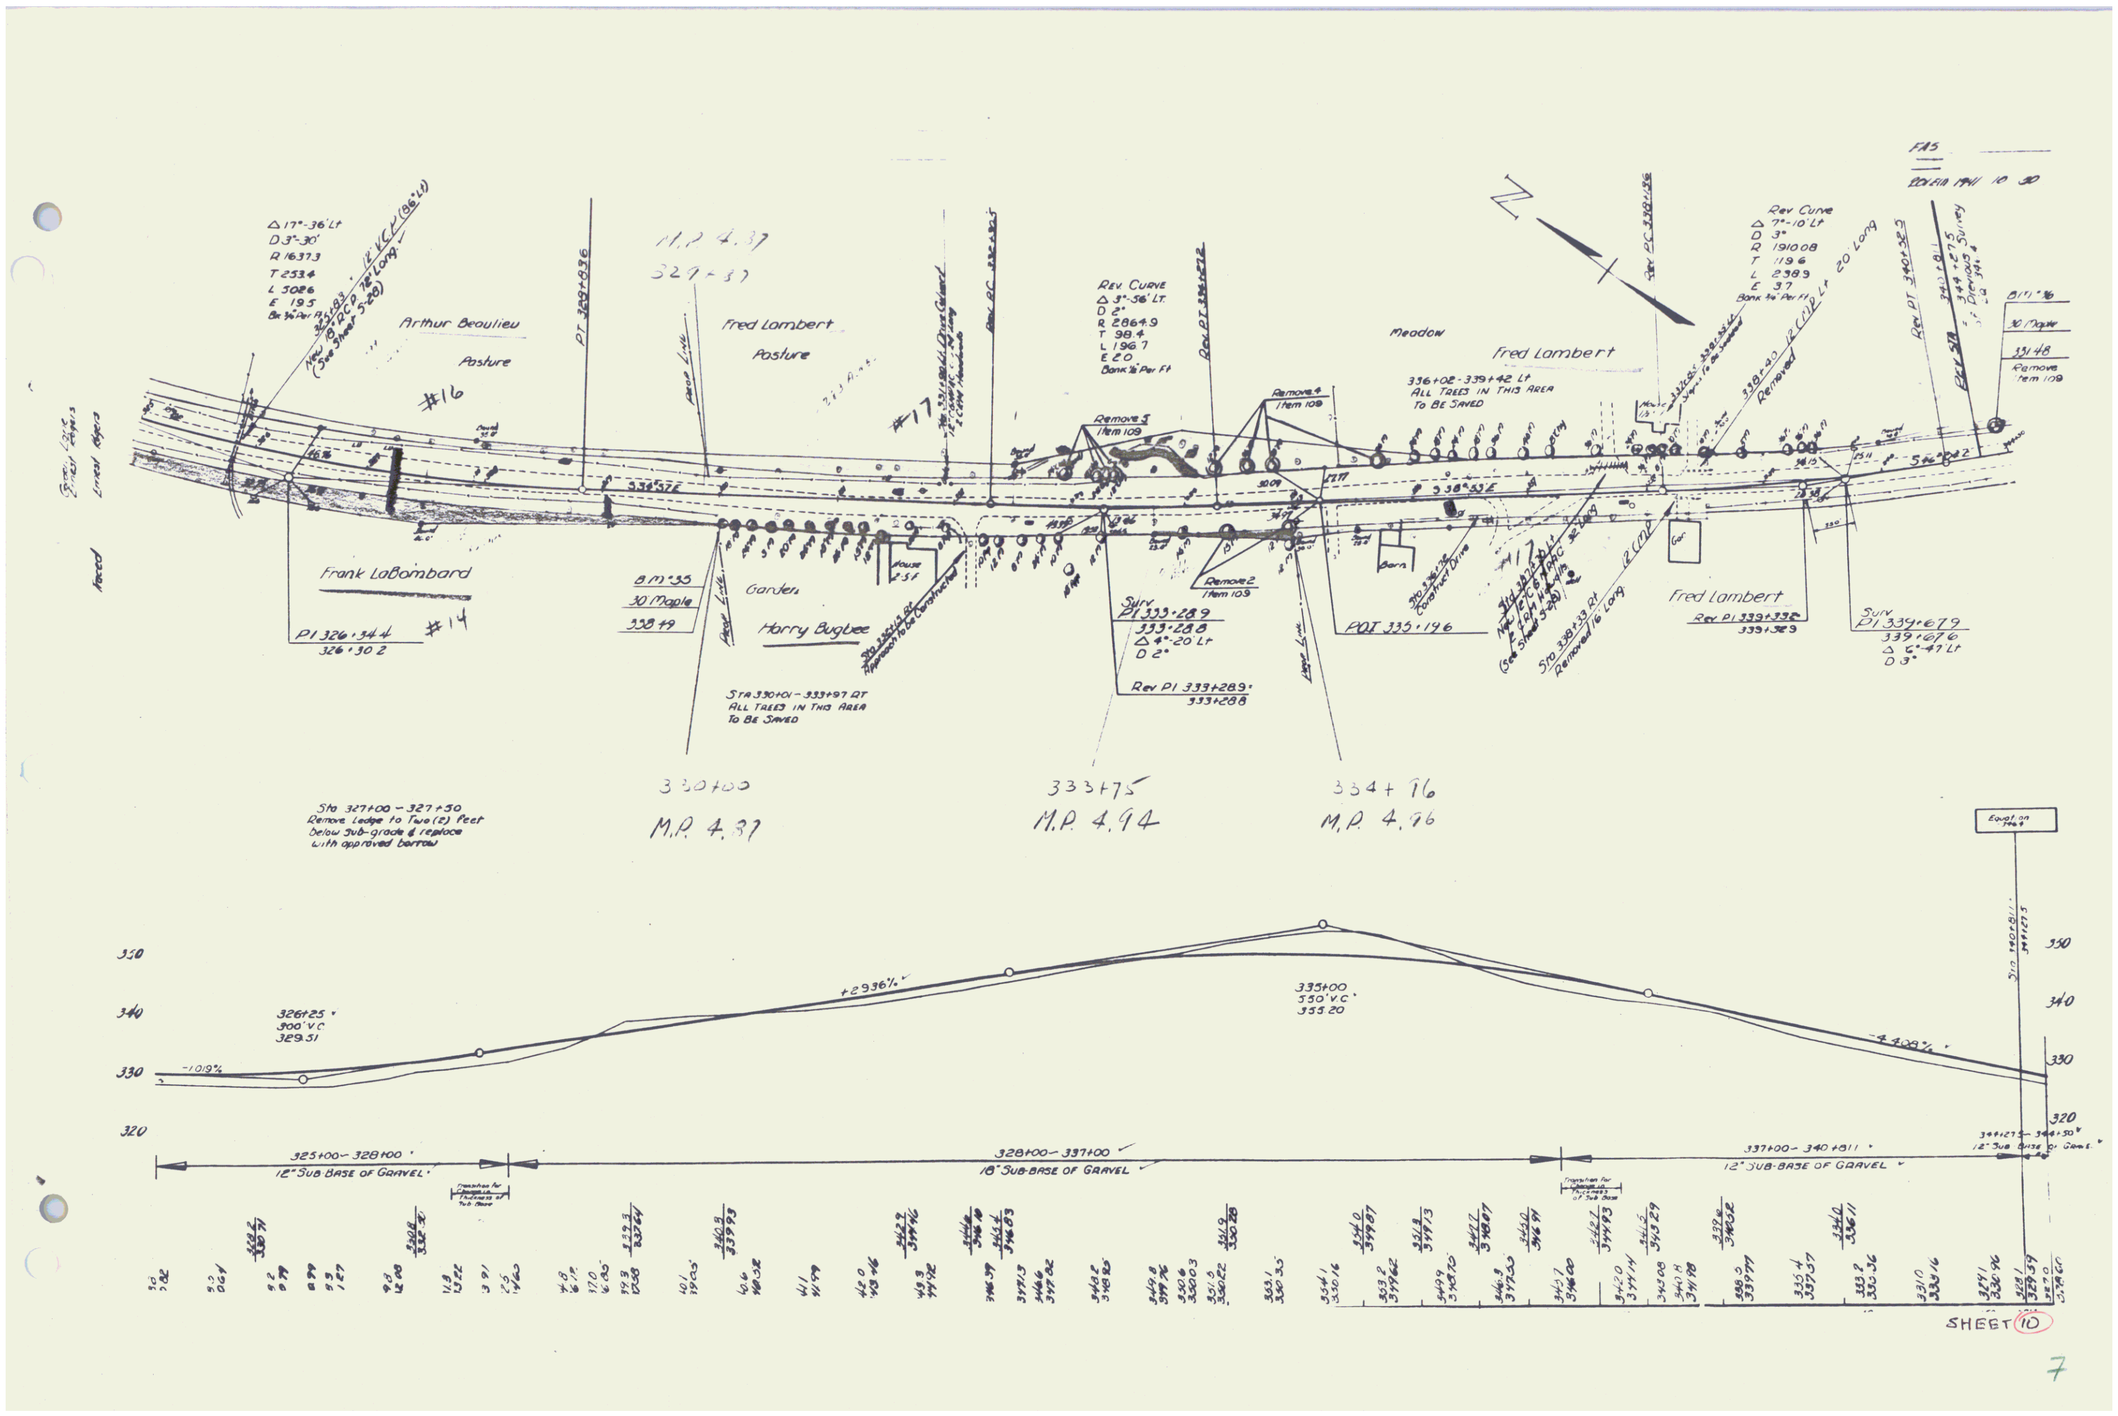
Arthur Beaulieu
Pasture
#16
Fred Lambert
Pasture
#17
Frank LaBombard
#14
Garden
Harry Bugbee
Meadow
Fred Lambert
Fred Lambert
Rev Curve
Rev Curve
Sta 330+00 - 333+97 RT
All Trees In This Area
To Be Saved
336+02 - 339+42 Lt
All Trees In This Area
To Be Saved
Sta 327+00 - 327+50
Remove Ledge to Two (2) Feet
Below Sub-grade & replace
with approved borrow
330+00
M.P. 4.37
333+75
M.P. 4.94
334+76
M.P. 4.96
+2.936%
-1.019%
-4.408%
326+25
300' V.C.
329.51
335+00
350' V.C.
335.20
325+00 - 328+00
12" Sub-base of Gravel
328+00 - 337+00
18" Sub-base of Gravel
337+00 - 340+311
12" Sub-base of Gravel
SHEET 10
7