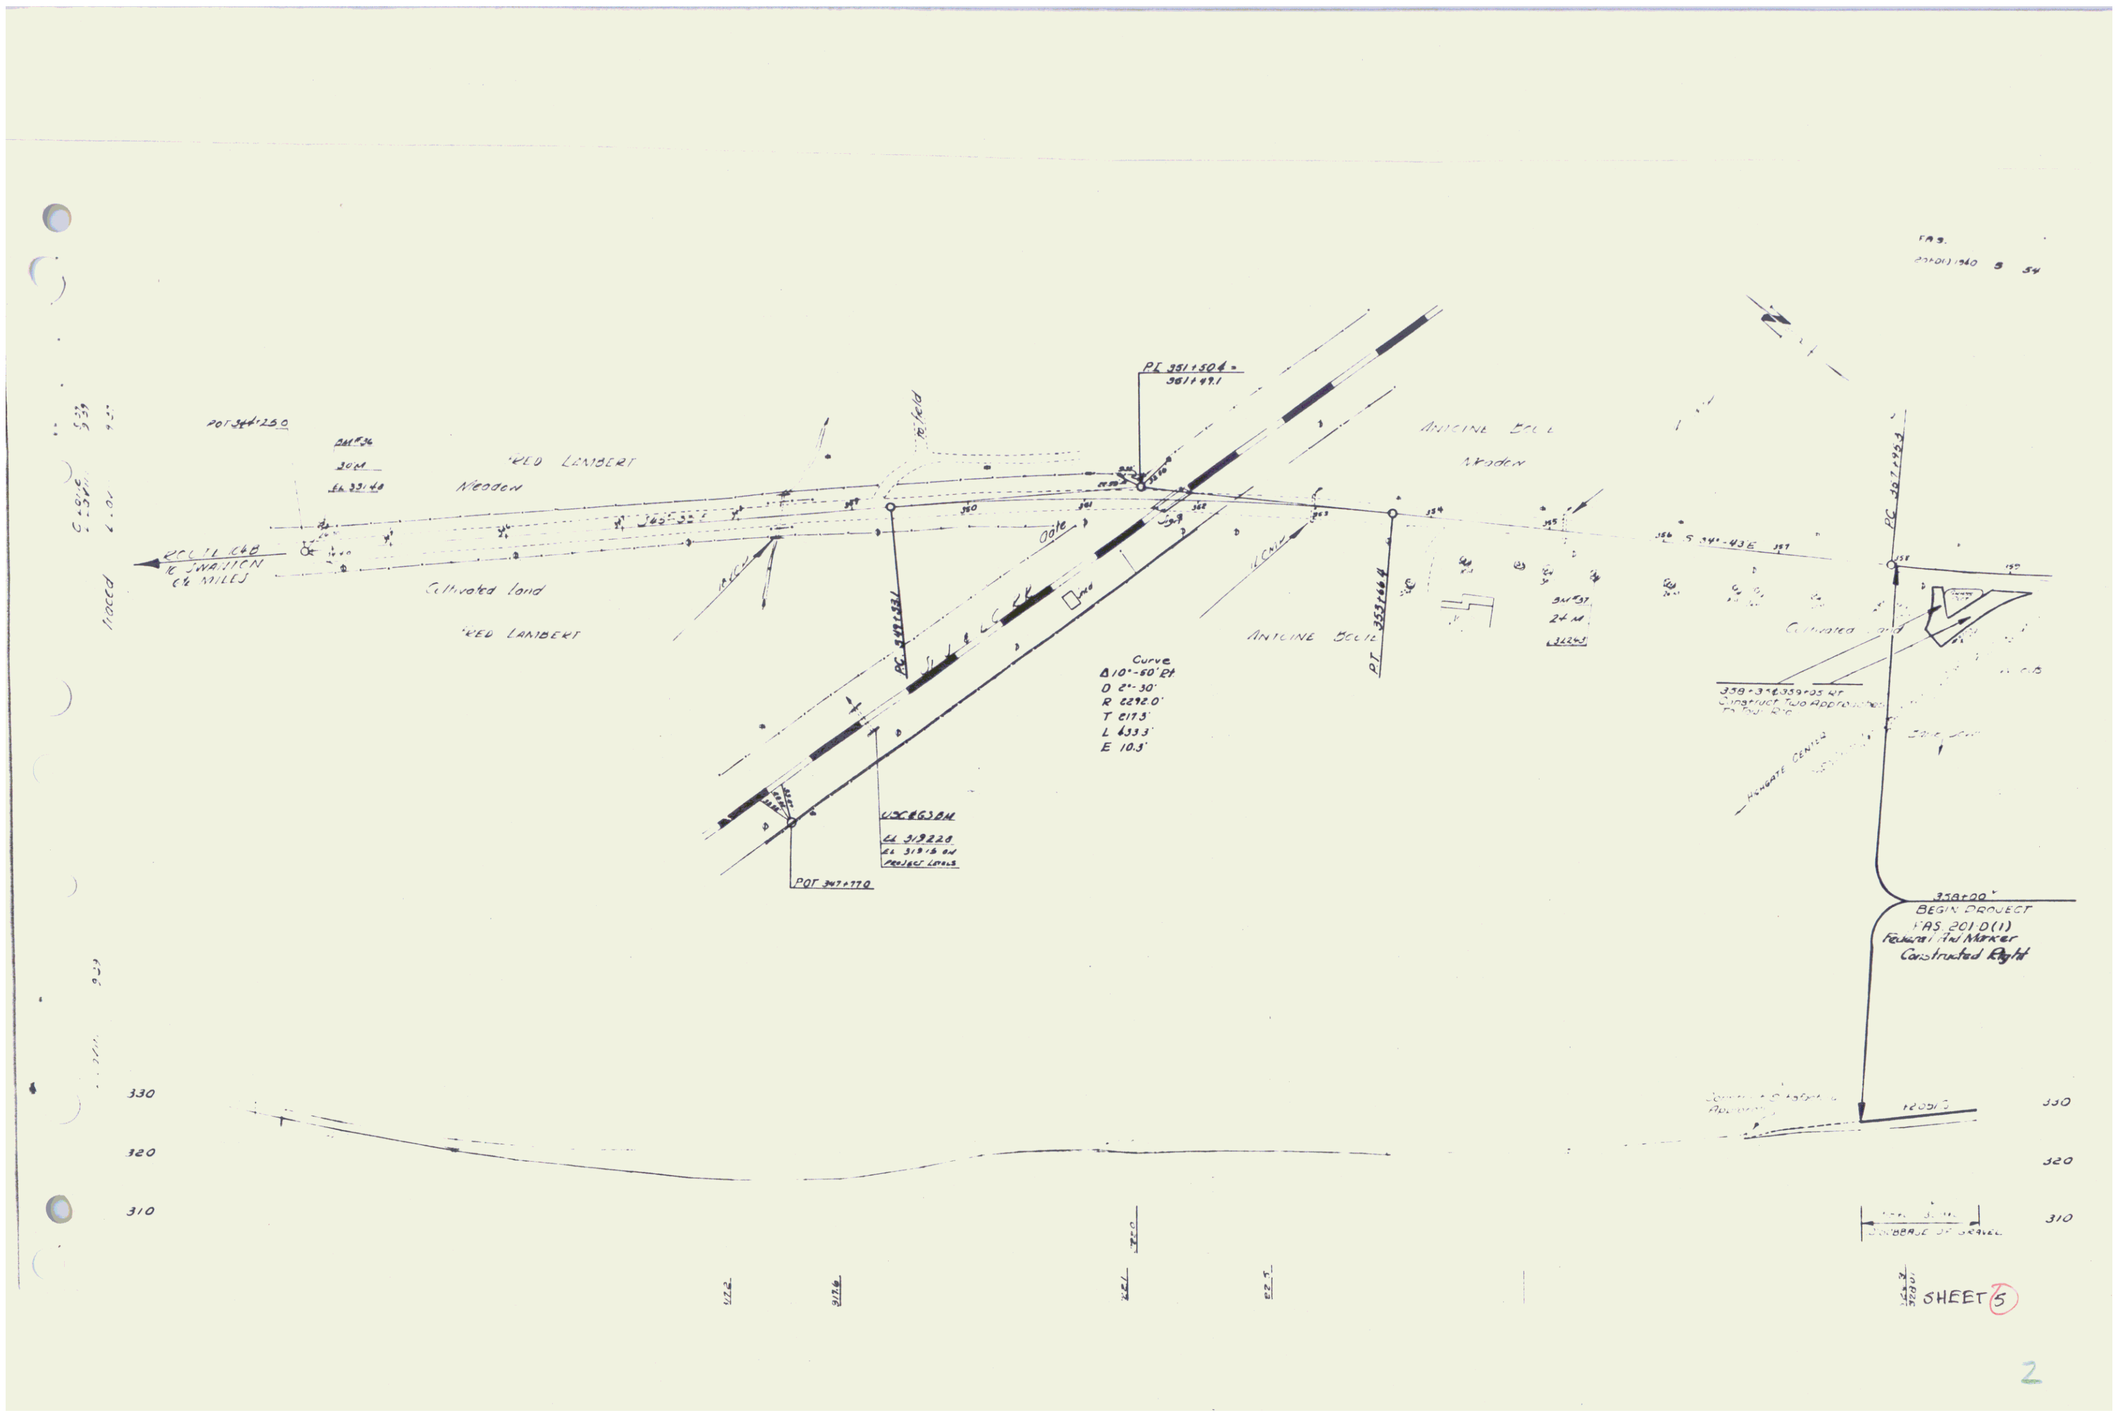
FAS.
27+01) 940 S 54
POT 344+250
30M
Wooden
RED LAMBERT
Cultivated land
RED LAMBERT
Curve
Δ 10°-60' Rt
D 2°-30'
R 2292.0'
T 217.3'
L 433.3'
E 10.3'
POT 347+770
PC 351+504 =
361+49.1
S 34°-43' E
Cultivated land
BEGIN PROJECT
FAS 201-D(1)
Federal Aid Marker
Constructed Right
330
320
310
SHEET 5
2