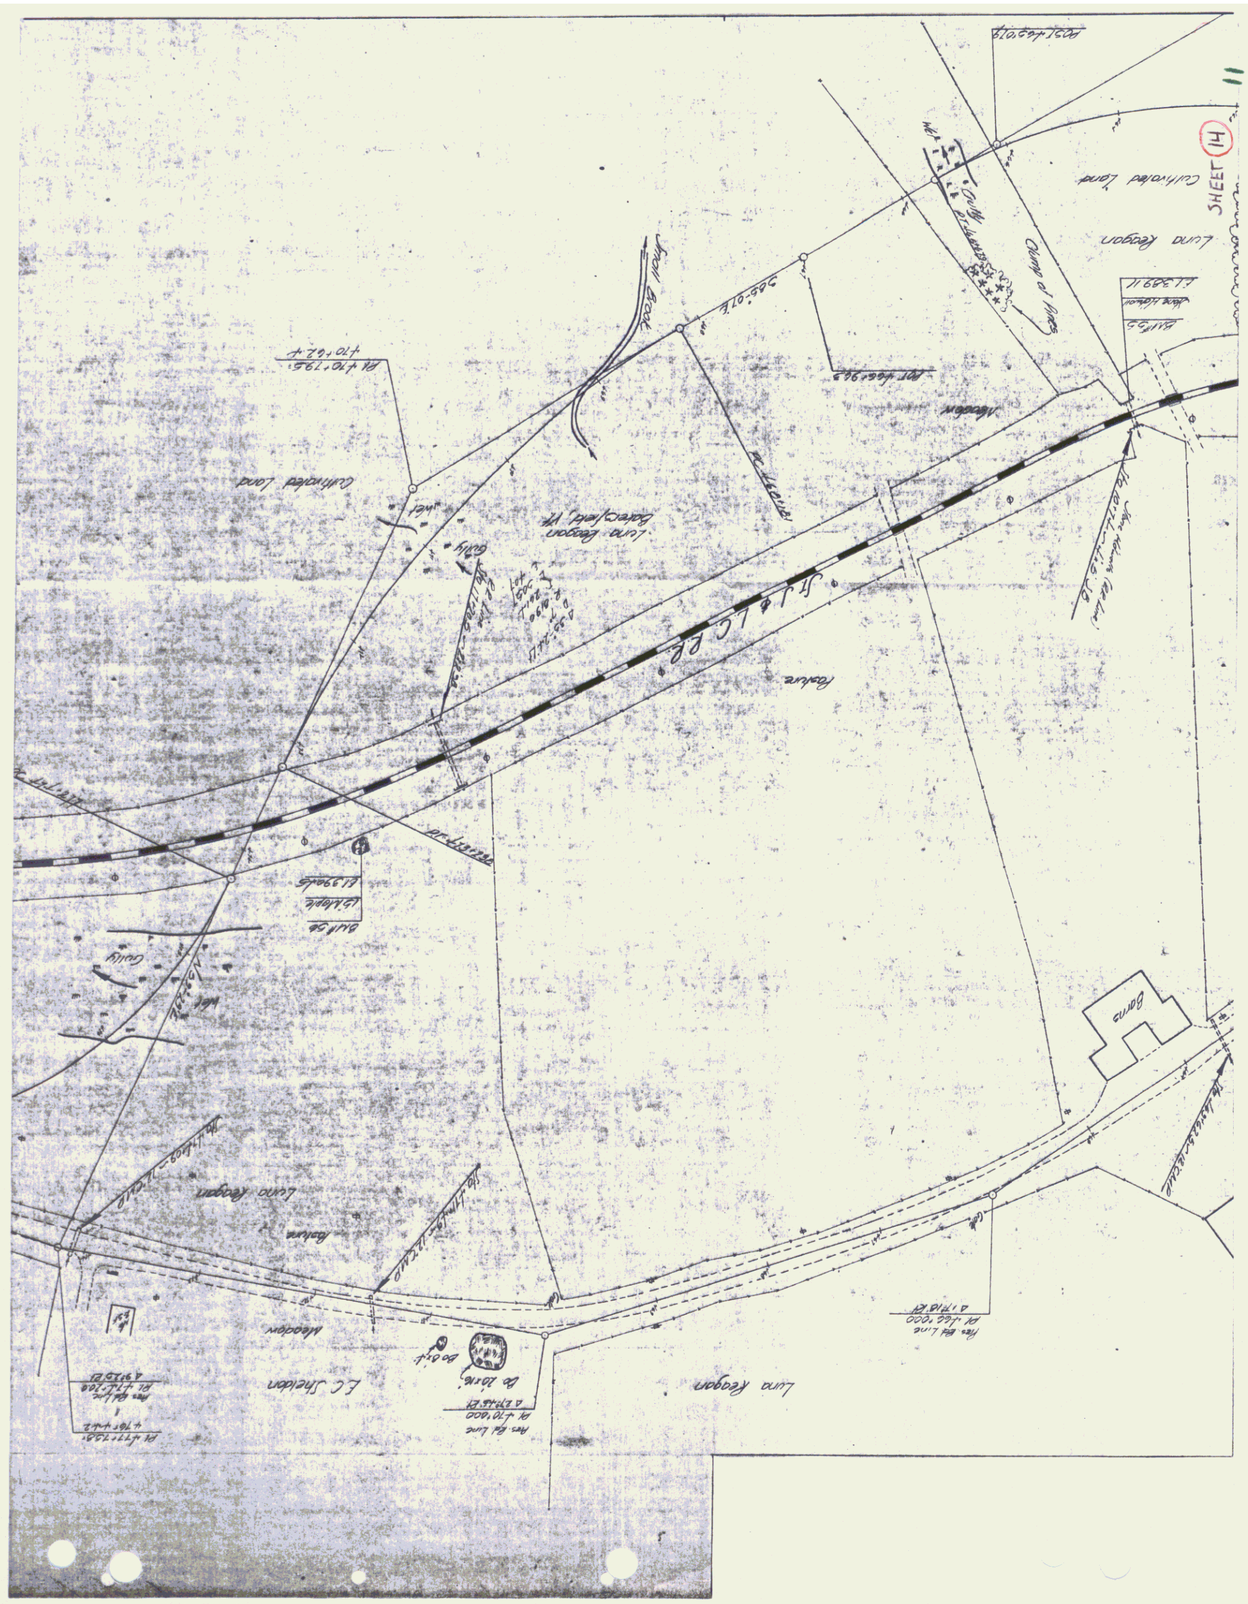
SHEET (14)
Luna Keegan
Cultivated Land
Cultivated Land
Luna Keegan
Luna Keegan
Luna Keegan