INDEX OF SHEETS

SHEET NO. 1 TITLE PAGE
" " 2 TYPICAL CROSS-SECTION OF IMPROVEMENT
" " 3 BANKING AND WIDENING TABLES
" " 4 QUANTITY SHEET (BRIDG)
5 QUANTITY SHEET (DRAINAGE)
6-7 EARTHWORK SHEETS
8-10 PLAN AND PROFILE SHEETS
11 STANDARD STRUCTURE SHEET S 40 BARRICADES, SIGNS AND LIGHTS
12 STANDARD STRUCTURE SHEET CONSTRUCTION DETAILS
13 STANDARD STRUCTURE SHEET CONSTRUCTION DETAILS NO.1
14 STANDARD STRUCTURE SHEET CONSTRUCTION DETAILS NO.2
15-22 CROSS SECTIONS.

STANDARD STRUCTURE SHEETS, APPROVED BY THE CHIEF ENGINEER, VERMONT STATE DEPARTMENT OF HIGHWAYS

S-40 JUNE 10, 1950

STATE OF VERMONT
STATE HIGHWAY DEPARTMENT

PLAN AND PROFILE OF PROPOSED
STATE HIGHWAY

SECONDARY PROJECT

TOWN OF HIGHGATE

COUNTY OF FRANKLIN
SWANTON-SHELDON JCT. ROAD
VERMONT ROUTE ~~104-B~~

BEGINNING AT A POINT APPROXIMATELY 2.8 MILES NORTHWESTERLY OF THE INTERSECTION OF VERMONT ROUTES 105 AND 104-B AND EXTENDING SOUTHEASTERLY 4,050.1 FEET.

LENGTH OF PROJECT 4,023.1 FEET = 0.762 MI.

FED. ROAD DIST. NO.	STATE	PROJ. NO.	FISCAL YEAR	SHEET NO.	TOTAL SHEETS
1	VT.	S 201 (8)	1951	1	28

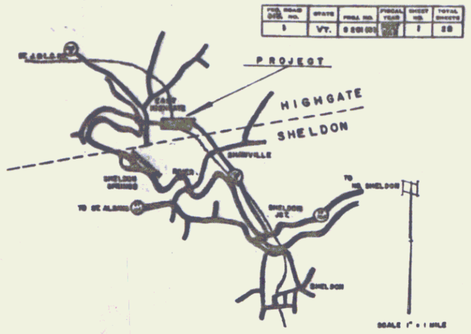

Project S 201(8)
Pin # 00R442
Route VT 78
Date 2/13/1951

MP 6.877

STA. 436+99
END PROJECT FAS. 201 (3) (1940) | BEGIN PROJECT S 201 (8)

Note: Any further information concerning final quantities, amounts or other details relative to this project may be found in either the field books or the estimate file.

436+49 TO 465+86.1 NOT INCLUDED IN PROJECT

MP 7.645
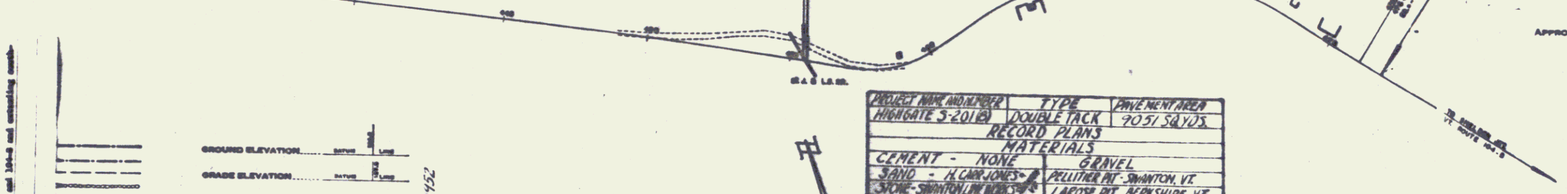
STA. 477+09
END PROJECT S 201 (8) | BEGIN PROJECT SN FAS. 201 F (1) (1942)