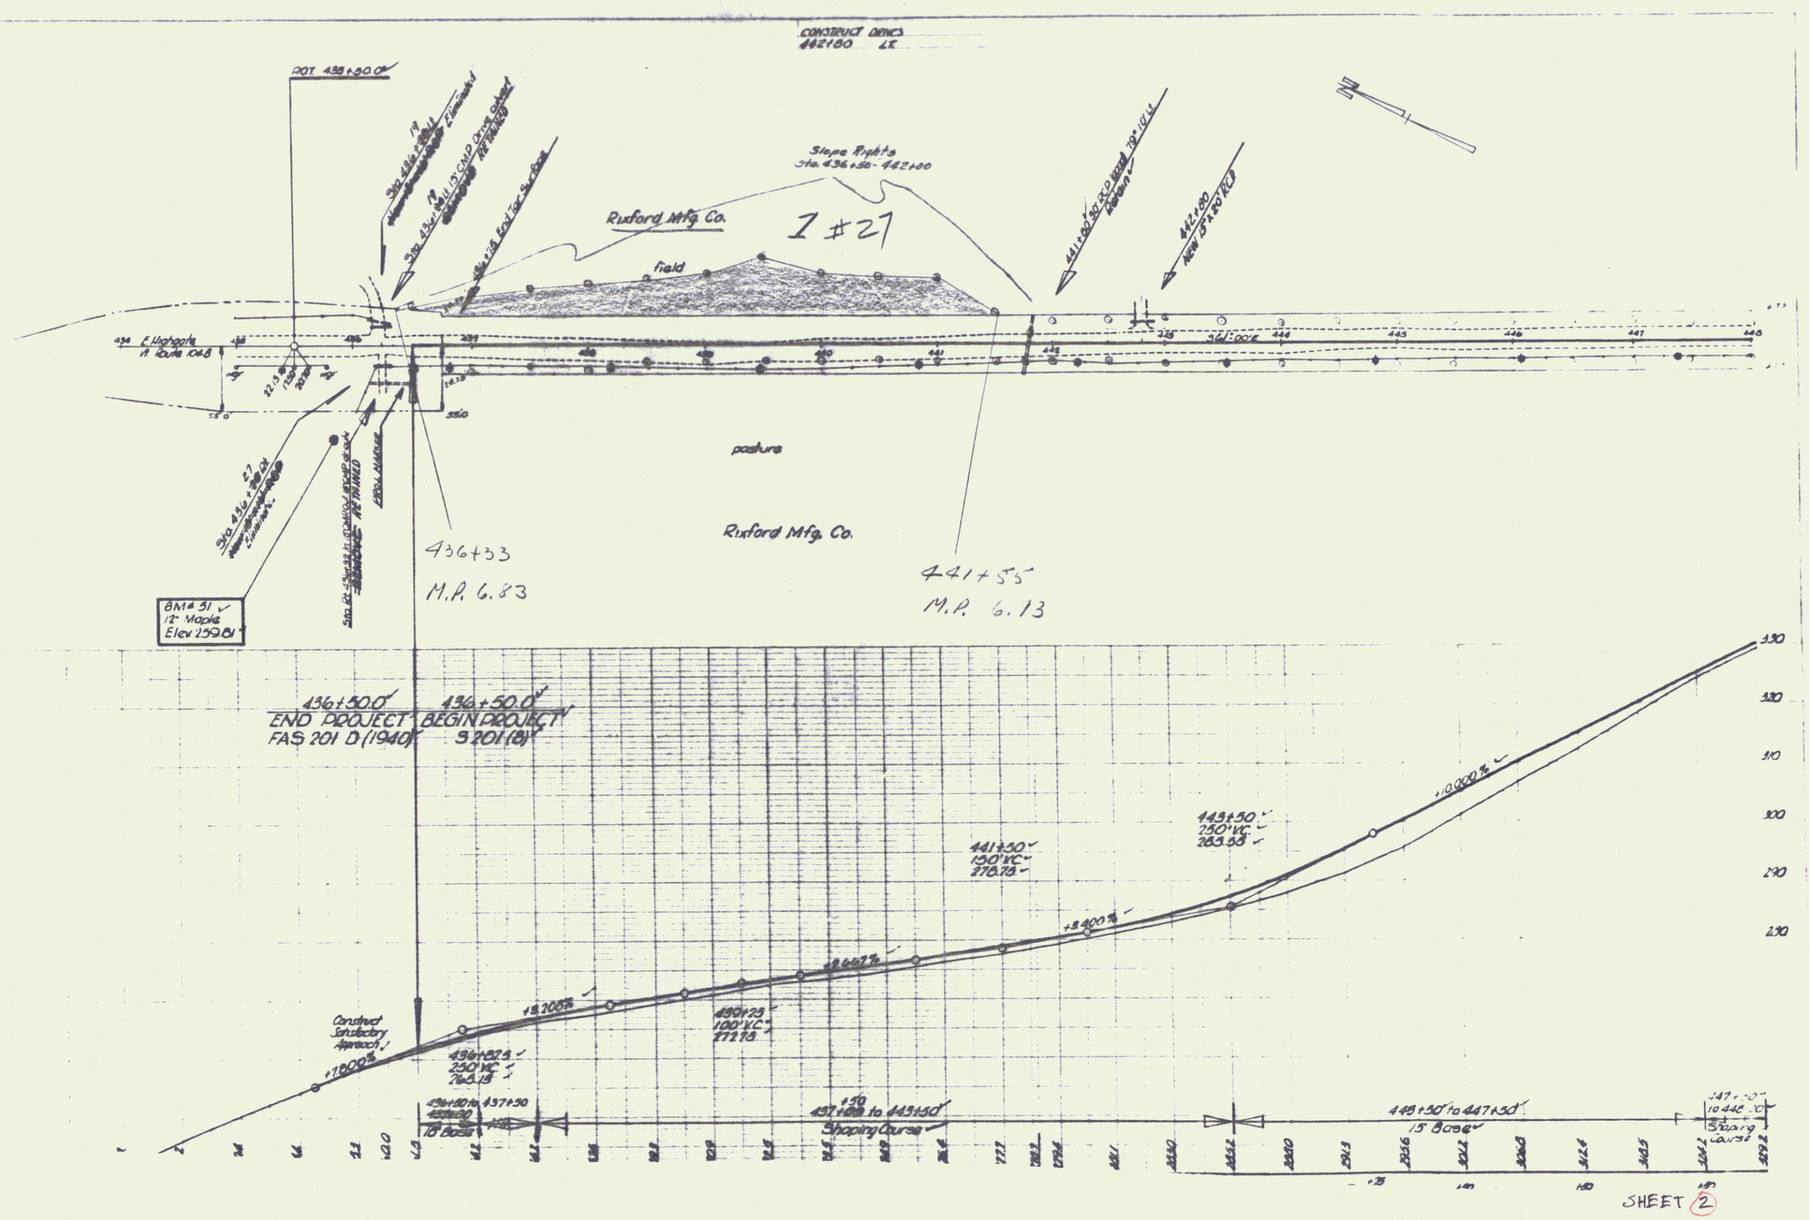
CONSTRUCT DRIVES
442+80 LT.
POT. 435+50.0
Slope Rights
Sta. 436+50 - 442+00
Rixford Mfg. Co.
Field
Pasture
Rixford Mfg. Co.
436+33
M.P. 6.83
441+55
M.P. 6.13
BM # 51
12" Maple
Elev 259.81
436+50.0
END PROJECT
FAS 201 D (1940)
436+50.0
BEGIN PROJECT
S 201 (8)
Construct Satisfactory Approach
+7.800%
+8.200%
+8.667%
+8.400%
+10.000%
441+50
150' VC
278.75
443+50
250' VC
283.55
436+82.5
250' VC
265.15
439+29
100' VC
272.15
437+50 to 443+50
Shoping Course
449+50 to 447+50
15' Base
Spary Course
SHEET 2

2