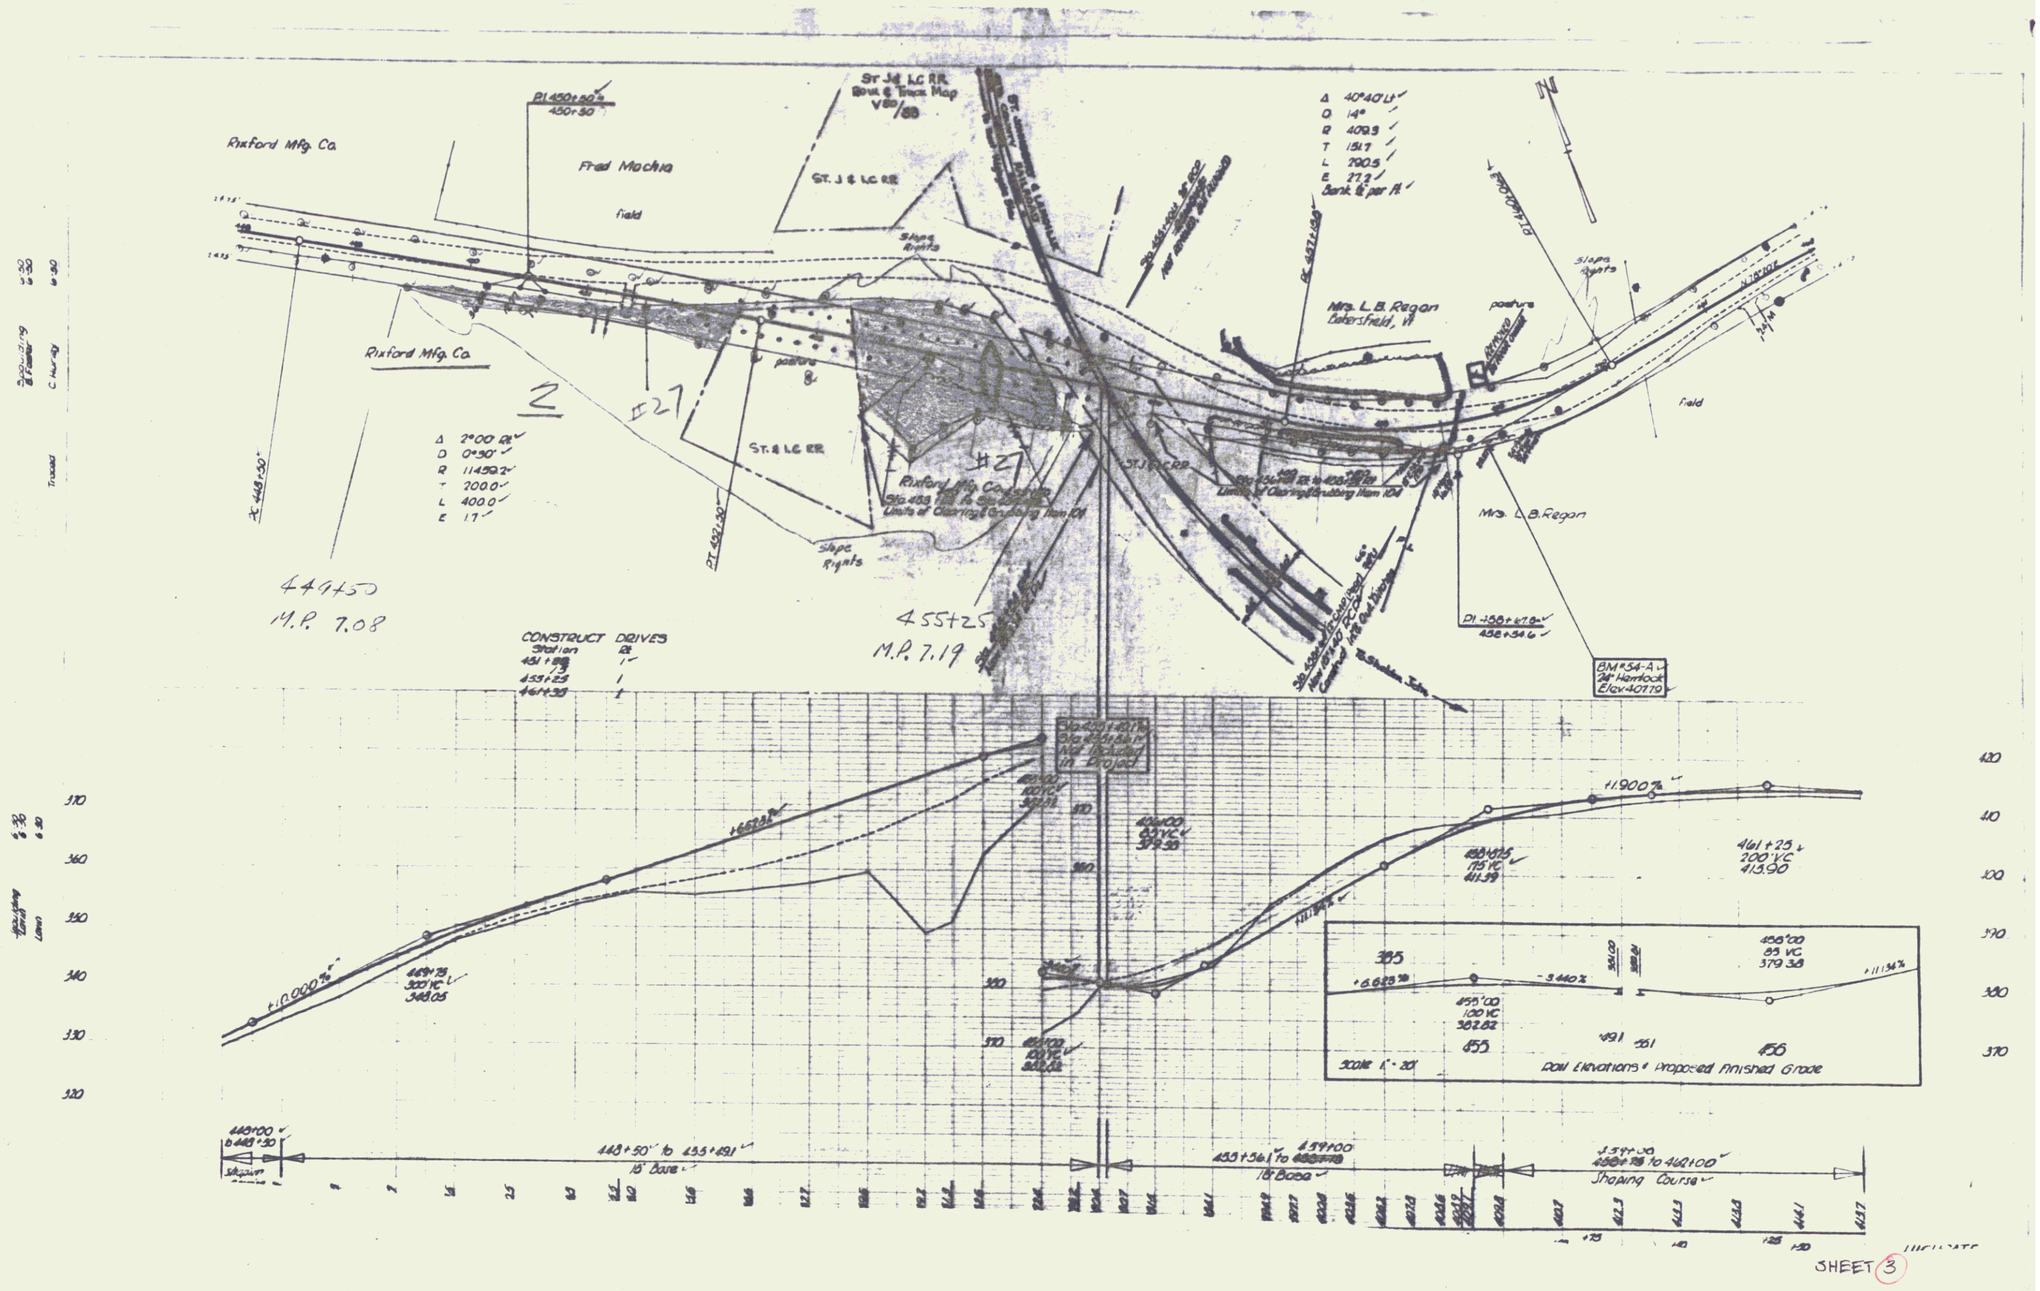
Rixford Mfg. Co.
Fred Mocha
field
St. J & L.C. R.R.
Rixford Mfg. Co.
pasture
St. J & L.C. R.R.
Slope Rights
Mrs. L.B. Regan
Bakersfield, Vt
pasture
field
Mrs. L.B. Regan
Rixford Mfg. Co.
Slope Rights
Δ 2°00' Rt
D 0°30'
R 1145.92
T 200.0
L 400.0
E 17
Δ 40°40' Lt
D 14°
R 409.3
T 151.7
L 290.5
E 27.2
Bank ½ per ft
M.P. 7.08
M.P. 7.19
CONSTRUCT DRIVES
Station Rt
451+88 1
453+25 1
461+35 1
BM #54-A
24" Hemlock
Elev 407.70
+1.900%
+1.000%
+6.623%
-3.440%
+11.134%
461+25
200' VC
413.90
348.05
455'00
100' VC
382.82
458'00
85' VC
379.38
Row Elevations & Proposed Finished Grade
Scale 1" = 20'
443+00 to 453+91
18' Base
453+56 to 459+00
18' Base
457+00 to 462+00
Shaping Course
SHEET 3
3