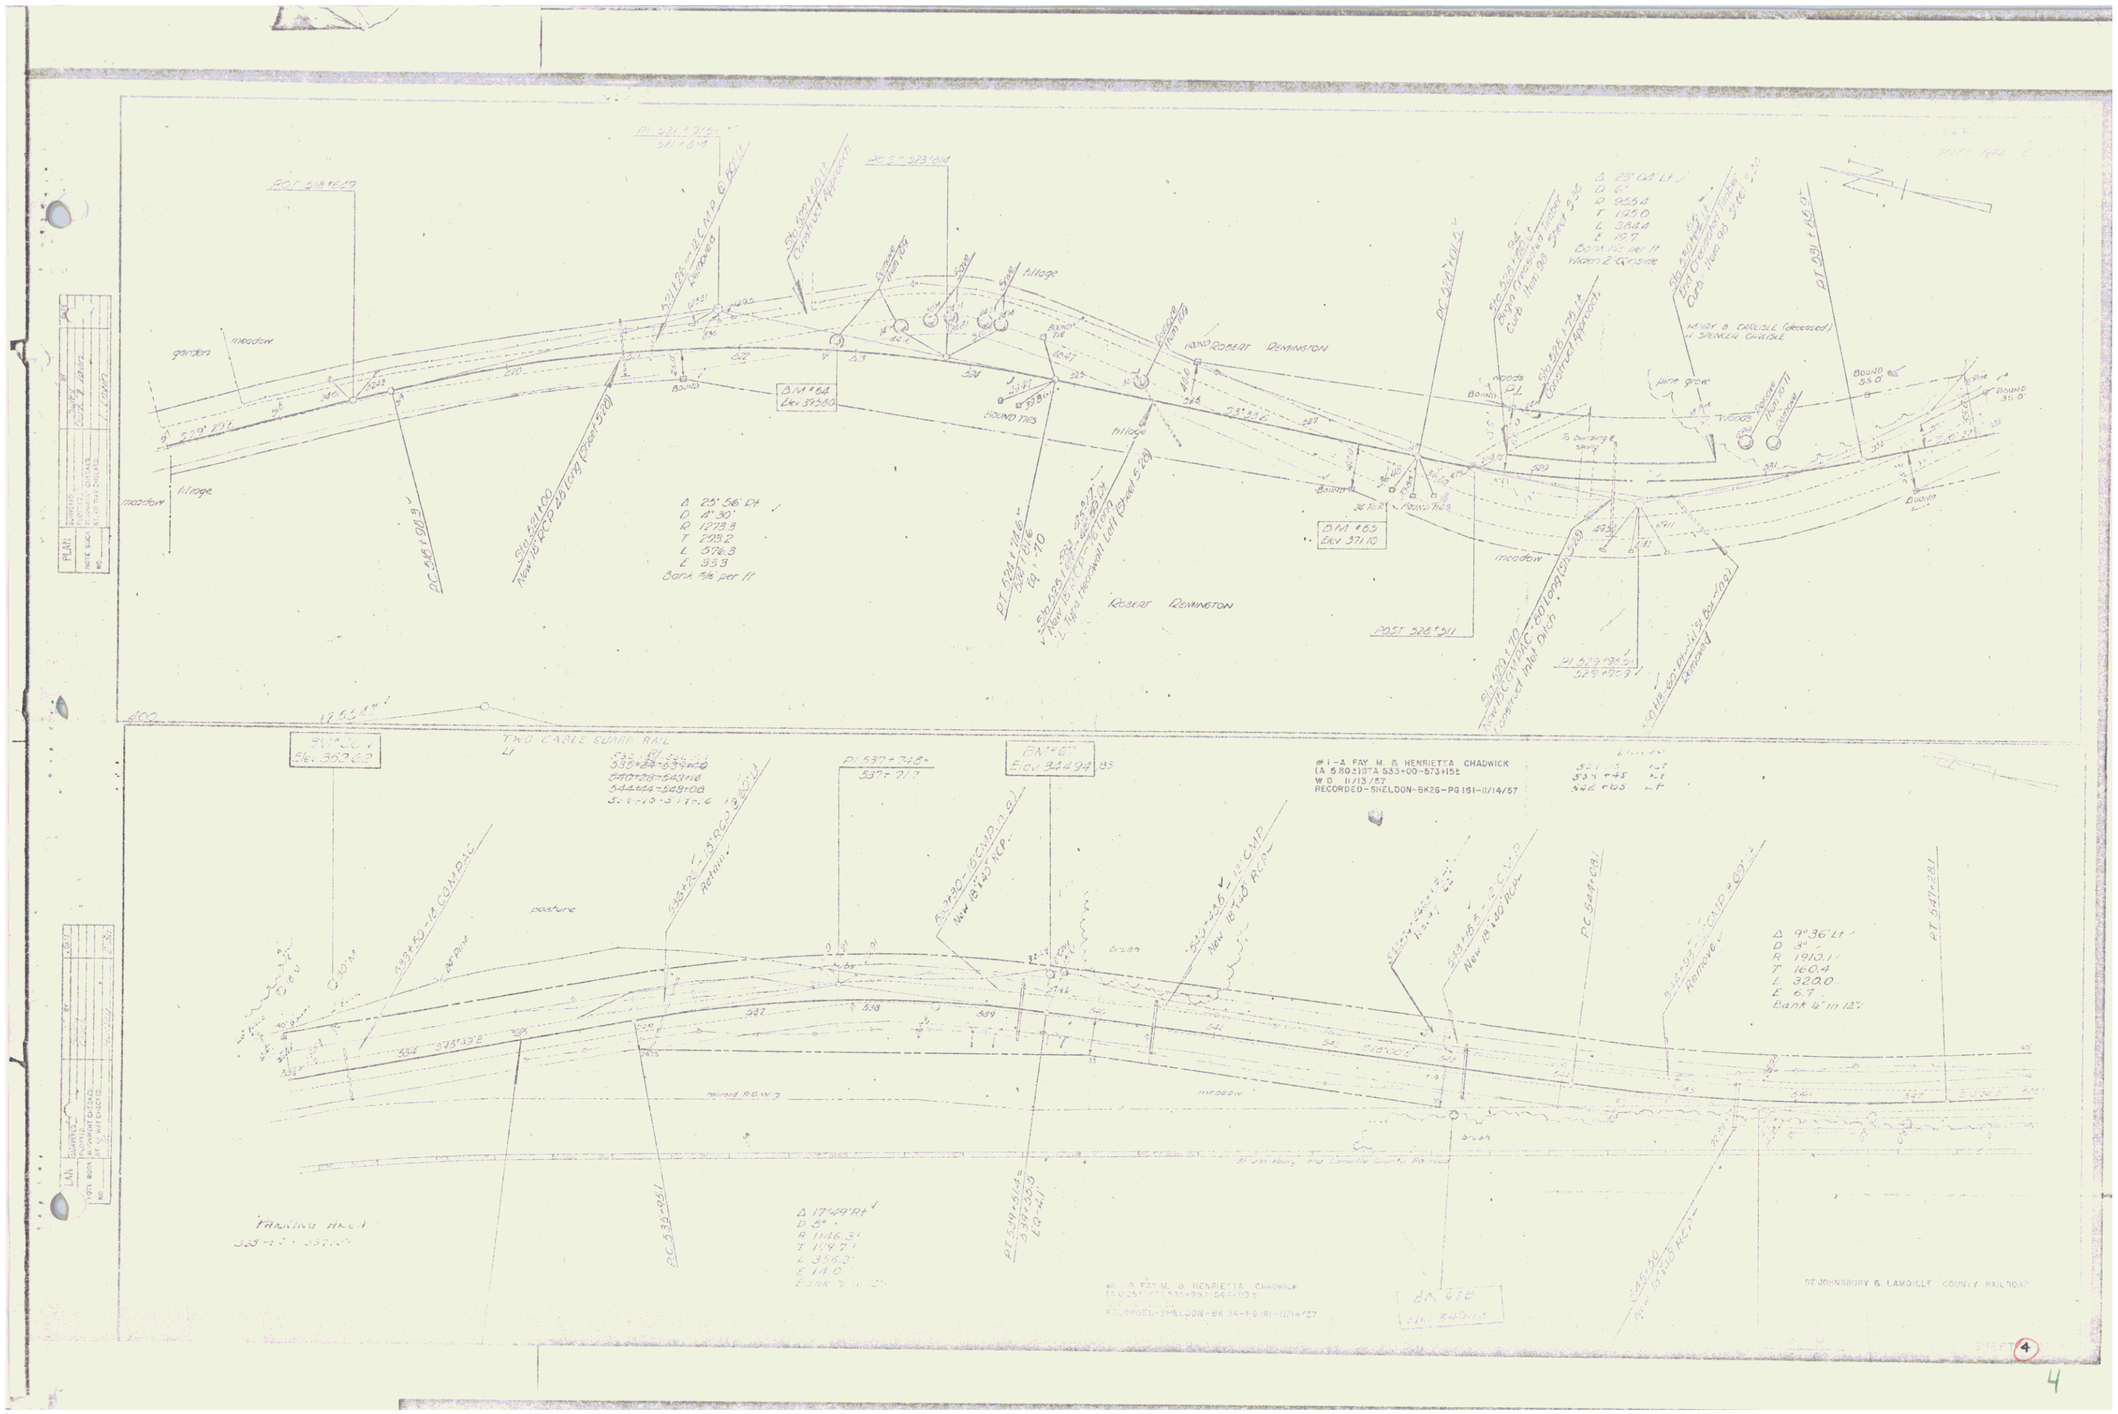
garden
meadow
fillage
POST 518+62.7
PC 518+98.9
Δ 25°56' Rt
D 4°30'
R 1273.3
T 292.2
L 576.3
E 33.3
Bank 7½ per ft
BM #64
Elev 375.80
BOUND TIES
Robert Remington
POST 528+31
BM #65
Elev 371.10
Δ 25°08' Lt
D 6°
R 955.4
T 195.0
L 384.4
E 19.7
Bank 1½ per ft
pine grove
woods
TWO CABLE GUARD RAIL
BM #66
Elev 344.94
#1-A FAY M. & HENRIETTA CHADWICK
(A 5.802) STA 533+00-573+15E
W.D. 11/13/57
RECORDED-SHELDON-BK26-PG 151-11/14/57
pasture
Δ 9°36' Lt
D 3°
R 1910.1'
T 160.4
L 320.0
E 6.7
Bank 6" in 12"
Δ 17°49' Rt
D 5°
R 1146.31
T 179.7
L 356.0
E 14.0
Bank 2" in 12"
ST. JOHNSBURY & LAMOILLE COUNTY RAILROAD

4