




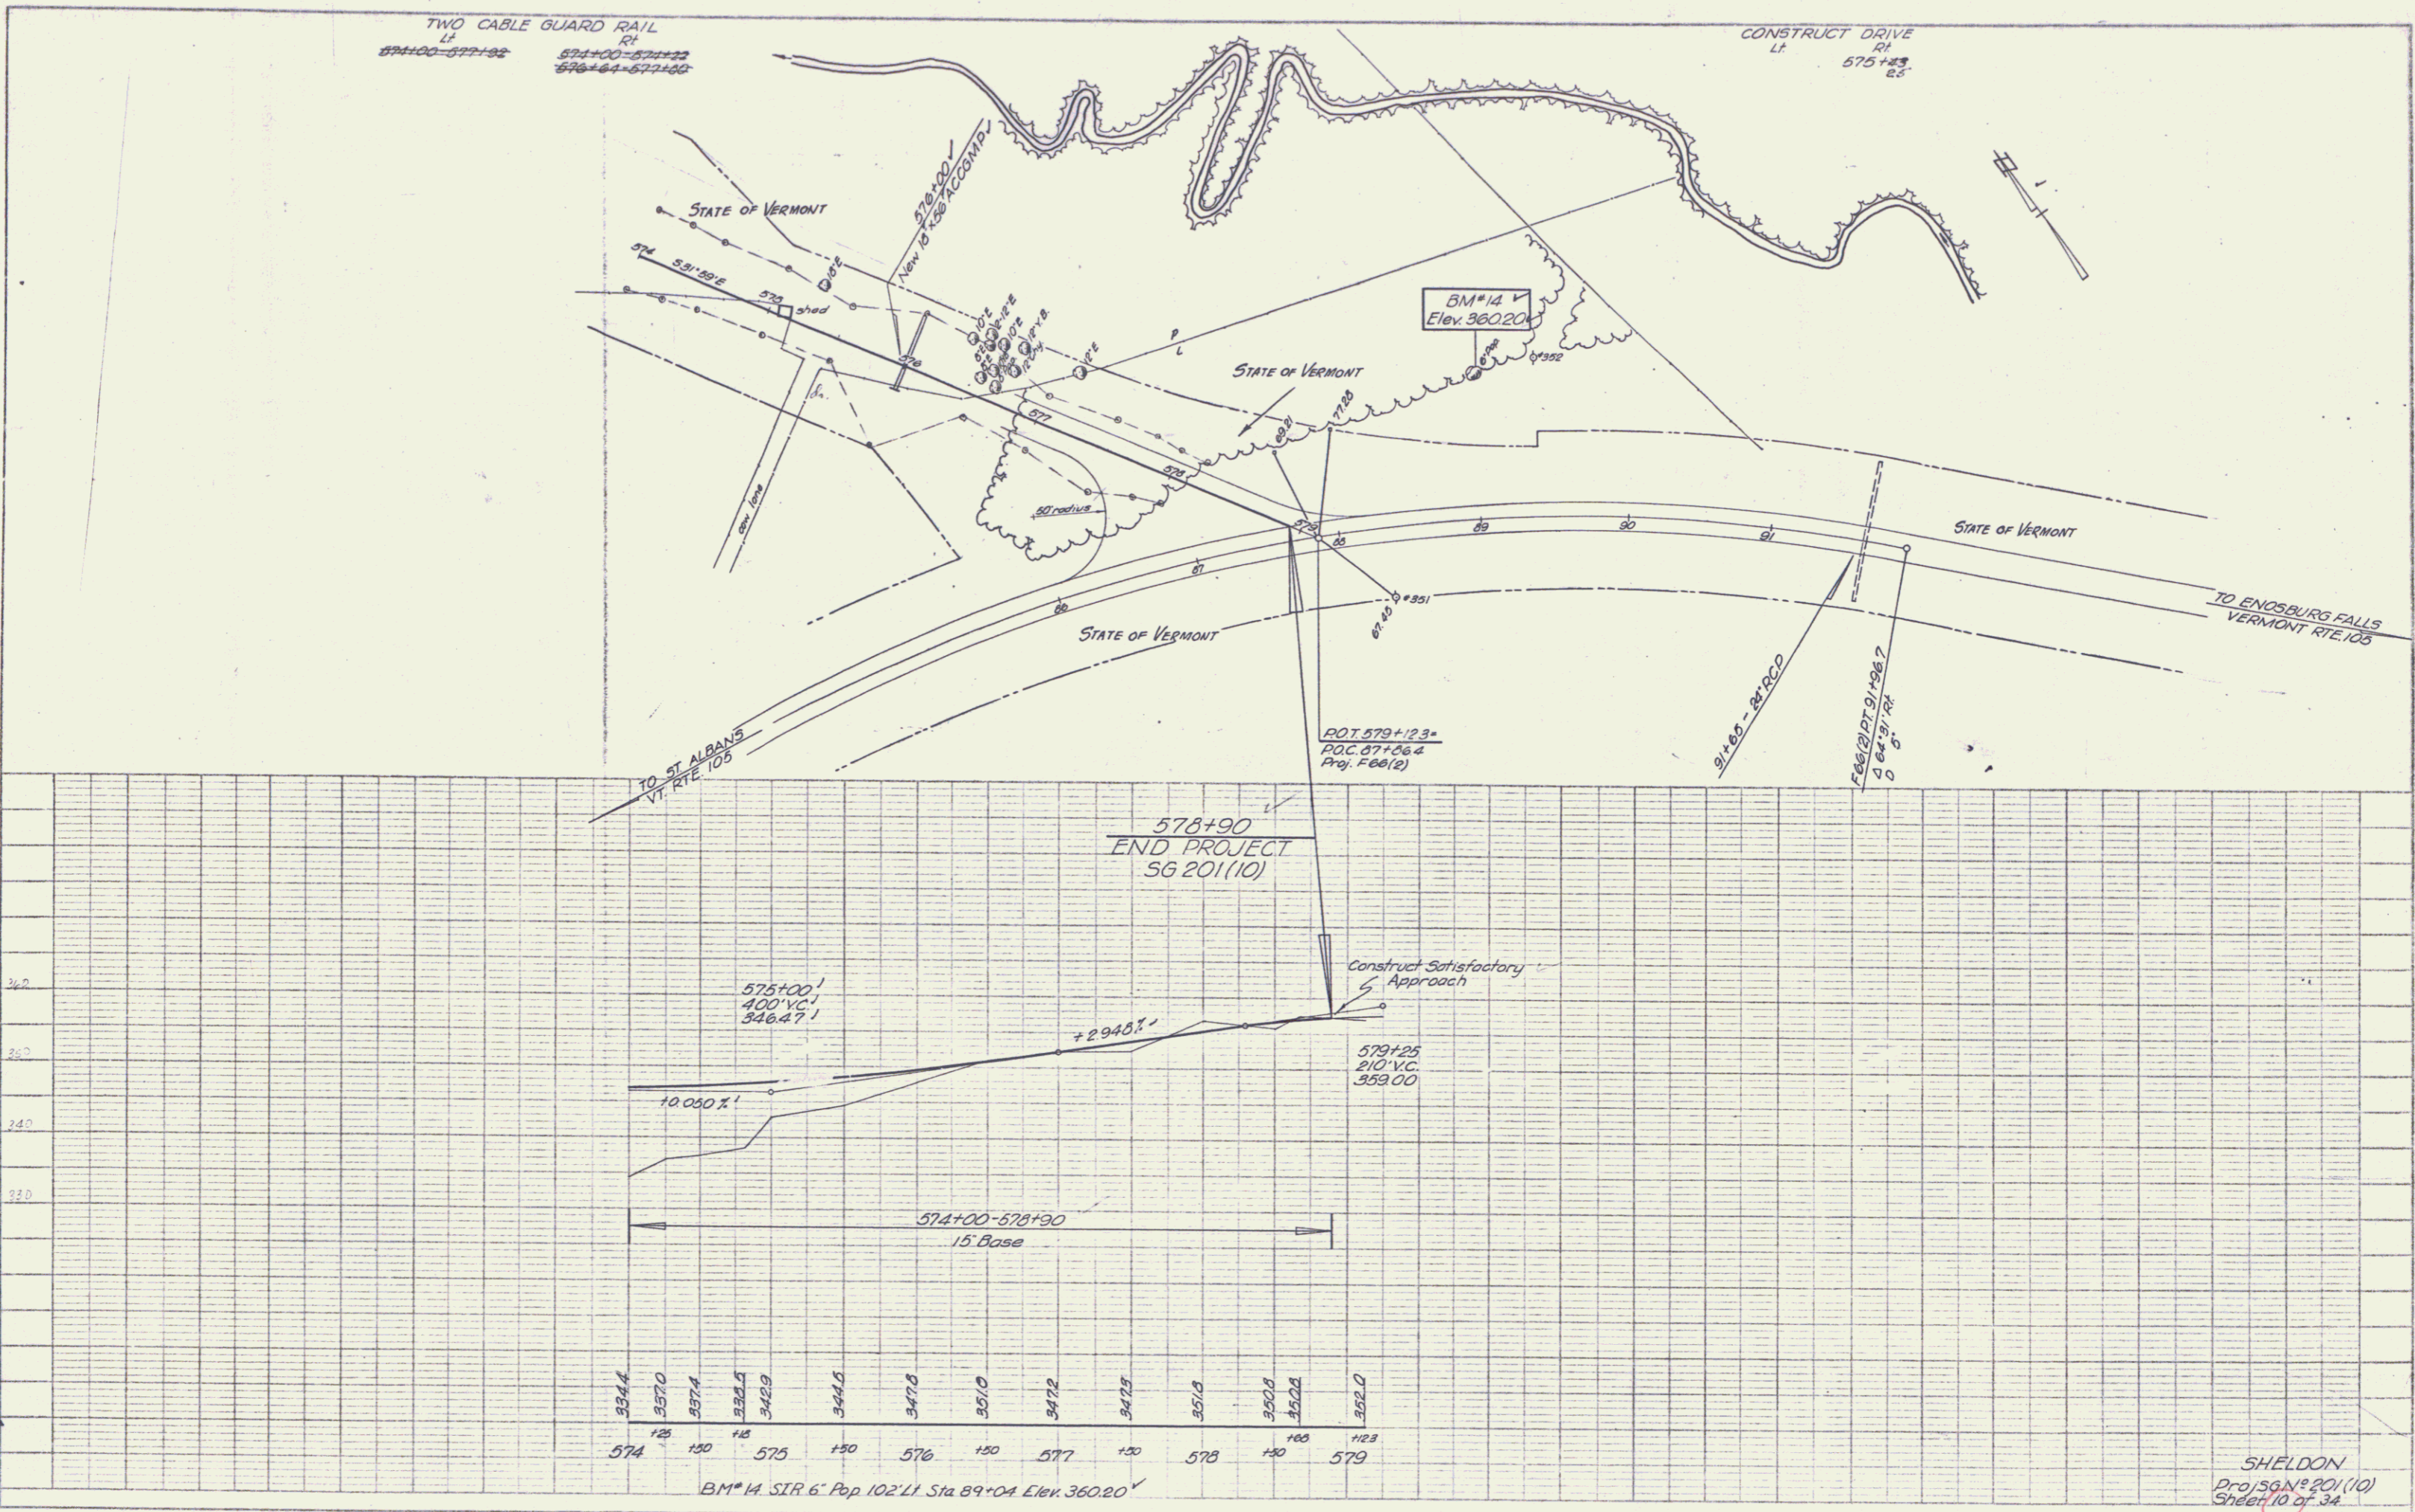

SHELDON
 Proj. SG N° 201(10)
 Sheet 10 of 34