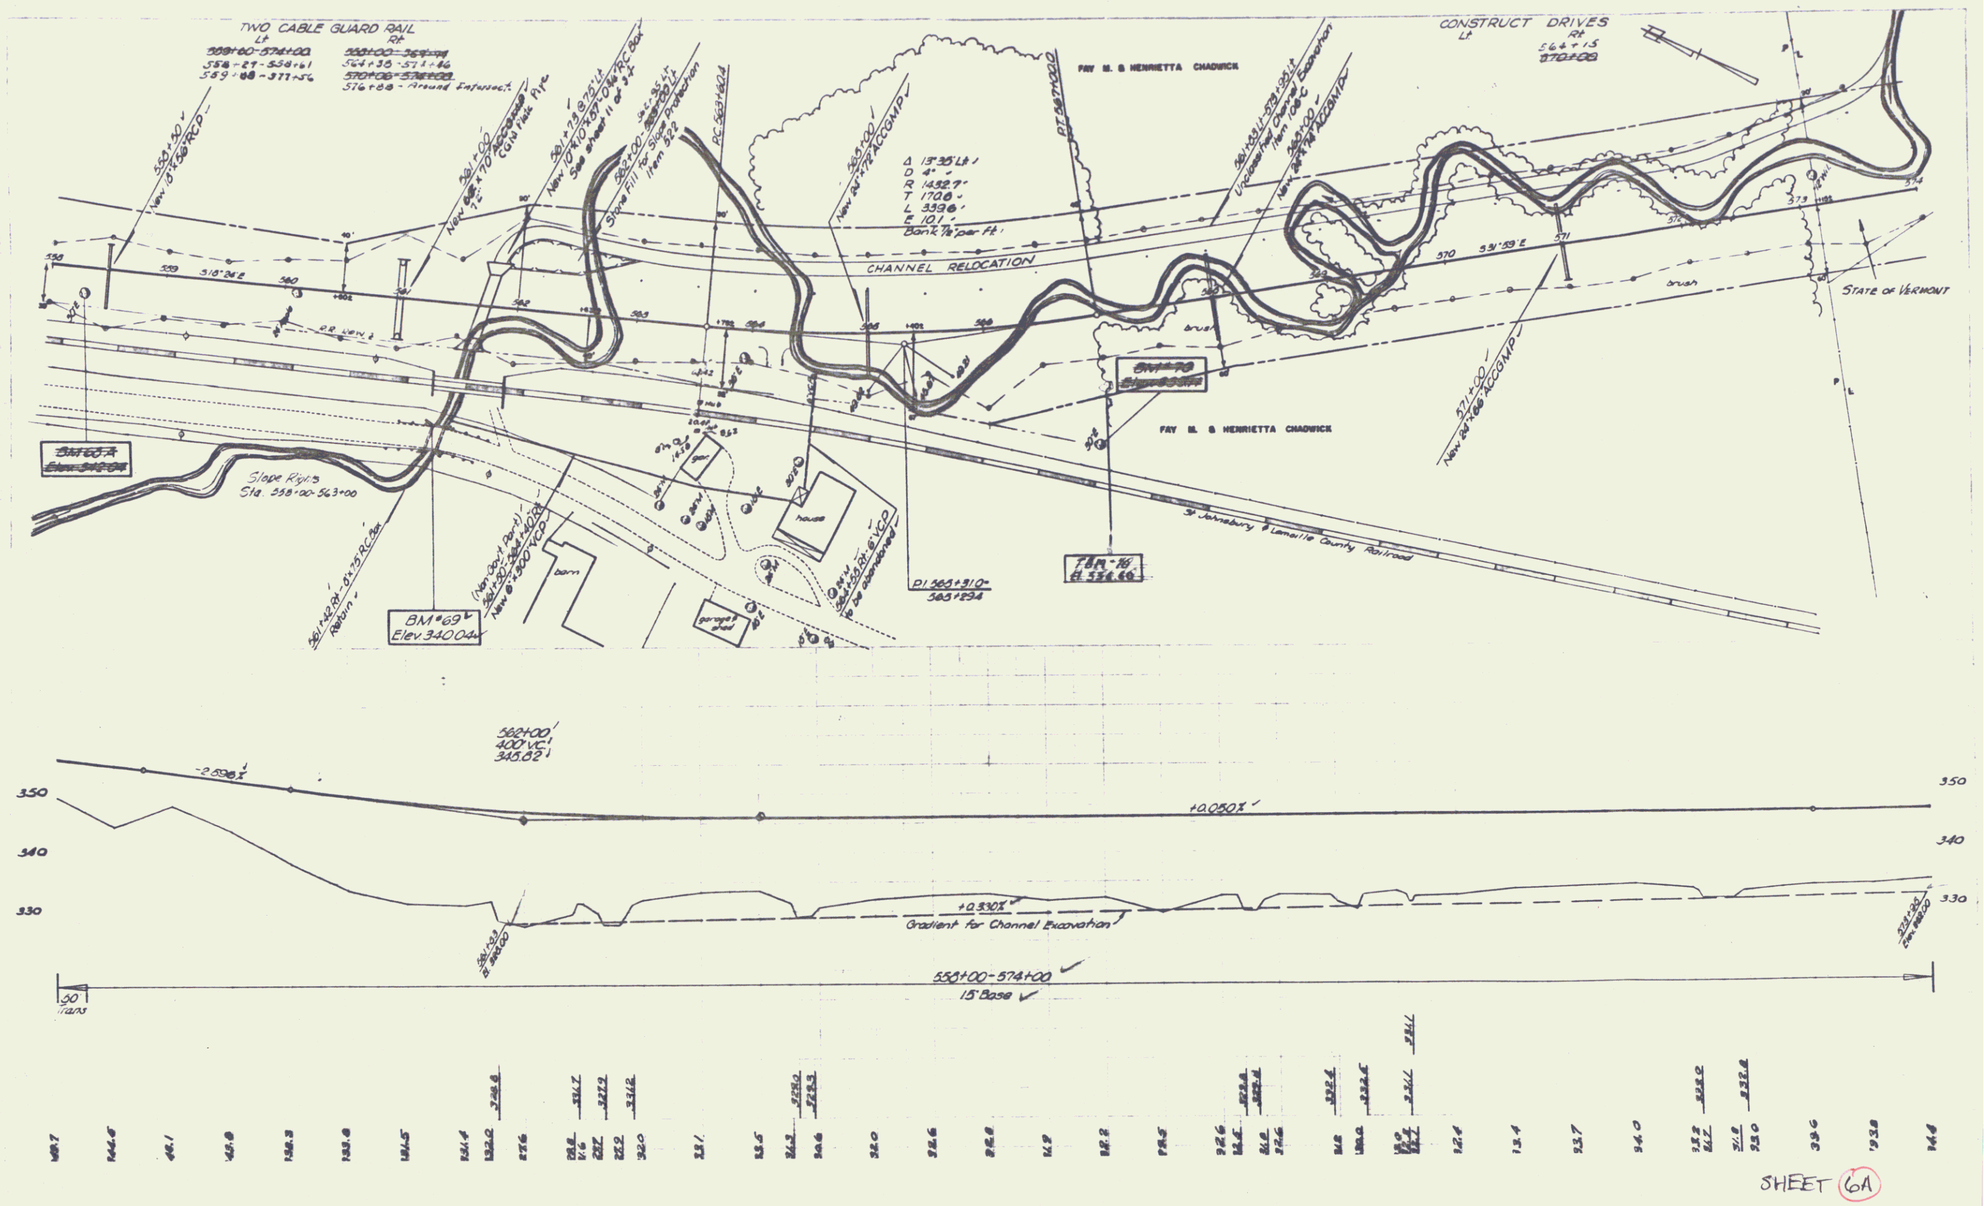
TWO CABLE GUARD RAIL
Lt
Rt
CONSTRUCT DRIVES
Lt
Rt
FAY M. & HENRIETTA CHADWICK
CHANNEL RELOCATION
Δ 13°35' Lt
D 4°
R 1432.7'
T 170.0'
L 339.0'
E 10.1'
Bank Taper ft.
S 31°59' E
S 18°24' E
brush
house
barn
garage
Slope Rip-rap
Sta. 558+00-563+00
BM #69
Elev. 340.04
BM #60-A
Elev. 342.08
PI 565+31.0
565+234
STATE OF VERMONT
St Johnsbury & Lamoille County Railroad
562+00
400' VC
345.82
+0.050%
+0.530%
Gradient for Channel Excavation
558+00-574+00
15' Base
350
340
330
SHEET 6A
6