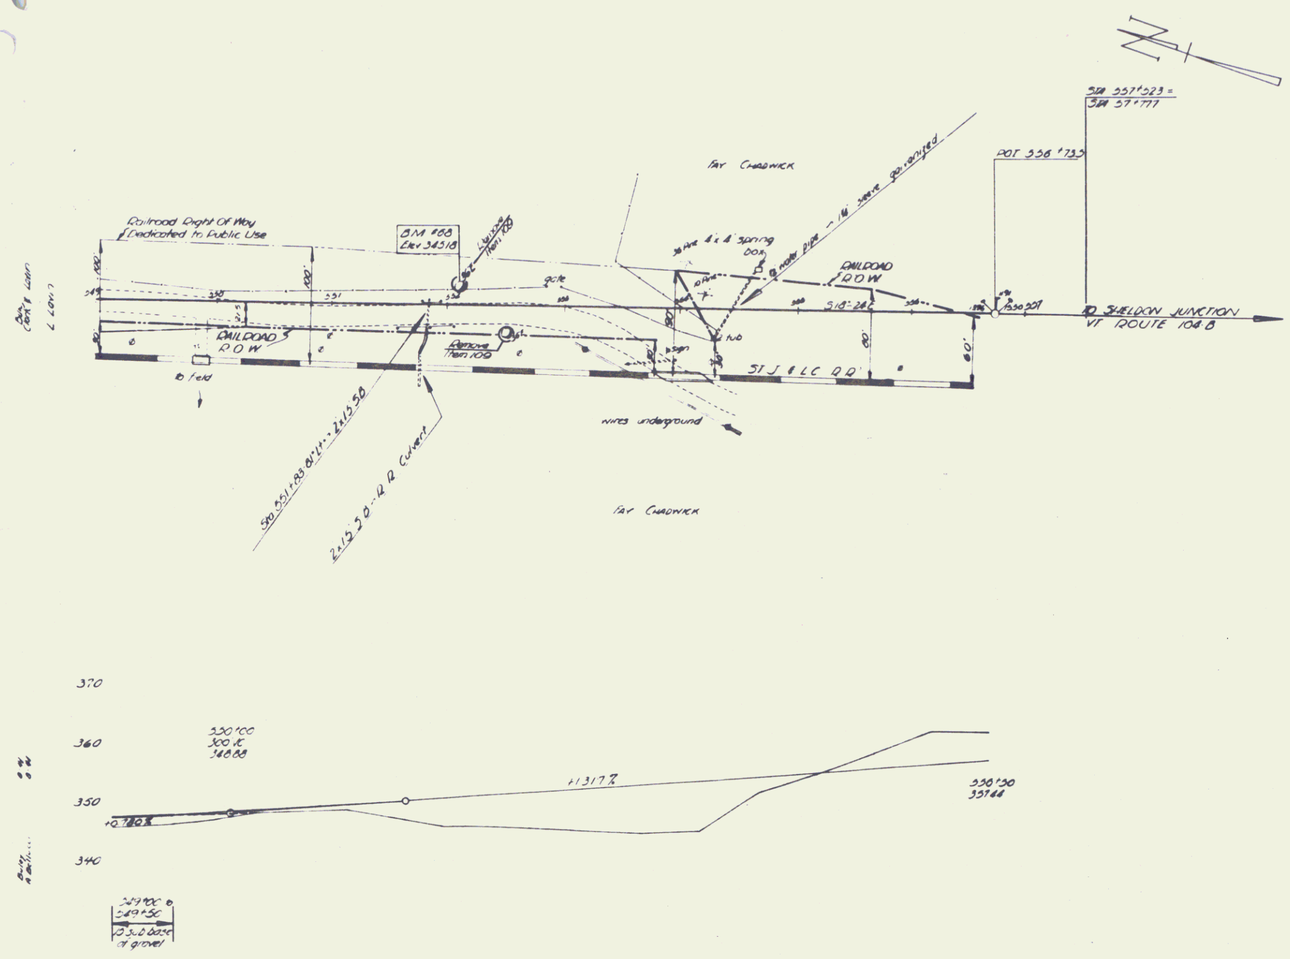
Railroad Right Of Way
Dedicated to Public Use
BM #68
Elev 345.18
Item 108
Fay Chadwick
RAILROAD
R.O.W
Item 108
to field
RAILROAD
R.O.W
to SHELDON JUNCTION
wires underground
Fay Chadwick
370
360
350
340
330+00
300 ft
340.88
+1.31 %
330+30
339.44
349+00
349+56
or gravel

SHEET 10

8