#44 ANNIE S. TOWLE
(A 0.25 ±) STA 664+98-666+12±
SLOPE RIGHTS - 665+00-665+81.2±
WDOE 8/30/56
RECORDED - WEST FAIRLEE - BK17MISC-PG167-4/19/57

Survey
PI 666+83.7
= 666+82.5
Δ 14°16'
D 7°
Rev. PI 663+03.3
666+82.5

B.M. #72
ELEV 743.31

CONSTRUCT
Sta. Pos.
663+83.60 RA
~~663+30 RA~~
669+00 Lt.
672+83 RA
673+70 Lt.
667+70 Rt.
670+94 Lt.

DRIVES

#46B HARRISON M. CHAMBERLIN
(A 0.21±) STA 669+50-673+45±
WDOE 8/25/56
RECORDED - WEST FAIRLEE - BK17MISC-PG153/154-4/19/57

PI 671+12.4
= 671+12.3

WALTER W & DELLA M. SMITH

669+24 - 673+56 Lt.
Three Cable Guard Rail with Steel Posts
Item 543

P.O.T. 678+00.0

TO W. FAIRLEE
VT. RTE. #113

Sta. 665+29 Lt.
Demolition and Removal of Building Item 386

#45 FRANCIS M. & ETHEL M. ASH
SLOPE RIGHTS - STA 665+81.2-668+20±
WDOE 6/29/56
RECORDED - WEST FAIRLEE - BK17MISC-PG171-4/19/57

#47 WALTER W. & DELLA M SMITH
SLOPE RIGHTS - STA 668+73; 672+00, 673+40; 674+50±
REMOVE BLDG. - STA 674+05±
WDOE 6/29/56
RECORDED - WEST FAIRLEE - BK17 MISC - PG159 - 4/19/57

Rev. Curve
Δ 12°21' Rt.
D 7°
R 819.0
T 88.6
L 176.4
E 4.0
Bank ½" per ft.

Rev. PC 665+94.7
Rev. PT 667+71.1
PC 669+82.7
PT 672+39.2

Δ 1°-16' Rt.
D 0°-30'
R 11,432.9
T 126.7
L 253.3
E 0.7
Bank No Banking

End Gravel Begin Surface
Sta. 673+70

674+00
END PROJECT S176(7)

#1 Non-Gov't Participation
668+20 Install sleeve for water pipe across roadway. Item 103-A. Sleeve to be furnished by property owner
Length 40'

#46A HARRISON M. CHAMBERLIN
(A 0.012±) STA 668+20-668+73±
WDOE 8/25/56
RECORDED - WEST FAIRLEE - BK17MISC.-PG-153/154-4/19/57

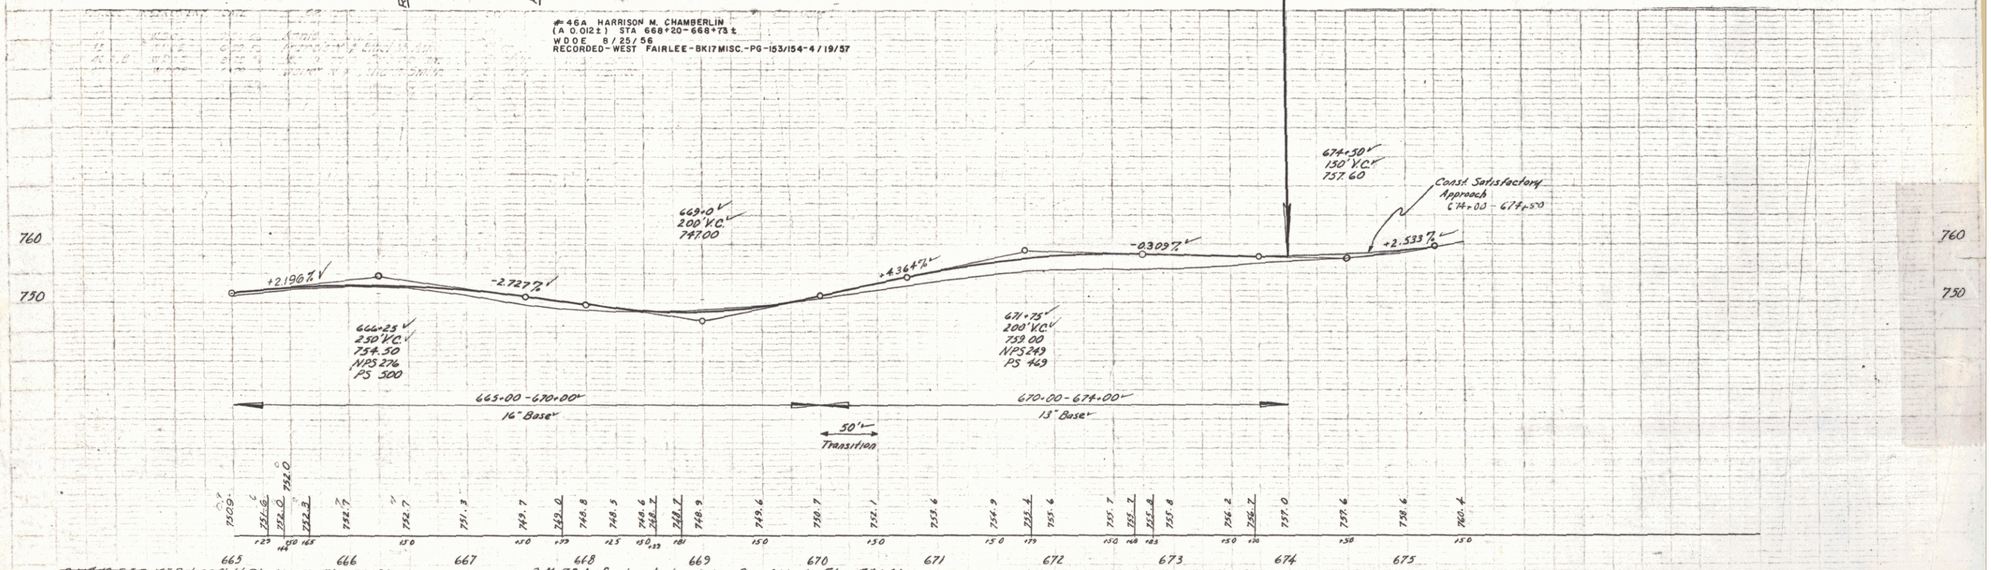

~~B.M. #72 Sta. 15" Bel. 22" H. Sta. 663+13 Elev. 743.31~~
B.M. 72A Spot on Large 30" Lin. Sta. 666+50 Elev. 754.41
B.M. 72B S.I. Tel. Pole #3 20' Rt. Sta. 674+25 Elev. 759.19

VERSHIRE - W. FAIRLEE
Project S. No. 176(7)
Sheet 22 of 22 Sheets
13