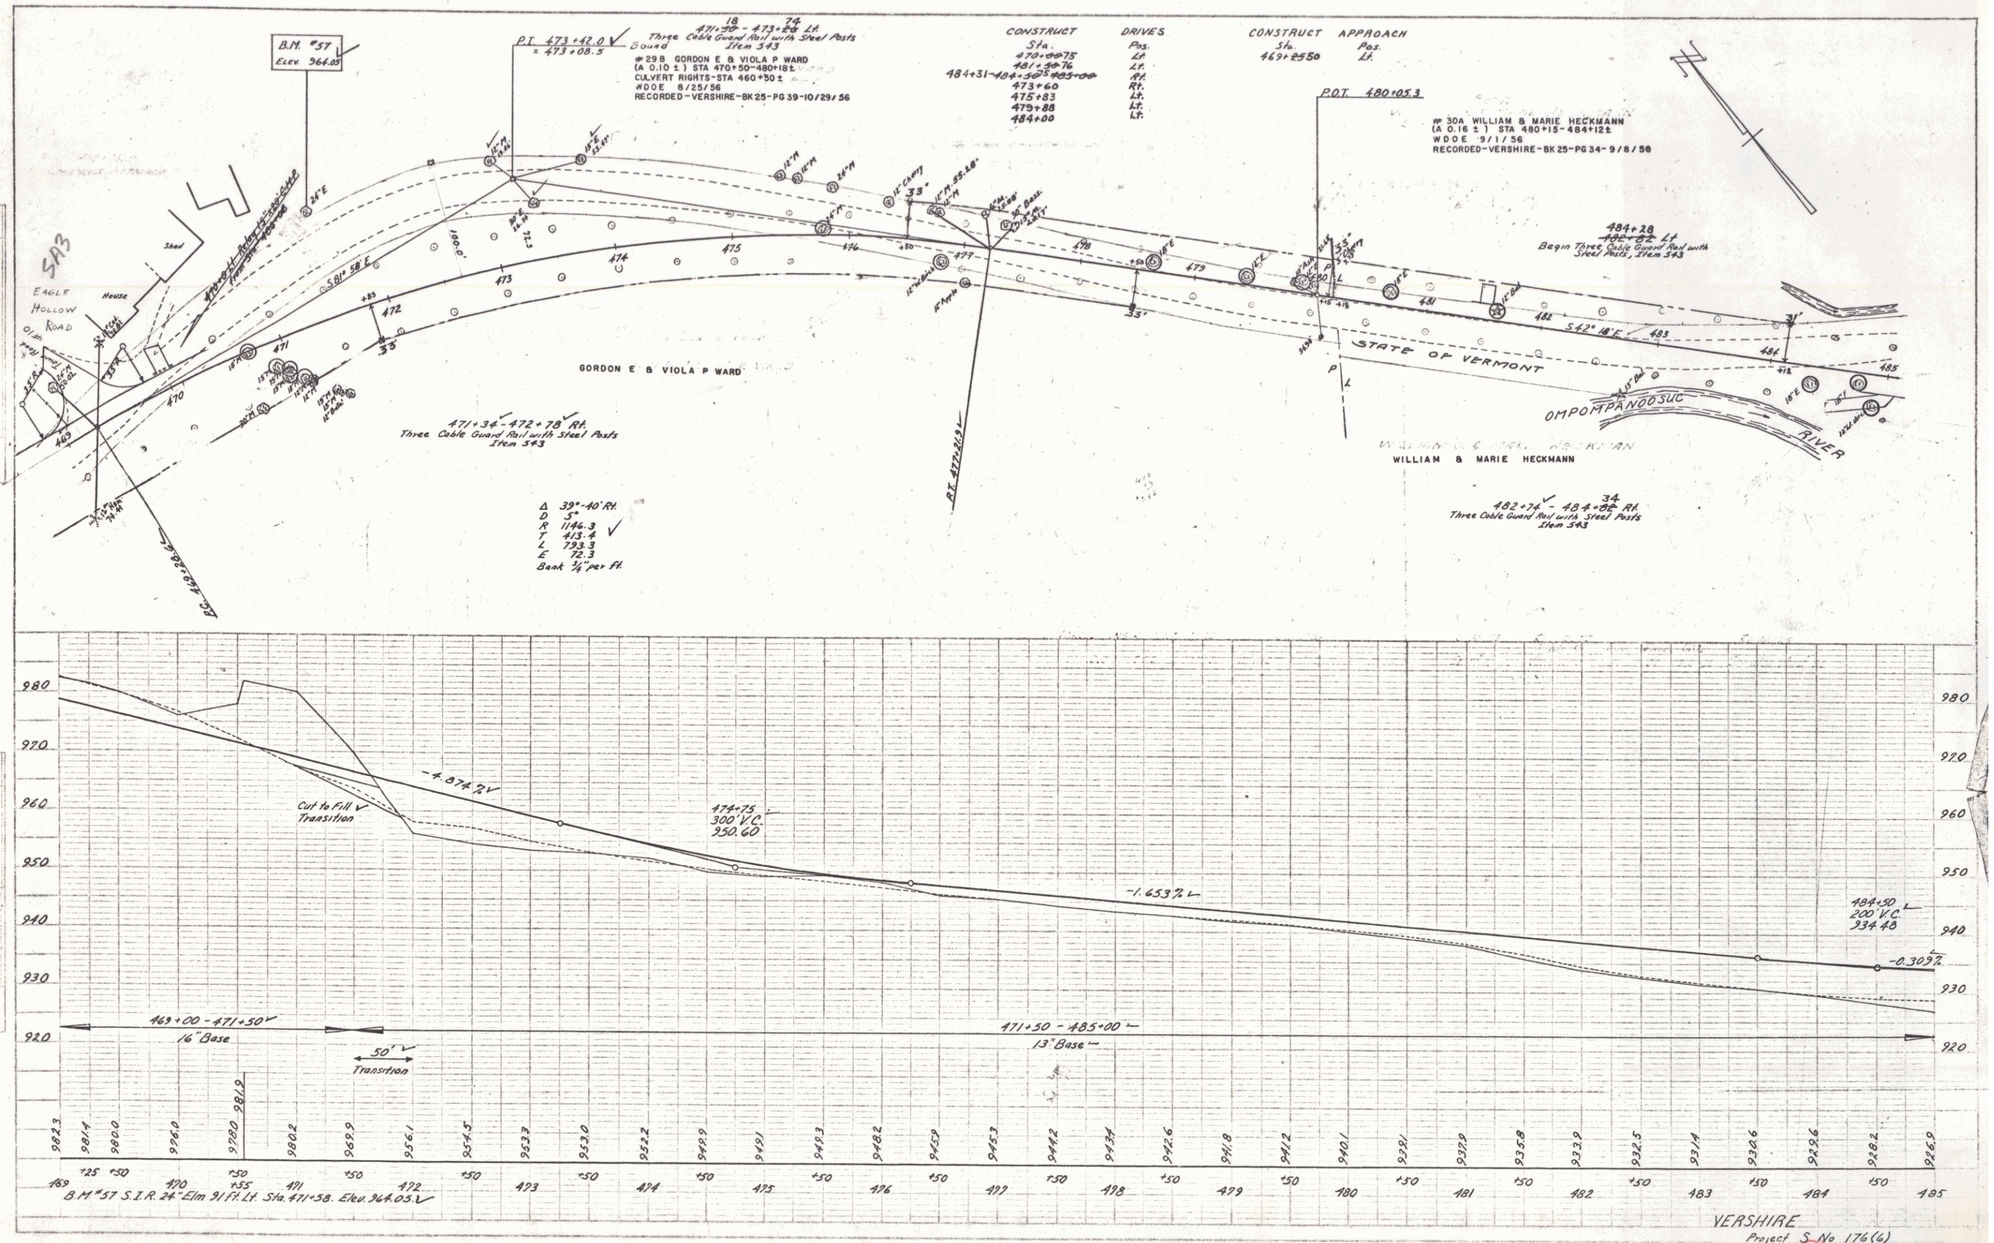

VERSHIRE

Project S No 176(6)
Sheet 28 of 87 Sheets

15