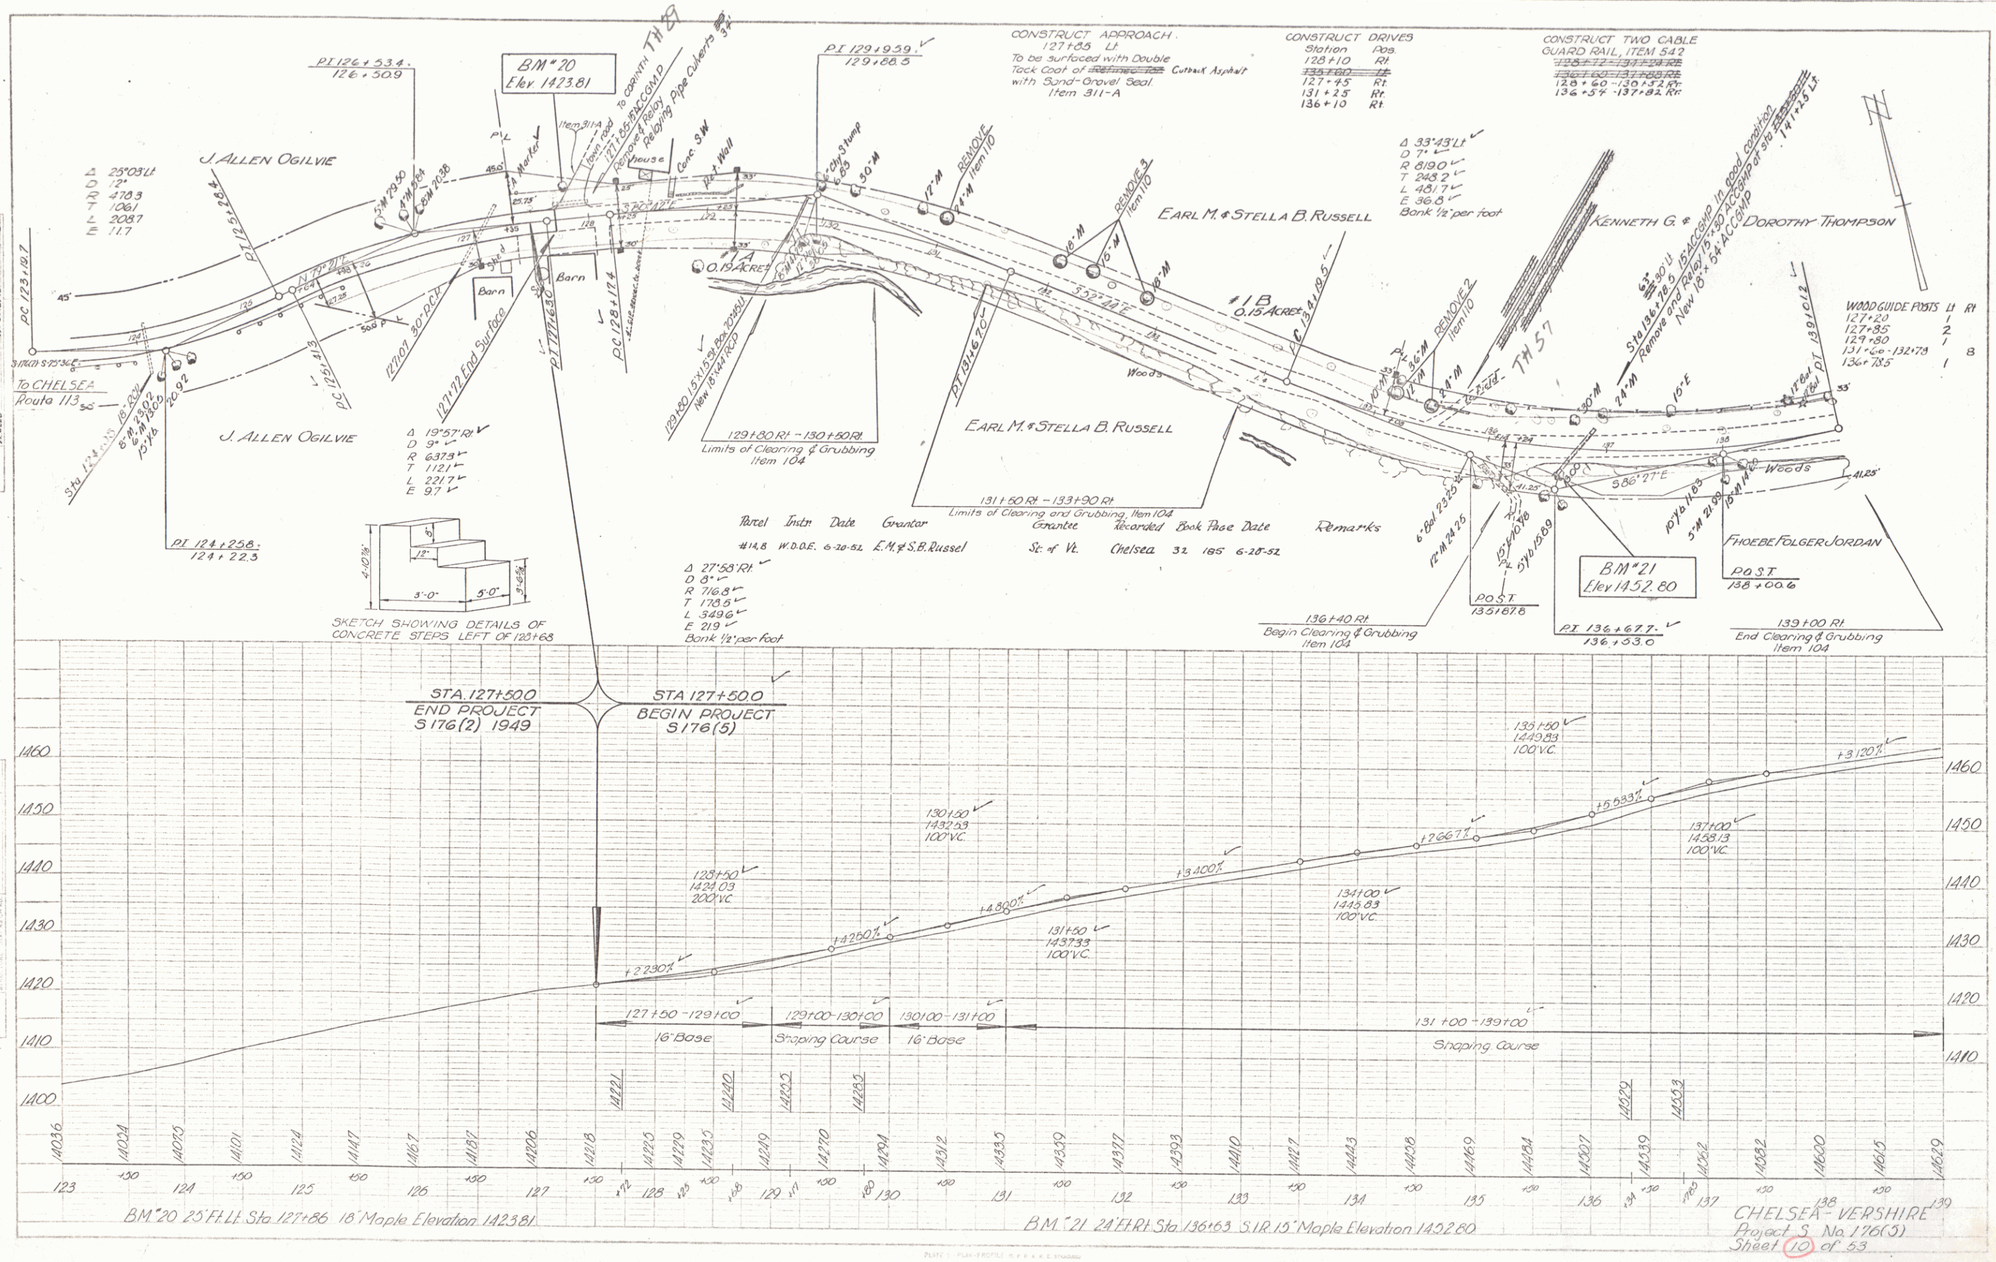
J. ALLEN OGILVIE
EARL M. & STELLA B. RUSSELL
KENNETH G. & DOROTHY THOMPSON
PHOEBE FOLGER JORDAN
To CHELSEA Route 113
To CORINTH TH 28
TH 57
B.M. #20 Elev. 1423.81
B.M. #21 Elev. 1452.80
CONSTRUCT APPROACH 127+85 Lt To be surfaced with Double Tack Coat of Cutback Asphalt with Sand-Gravel Seal Item 311-A
CONSTRUCT DRIVES
Station Pos.
128+10 Rt
127+95 Rt
131+25 Rt
136+10 Rt
CONSTRUCT TWO CABLE GUARD RAIL, ITEM 542
128+60 - 130+52 Rt
136+54 - 137+82 Rt
WOOD GUIDE POSTS Lt Rt
127+20 1
127+85 2
129+80 1
131+Co-132+78 8
136+78.5 1
Limits of Clearing & Grubbing Item 104
Begin Clearing & Grubbing Item 104
End Clearing & Grubbing Item 104
SKETCH SHOWING DETAILS OF CONCRETE STEPS LEFT OF 128+68
STA. 127+50.0 END PROJECT S176(2) 1949
STA 127+50.0 BEGIN PROJECT S176(5)
127+50 - 129+00 16" Base
129+00 - 130+00 Shaping Course
130+00 - 131+00 16" Base
131+00 - 139+00 Shaping Course
B.M. #20 25' Ft. Lt. Sta. 127+86 18" Maple Elevation 1423.81
B.M. #21 24' Ft. Rt. Sta. 136+63 S.I.R. 15" Maple Elevation 1452.80
CHELSEA - VERSHIRE
Project S No. 176(5)
Sheet 10 of 53