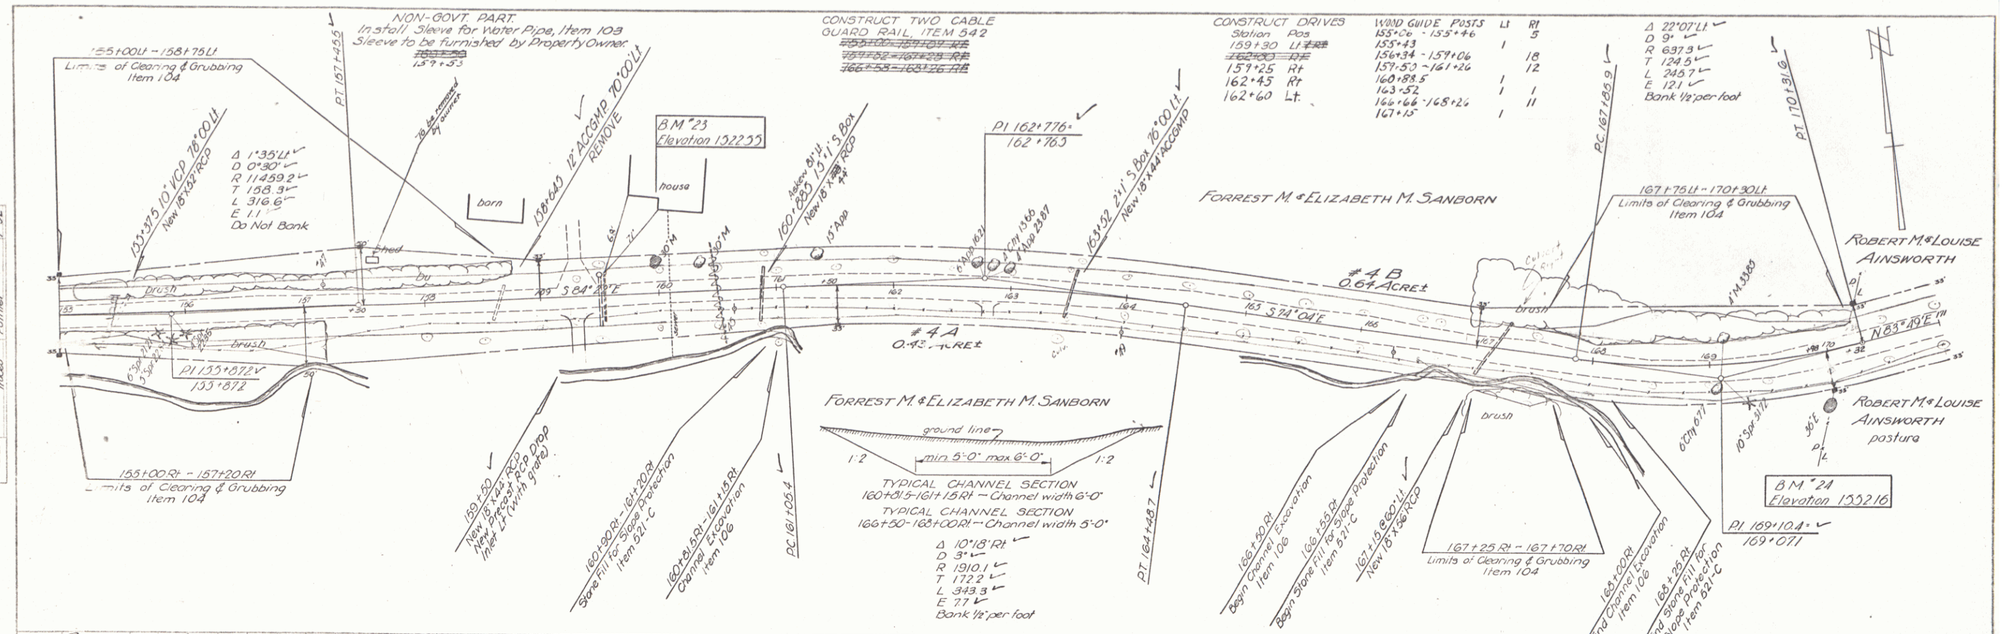

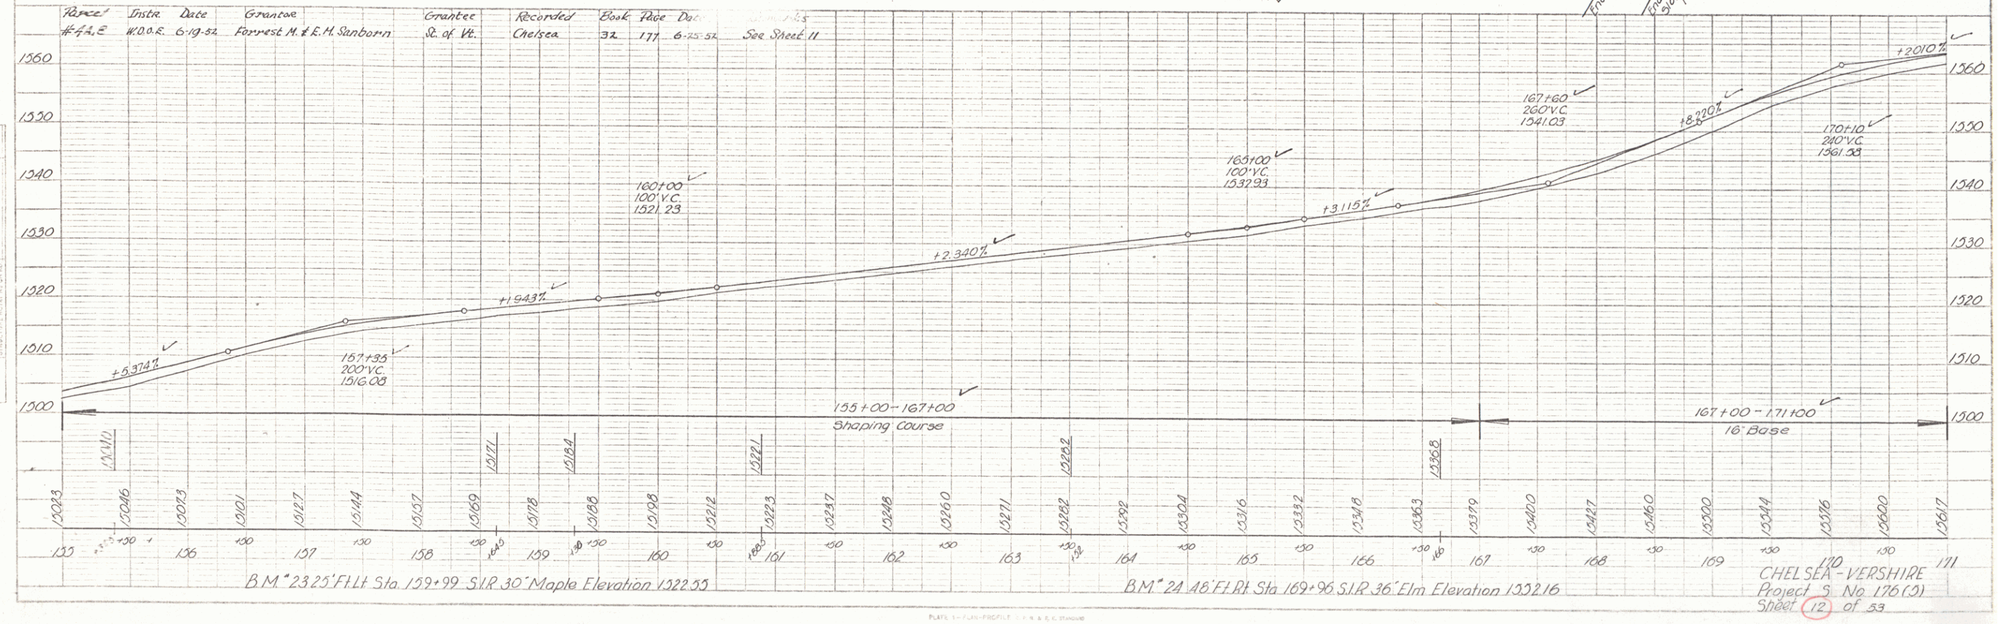

CHELSEA - VERSHIRE
Project S No. 176(3)
Sheet 12 of 53

4