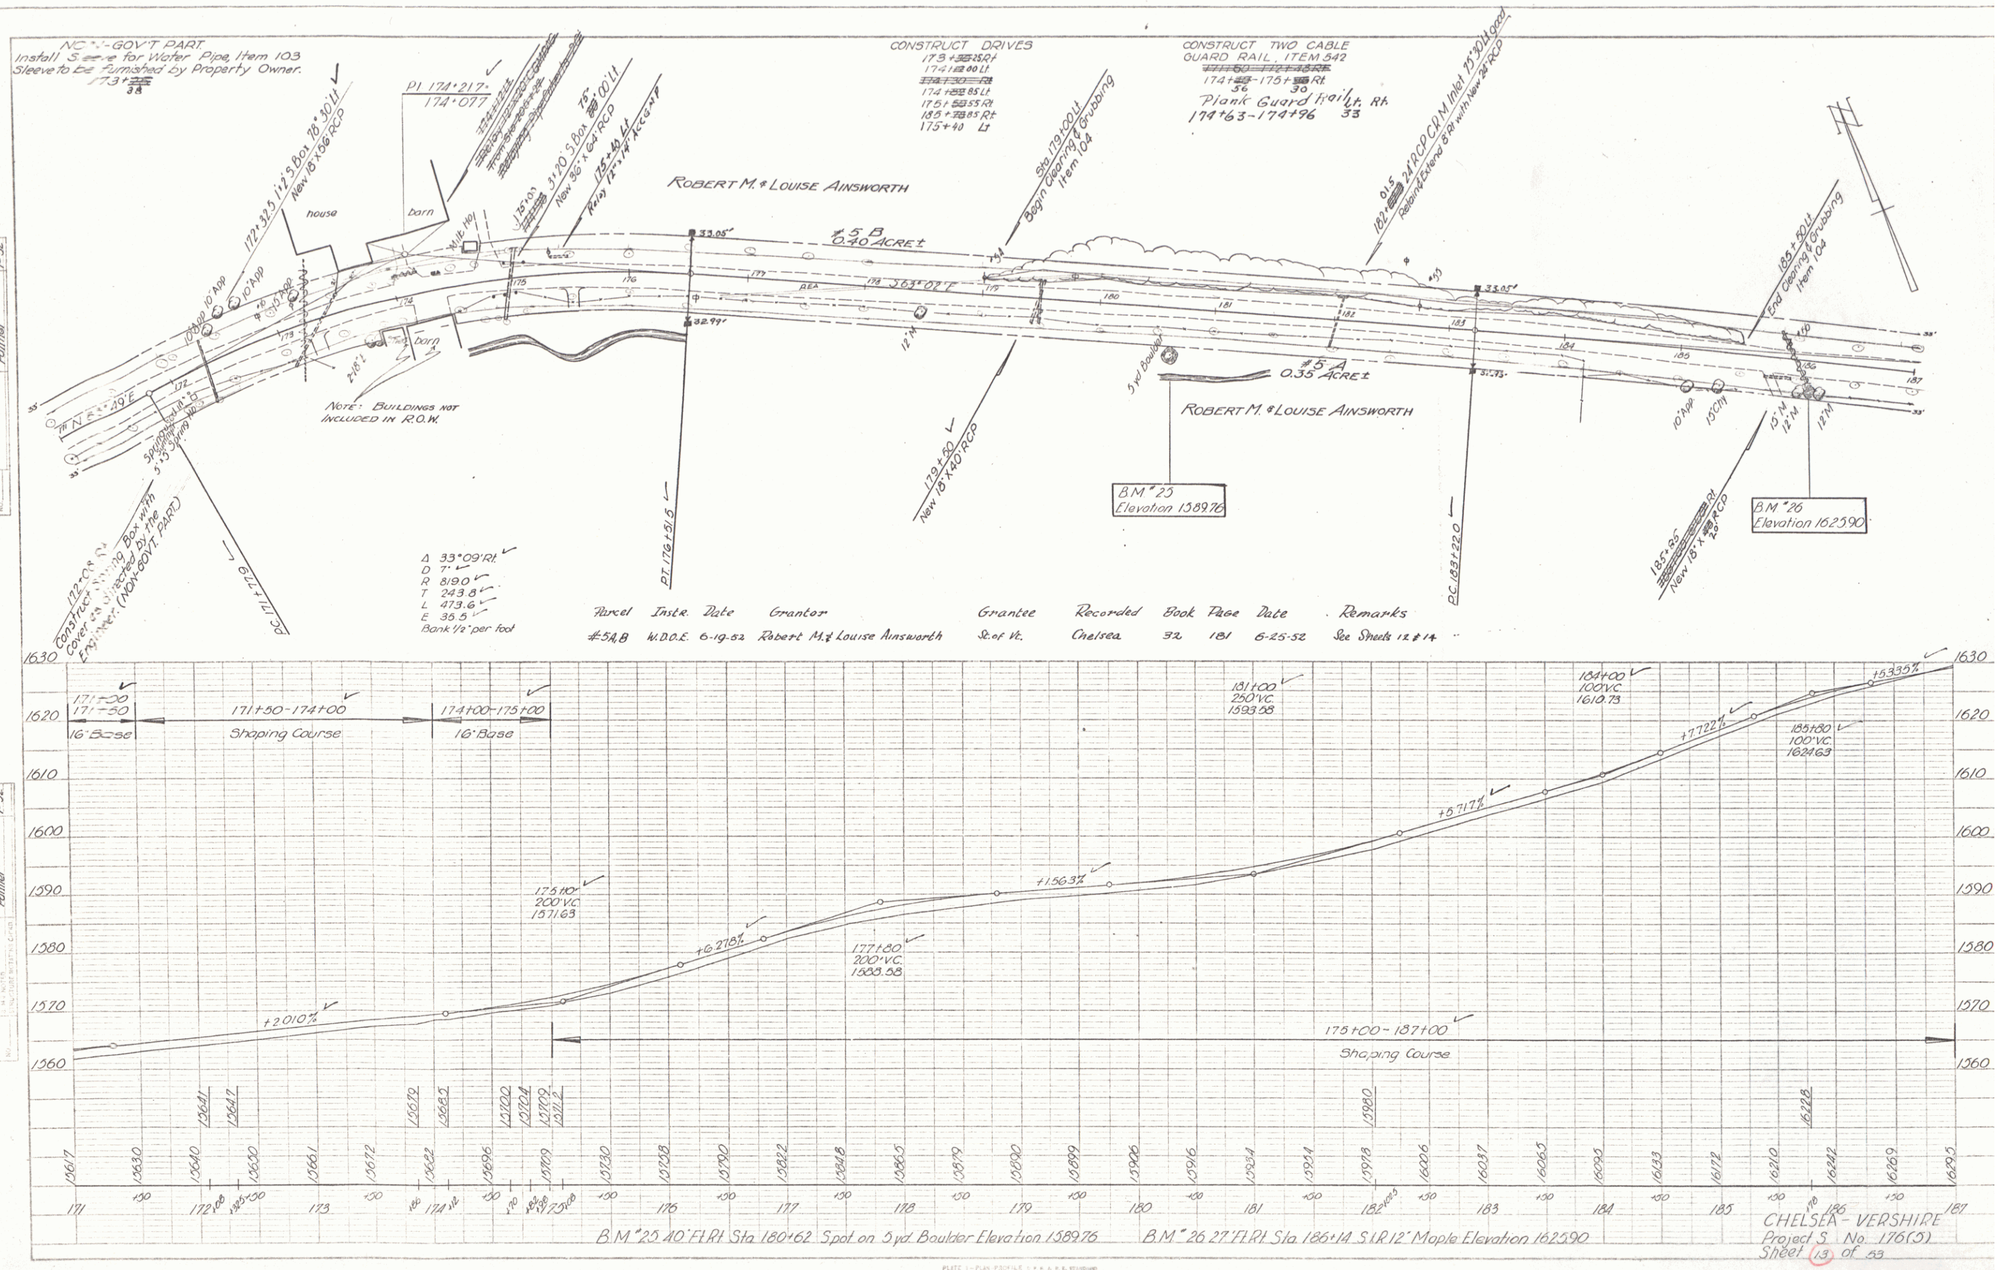
NON-GOV'T PART
Install Sleeve for Water Pipe, Item 103
Sleeve to be Furnished by Property Owner.
173+
38
PI 174+217
174+077
house
barn
barn
Well Hd
172+32.3 12"S Box 78°30' Lt
New 18"X36" RCP
New 36"X60" RCP
175+20.5 Box 75°00' Lt
New 18"X40" RCP
175+40 Lt
New 12"X14" ACCMP
CONSTRUCT DRIVES
173+50 Rt
174+00 Lt
174+30 Rt
174+85 Lt
175+55 Rt
175+85 Rt
175+40 Lt
ROBERT M. & LOUISE AINSWORTH
#5B
0.40 ACRE±
N 42°-39' E
Sta 179+00 Lt
Begin Clearing & Grubbing
Item 104
CONSTRUCT TWO CABLE
GUARD RAIL, ITEM 542
174+56-175+56 Rt
56 30
Plank Guard Rail Lt. Rt.
174+63-174+96 33
0.15
182+ 24" RCP C.R.M. Inlet 72°30' Lt
Add 24" Extend & Rt with New 24" RCP
185+70 Lt
End Clearing & Grubbing
Item 104
33.05'
32.99'
31.73'
12"M
5 yd Boulder
#5A
0.35 ACRE±
ROBERT M. & LOUISE AINSWORTH
10"App
15"CM
15"M
18"M
12"M
Note: Buildings not
Included in R.O.W.
Δ 33°09' Rt
D 7°
R 819.0
T 243.8
L 473.6
E 35.5
Bank 1/2" per foot
PT 176+51.5
179+80
New 18"X40" RCP
BM #25
Elevation 1589.76
PC 183+22.0
185+85
New 18"X 18° RCP
BM #26
Elevation 1625.90
PC 171+72.9
172+00 Construct Spring Box with
Cover as Directed by the
Engineer. (NON-GOV'T. PART)
Parcel Instr. Date Grantor Grantee Recorded Book Page Date Remarks
#5A,B W.D.D.E. 6-19-52 Robert M. & Louise Ainsworth St. of Vt. Chelsea 32 181 6-25-52 See Sheets 12 & 14
171+00
171+50
16' Base
171+50-174+00
Shaping Course
174+00-175+00
16' Base
+2.010%
175+00
200' V.C.
1571.63
+6.278%
177+80
200' V.C.
1588.58
+1.563%
181+00
250' V.C.
1593.08
+6.717%
184+00
100' V.C.
1610.73
+7.722%
185+80
100' V.C.
1621.63
+5.335%
175+00-187+00
Shaping Course
B.M. #25 40' Fl Rt Sta 180+62 Spot on 5 yd. Boulder Elevation 1589.76
B.M. #26 27' Fl Rt Sta 186+14 S.I.R. 12" Maple Elevation 1625.90
CHELSEA - VERSHIRE
Project S No. 176(5)
Sheet 13 of 53